## **ADDENDUM No. 1**

## RFP No. 24-20

## **Huron River Drive Culvert Replacement**

Due: May 7, 2024 at 11:00 AM (local time)

The information contained herein shall take precedence over the original documents and all previous addenda (if any), and is appended thereto. **This Addendum includes 5 pages with 9 plan sheets, for a total 14 pages.** 

The Proposer is to acknowledge **receipt of this Addendum No. 1 by signing and submitting attachment B,** including all attachments in its Proposal by so indicating in the proposal that the addendum has been received. Proposals submitted without acknowledgement of receipt of this addendum may be considered non-conforming.

The following forms provided within the RFP Document should be included in submitted proposal:

- Attachment D Prevailing Wage Declaration of Compliance
- Attachment E Living Wage Declaration of Compliance
- Attachment G Vendor Conflict of Interest Disclosure Form
- Attachment H Non-Discrimination Declaration of Compliance

<u>Proposals that fail to provide these completed forms listed above upon proposal opening may be rejected as non-responsive and may not be considered for award.</u>

### I. CORRECTIONS/ADDITIONS/DELETIONS

Changes to the RFP documents which are outlined below are referenced to a page or Section in which they appear conspicuously. Offerors are to take note in its review of the documents and include these changes as they may affect work or details in other areas not specifically referenced here. Changes in text documents are highlighted in yellow.

Section/Page(s)	Change
Replace Plan Sheets 1-9	Added note about pipe insulation incidental to WM installation; Change note about earth grading balancing
Replace Bid Form pg 15-17	Revised Qty, Various Sizes of Tree Removal, Silt Fence, Machine Grading, Turf Establishment

## **II. QUESTIONS AND ANSWERS**

The City received the following questions:

- Q1: What is the Engineers Estimate for the Project for bonding purposes?
- A1: The project is estimated at \$575,000.
- Q2: Are we able to use the Barton Dam parking lot as a staging area?
- A2: Yes there is an active Border to Borders trail improvement project in this area right now and a material laydown area within the parking lot will be set aside for this project.
- Q3: Temporary Line Stops, will the same fittings be accepted under the new Standard Specification as has been in prior years, have their been any changes?
- A3: No the same products for line stops used before are accepted under the New Standard.
- Q4: Can the Contractors obtain a digital copy of the Bid Form?
- A4: Yes please email Nicholas Bayley, <a href="mailto:nbayley@a2gov.org">nbayley@a2gov.org</a> to request a excel format copy.

# E. Schedule of Pricing/Cost – 20 Points

Company:
Project: Huron River Dr Culvert Replacement
File #: 2023-008

RFP#: 24-20

ITEM	M DESCRIPTION		UNIT ESTI		UNIT PRICE		TOTAL PRICE
	General						
01000.00	General Conditions, Max. \$37,000	LS	1	\$		\$	
01001.00	Project Supervision, Max. \$ 10,000	LS	1	\$		\$	
01020.70	DS_Erosion Control, Check Dam, Permanent	Ft	60	\$		\$	
01022.00	Erosion Control, Silt Fence	Ft	60	\$		\$	
01030.00	Tree Protection Fence	Ft	250	\$		\$	
01040.00	Minor Traffic Control, Max. \$ 5,000	LS	1	\$		\$	
01041.00	Traffic Regulator Control	LS	1	\$		\$	
01050.00	Sign, Type B, Temp, Prismatic, Furn & Oper	Sft	217	\$		\$	
01051.00	Sign, Type B, Temp, Prismatic, Special, Furn & Oper	Sft	98	\$		\$	
01070.00	Sign, Portable, Changeable Message, Furn & Oper	Ea	3	<u></u>			
01081.00	Channelizer Cone, High Intensity, 42 In., Furn & Oper	Ea	25	\$		\$	
01092.00	Barricade, Type III, High Intensity, Double Sided, Lighted, Furn & Oper	Ea	8	\$		\$	
	Removals						
02000.01	Tree, Rem, 6 In 12 In.	Ea	17	\$		\$	
02000.02	Tree, Rem, 13 In 19 In.	Ea	6	\$		\$	
02000.03	Tree, Rem, 20 In 29 In.	Ea	1	\$		\$	
02000.04	Tree, Rem, 30 In 39 In.	Ea	1	\$		\$	
02010.00	Stump, Rem	Ea	5	\$		\$	
02020.00	HMA, Any Thickness, Rem	Syd	290	\$		\$	
02023.71	DS_Lap Joint	Ft	177	\$		\$	
03001.70	DS_Machine Grading	Syd	1785	\$		\$	
03030.01	Exploratory Excavation, SD-TD-1, (0-10' Deep)	Ea	2	\$		\$	
03040.00	Earth Excavation	Cyd	530	\$		\$	

ITEM	DESCRIPTION	UNIT	ESTI	UNIT PRICE	TOTAL PRICE
	Sanitary Sewer				
04000.01	8 In., SDR 26 PVC Sanitary Sewer, SD-TD-2	Ft	5	\$ \$	
04000.04	15 In., SDR 26 PVC Sanitary Sewer, SD-TD-2	Ft	25	\$ \$	
04020.00	Pipe Undercut & Backfill, Sanitary	Cyd	5	\$	
04080.01	Sanitary Sewer Pipe, 8 In. Dia., Rem	Ft	5	\$ \$	
04080.04	Sanitary Sewer Pipe, 15 In. Dia., Rem	Ft	25	\$ \$	
04111.70	DS_Sanitary Sewer, Temp Bypass Pumping, Operation Setups and Breakdowns	LS	1	\$ \$	
04111.71	DS_Sanitary Sewer, Temp Bypass Pumping, Operation and Monitoring	LS	1	\$ \$	
	Storm and Drainage				
06000.01	12 In., CL IV RCP Storm Sewer, SD-TD-1	Ft	64	\$ \$	
06000.10	24 In.x38 In., CL IV RCP Storm Sewer, SD-TD-1	Ft	176	\$ \$	
06020.00	Pipe Undercut & Backfill, Storm	Cyd	5	\$ \$	
06041.00	Riprap, Plain	Syd	255	\$ \$	
06110.03	Storm Sewer Pipe, 12 In. Dia., Abandon	Ft	74	\$ \$	
06120.07	Storm Sewer Pipe, 24 In. Dia., Rem	Ft	65	\$ \$	
06211.70	DS_Storm Sewer, Temp Bypass Pumping, Operation Setups and Breakdowns	LS	1	\$ \$	
06211.71	DS_Storm Sewer, Temp Bypass Pumping, Operation Setups and Breakdowns	LS	1	\$ \$	
06211.72	DS_Scour Pool	Ea	2	\$ \$	
	Water Mains - Contingency				
07000.03	8 In., PC 350 DIP w/polywrap, SD-TD-1	Ft	8	\$ \$	
07000.05	12 In., PC 350 DIP w/polywrap, SD-TD-1	Ft	44	\$ \$	
07013.02	12 In. 45° DIP Bend	Ea	4	\$ \$	
07020.09	12 In. X 8 In. DIP Reducer	Ea	2	\$ \$	
07060.74	DS_Gate Valve in Well, 12 In.	Ea	1	\$ \$	
07110.01	Sacrificial Anode, 17-pound	Ea	2	\$ \$	
07130.01	Temporary Water Main Line Stop, 8 In. or less	Ea	2	\$ \$	
07131.00	Temporary Water Main Line Stop, Additional Rental Day	Ea	4	\$ \$	
07150.03	Water Main Pipe, 8 In. Dia., Rem	Ft	56	\$ \$	

ITEM	DESCRIPTION	UNIT	ESTI		UNIT PRICE	TOTAL PRICE
	Streets, Driveways, & Sidewalks					
08010.03	Aggregate Base, 8 In., 21AA, CIP	Syd	328	\$_	\$	
08020.01	Aggregate Surface Course, 8 In., 23A, CIP	Syd	63	\$_	\$	
08041.01	Aggregate Shoulder, Cl II, 23A	Ton	12	\$_	\$	
08060.00	Hand Patching	Ton	12	\$_	\$	
08070.15	HMA, 4EML	Ton	53	\$_	\$	
08070.19	HMA, 5EML	Ton	31	\$_	\$	
08210.01	Pavt Mrkg, Sprayable Thermopl, 4 In., White	Ft	224	\$_	\$	
08210.02	Pavt Mrkg, Sprayable Thermopl, 4 In., Yellow	Ft	250	\$_	\$	
	Landscaping					
10031.00	Fence, Salvage and Re-Erect	Ft	10	\$_	\$	
10060.70	DS_Turf Restoration, Wetland Edge Seed Mix	Syd	1010	\$_	\$	
10060.71	DS_Turf Restoration, MDOT THV Seed Mix	Syd	105	\$_	\$	
10090.00	Mulch Blanket	Syd	1115	\$_	\$	
11000.70	DS_Concrete Cradle	Cyd	5	\$_	\$	
11000.71	DS_Utility Bridge	Ea	1	\$_	\$	
11000.72	DS_Clay Bar	Cyd	10	\$_	\$	
11000.73	DS_Bar Grate	Ea	2	\$_	\$	

Total Proposed Cost \$	
------------------------	--



# CITY OF ANN ARBOR ENGINEERING

# HURON RIVER DRIVE CULVERT REPLACEMENT


BID No. RFP No. 24-20, FILE No. 2023-008

**VICINITY MAP** 

	SHEET LIST TABLE						
SHEET NUMBER	SHEET TITLE						
1	COVER SHEET						
2	LEGEND						
3-5	DETAILS AND SECTIONS						
6	MAINTENANCE OF TRAFFIC AND DETOUR PLAN						
7	REMOVALS						
8	CONSTRUCTION						
9	WATER MAIN RELOCATION						

PUBLIC ACT 174 OF 2013, THE CONTRACTOR SHALL CALL 811 OR

STANDARD SPECIFICATIONS, IT'S DETAILS, WHICH ARE INCLUDED BY REFERENCE, AND THIS PROJECT'S CONTRACT DOCUMENTS. THE OMISSION OF ANY CURRENT STANDARD DETAIL DOES NOT RELIEVE THE CONTRACTOR

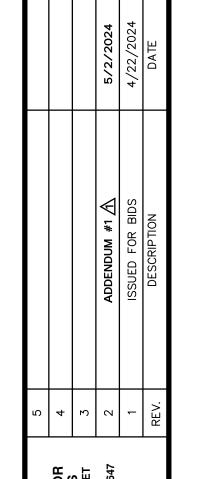



P.O.E W. HURON RIVER DE

4/ 22 / 2024

PREPARED UNDER THE SUPERVISION OF

## **CONSTRUCTION NOTES:**

- 1. DRIVEWAYS AND ENTRANCES TO BUILDINGS, REAL PROPERTY, AND THE LIKE SHALL NOT BE BLOCKED EXCEPT FOR SHORT DURATIONS AND ONLY WHEN APPROVED BY THE ENGINEER. VEHICULAR AND PEDESTRIAN ACCESS SHALL BE MAINTAINED AT ALL TIMES. IT SHALL BE THE CONTRACTOR'S RESPONSIBILITY TO COORDINATE ALL NECESSARY DRIVEWAY CLOSURES WITH THE PROPERTY OWNER(S) AND RESIDENT(S) IN THE AREAS OF CONSTRUCTION.
- 2. THE LOCATION AND DEPTH OF ALL EXISTING UTILITIES AND SERVICE LEADS ARE TO BE FIELD VERIFIED BY THE CONTRACTOR PRIOR TO CONSTRUCTION.
- 3. LOCATION AND DEPTH OF UTILITIES AS DEPICTED ON THE PLANS IS APPROXIMATE AND SHOWN ACCORDING TO THE BEST INFORMATION AVAILABLE. IT IS THE CONTRACTOR'S RESPONSIBILITY TO EXCAVATE AHEAD AND ADJUST DEPTH OF CONFLICT UTILITIES ACCORDINGLY. ANY DAMAGE TO UTILITIES IS THE CONTRACTOR'S RESPONSIBILITY TO AVOID AND/OR REPAIR AS NECESSARY.
- 4. THE CONTRACTOR IS REQUIRED TO SUBMIT ANY AND ALL NECESSARY REQUESTS TO MISS DIG FOR THE LOCATING AND MARKING OF ANY AND ALL UTILITIES LOCATED WITHIN THE PROJECT. THE CONTRACTOR SHALL NOT BEGIN WORK UNTIL ALL UTILITIES WITHIN THE PROJECT LIMITS HAVE BEEN LOCATED AND MARKED BY MISS DIG, AND RECEIVED CONFIRMATION FROM MISS DIG THAT ALL KNOWN UTILITIES WITHIN THE PROJECT LIMITS HAVE BEEN LOCATED AND MARKED.
- 5. THE CONTRACTOR IS TO TAKE SPECIAL CARE TO PROTECT EXISTING UTILITIES AND BE RESPONSIBLE FOR MAINTAINING UNINTERRUPTED SERVICE.
- 6. DURING NON-WORKING HOURS NO TRENCH SHALL REMAIN OPEN; ANY OPEN TRENCH SHALL BE PROPERLY SECURED WITH PROTECTIVE FENCING. THIS WORK SHALL BE INCLUDED IN THE ITEM OF WORK "GENERAL CONDITIONS, MAX \$ \_."
- 7. POSTAL DELIVERY AND REFUSE PICKUP SERVICE SHALL BE MAINTAINED AT ALL TIMES BY THE CONTRACTOR.
- 8. WHERE STREET CURBS ARE UNDERMINED DUE TO CONSTRUCTION ACTIVITIES, THEY SHALL BE REMOVED AND REPLACED AS DIRECTED BY THE ENGINEER.
- 9. THE CONTRACTOR SHALL BE RESPONSIBLE FOR THE CONTINUOUS MAINTENANCE OF THE TEMPORARY ROAD SURFACE AND SOIL EROSION CONTROL MEASURES WITHIN THE CONSTRUCTION AREA UNTIL THE FULL COMPLETION OF THE PROJECT. THIS WORK SHALL BE INCLUDED IN THE ITEM OF WORK "GENERAL CONDITIONS, MAX \$\_\_\_\_LS".
- 10. ALL CURB, SIDEWALK, DRIVEWAY APPROACH REMOVALS SHALL BE APPROVED BY ENGINEER BEFORE THE WORK IS DONE.
- 11. SAWED SEWER PIPE CONNECTIONS SHALL BE COUPLED WITH A FERNCO FLEXIBLE COUPLING AND A STAINLESS STEEL SHEAR RING.
- 12. THE LOCATION OF MATERIAL STOCK PILES AND ON-SITE STAGING AREAS TO BE APPROVED BY THE ENGINEER.
- 13. FOR MAINLINE PAVING, THE WIDTH OF THE MAT FOR EACH PASS OF THE PAVER SHALL BE NOT LESS THAN 10.5' OR GREATER THAN 15', AS DIRECTED BY THE ENGINEER. THE ENGINEER WILL DIRECT THE LAYOUT OF THE LONGITUDINAL JOINTS DURING CONSTRUCTION.
- 14. WHERE SEWER PIPES OF DIFFERENT SIZES OR MATERIALS ARE JOINED, FERNCO FLEXIBLE COUPLINGS WITH STAINLESS STEEL SHEAR RINGS SHALL BE USED. THE CONTRACTOR'S PURCHASE PRICE FOR THESE DEVICES, INCLUDING SHIPPING, SHALL BE PAID AS AN EXTRA. PRIOR TO PAYMENT FOR THIS ITEM, THE CONTRACTOR SHALL SUBMIT RECEIPTS FOR THE ENGINEER'S REVIEW AND APPROVAL. ALL OTHER COSTS ASSOCIATED WITH THE INSTALLATION OF THESE DEVICES SHALL BE INCLUDED IN THE PAYMENT FOR THE SEWER.
- 15. WHERE SEWER AND WATER MAIN ARE TO BE REMOVED & REPLACED OR ADDED, ALL PIPE SHALL BE INSTALLED USING ON PLANS. BACKFILL FOR SEWER AND WATER CONSTRUCTION SHALL BE MDOT CLASS II GRANULAR MATERIAL.
- 16. EXISTING STREET NAME, GUIDE, REGULATORY SIGNS, AND MAILBOXES WHICH CONFLICT WITH THE PROPOSED CONSTRUCTION SHALL BE REMOVED PRIOR TO CONSTRUCTION, STORED IN A MANNER WHICH WILL PREVENT DAMAGE, AND RE-SET IN LOCATIONS AS DIRECTED BY THE ENGINEER. THIS WORK WILL NOT BE PAID FOR SEPARATELY, BUT SHALL BE INCLUDED IN "GENERAL CONDITIONS, MAX \$\_\_\_\_-LS".
- 17. ALL DUCTILE IRON PIPE AND FITTINGS SHALL BE POLYETHYLENE WRAPPED PER ANSI/AWWA C105/A21.5.
- 18. MEGALUG MECHANICAL JOINT RESTRAINTS BY EBAA IRON, INC AND CAR-BLUE T-HEAD BOLTS AND NUTS BY BIRMINGHAM FASTENER SHALL BE USED AT ALL MECHANICAL WATER MAIN JOINTS OUT HYDRANTS.
- 19. ALL PLUGS, CAPS, TEES, HYDRANTS, AND HORIZONTAL BENDS SHALL BE PROVIDED WITH 3500 PSI CONCRETE THRUST BLOCKS IN ACCORDANCE WITH SD-W-2, UNLESS OTHERWISE INDICATED (ART 10 SEC II.K.5).
- 20. THE CONTRACTOR SHALL CONSTRUCT, FLUSH, AND BACTERIOLOGICALLY TEST THE WATER MAIN PER SECTION II.L OF ARTICLE 10 OF THE ANN ARBOR 2024 STANDARD SPECIFICATIONS AND AS APPROVED BY THE ENGINEER. ALL CHLORINATED WATER SHALL BE DISCHARGED DIRECTED INTO AN APPROVED SANITARY SEWER. THE CONTRACTOR SHALL SUPPLY ALL NECESSARY HOSES, FITTINGS AND THE LIKE TO
- 22. WHERE SEWER AND WATER MAIN ARE TO BE REMOVED & REPLACED OR ADDED, ALL PIPE SHALL BE INSTALLED USING TRENCH DETAIL DETAILED IN THE SPECIFICATIONS OR SHOWN ON PLANS. BACKFILL FOR SEWER AND WATER CONSTRUCTION SHALL BE MDOT GRANULAR MATERIAL, CLASS II, MODIFIED.
- 21. ALL FITTINGS, HYDRANTS, VALVES AND CASTINGS REMOVED DURING CONSTRUCTION ARE THE PROPERTY OF THE CITY OF ANN ARBOR. THE CONTRACTOR SHALL COORDINATE WITH AND DELIVER SUCH APPURTENANCES TO CITY OF ANN ARBOR PUBLIC WORKS FACILITY AT THE W.R. WHEELER SERVICE CENTER LOCATED AT 4251 STONE SCHOOL ROAD, OR TO ANOTHER LOCATION STIPULATED BY THE CITY. ALL COSTS ASSOCIATED WITH THE DELIVERY OF SUCH APPURTENANCES TO THE CITY SHALL BE CONSIDERED INCIDENTAL TO OTHER PAY ITEMS AND WILL NOT BE PAID FOR SEPARATELY.

TOTAL AREA OF PROPOSED DISTURBANCE = 0.43 AC

ON SITE SOILS PER USDA SOIL SURVERY (AS OF 3/13/2024): Sb - SEBEWA LOAM, DISINTEGRATION MORAINE - 0% TO 2% SLOPES

# PERMITS REQUIRED TO BE OBTAINED BY THE CONTRACTOR DDIOD TO THE REGINNING OF CONSTRUCTION

**EXISTING LEGEND** 

EX = EXISTING

Ø UTILITY POLE

+ BENCH MARK

A TRAVERSE POINT

POST

♭ SIGN

O SANITARY MANHOLE

PRIOR TO THE BEGINNING OF CONSTRUCTION.								
PERMIT	ISSUING AUTHORITY							
LANE CLOSURE PERMIT*	CITY OF ANN ARBOR ENGINEERING							
GRADING/SOIL EROSION & SEDIMENTATION CONTROL PERMIT*	CITY OF ANN ARBOR CUSTOMER SERVICE							
RIGHT-OF-WAY PERMIT*	CITY OF ANN ARBOR CUSTOMER SERVICE							
* NO COST TO CONTRACTOR								

CONTACT INFORMATION					
PUBLIC UTILITIES	OWNER	CONTACT			
WATER					
SANITARY					
STORM	CITY OF ANN ARBOR PUBLIC WORKS W.R. WHEELER SERVICE CENTER	(734) 794–6350			
FORESTRY	4251 STONE SCHOOL ROAD ANN ARBOR, MI 48108				
SIGNS SIGNALS STREET LIGHTS		MARK MORENO (734) 794-6361			
PRIVATE UTILITIES	OWNER	CONTACT			
ELECTRIC	DTE ENERGY WESTERN WAYNE SERVICE CENTER 8001 HAGGERTY ROAD	ANTHONY IGNASIAK (734) 397-4447			

# **HURON RIVER DRIVE CONTROL POINTS**

BELLEVILLE, MI 48111

	BENCHMARKS									
BM#	ELEV. NORTHING EASTING DESCRIPTION									
300	801.12	295359.08	13288217.23	FOUND GEAR SPIKE IN EAST FACE OF 12" TREE EAST SIDE HURON RIVER DR. SOUTH OF PARK INTRANCE						

TRAVERSE POINTS							
TP# ELEV. NORTHING EASTING							
3000	797.24	295433.633	13288164.90				
3002	796.25	295441.72	13288136.19				
3003	797.66	295586.14	13288107.75				

HORIZONTAL DATUM: NAD83 SPC MICHIGAN SOUTH ZONE 2113 VERTICAL DATUM: NAVD88


# PROPOSED LEGEND PROP = PROPOSED ------ WATER MAIN STORM CULVERT DRAIN ARROW ———— SANITARY SEWER → SIGN SANITARY SEWER TRAFFIC FLOW ARROW ----- ELECTRICAL OVER HEAD BOUNDARY —//——//— FENCE ----:·----:·---- GRAVEL ----- -- CENTERLINE/CROWN OF ROAD SILT FENCE — — — — 800 — — — — CONTOUR MAJOR PROTECTIVE FENCE — — — — 799 — — — — CONTOUR MINOR ----- EDGE OF WATER — **799** — CONTOUR MINOR ---//----//----FENCE --- --- WATER EASMENT ----:·----:·----:-----: GRA VEL --- -- STORM EASEMENT — — — — SANITARY EASEMENT ----- \|\|\/ ------ \|\/ ----- \|WETLAND R.O.W. LIMITS OF CONSTRUCTION LIMIT OF GRADING TREE (DECIDUOUS) PAVEMENT REMOVAL CLEARING AND GRUBBING TREE (CONIFEROUS) RIPRAP STONE CONCRETE SHRUB (DECIDUOUS) HMA PAVEMENT TREE (DECIDUOUS) TREE TO REMAIN & PROTECT (DECIDUOUS) CRITICAL ROOT ZONE (C.R.Z.) = DIAMETER BREAST HEIGHT (INCHES) X 10 TREE (CONIFEROUS) M4 C.B.Z. TREE TO REMAIN & PROTECT (CONIFEROUS) CRITICAL ROOT ZONE (C.R.Z.) = DIAMETER BREAST HEIGHT (INCHES) X 10 TREE TO BE REMOVED (DECIDUOUS) TREE TO BE REMOVED (CONIFEROUS) STUMP TO BE REMOVED **MISCELLANEOUS AND AS-NEEDED QUANTITIES**


	LANLOUS AND AS-NEEDED QUANTITI		
	TOTAL	UNIT	DESCRIPTION
	1	LSUM	GENERAL CONDITIONS, MAX. \$
	1	LSUM	PROJECT SUPERVISION, MAX. \$
	30	FT	EROSION CONTROL, SILT FENCE
	250	FT	TREE PROTECTION FENCE
	<del>-11</del>	EA	TREE, REM, 6 IN 12 IN.
	1	EA	TREE, REM, 13 IN 19 IN.
	5	EA	STUMP, REM
	40	SYD	HMA, ANY THICKNESS, REM
	78	FT	DS_LAP JOINT
	<del>40</del>	\$YD	DS_MACHINE GRADING
	(, 5, '	'cyb''	, PIPE UNDERCUT AND BACKFILL, SANITARY
	5	CYD	PIPE UNDERCUT AND BACKFILL, STORM
	4	EA	TEMPORARY WATER MAIN LINE STOP, ADDITIONAL RENTAL DAY
	40	SYD	AGGREGATE BASE, 8 IN., 21AA, CIP
	1	TON	AGGREGATE SHOULDER, CL II, 23A
	12	TON	HAND PATCHING
	26	FT	PAVT MRKG, SPRAYABLE THERMOPL, 4 IN., WHITE
	52	FT	PAVT MRKG, SPRAYABLE THERMOPL, 4 IN., YELLOW
	10	FT	FENCE, SALVAGE AND RE-ERECT

DRIV

7

SHEET No.

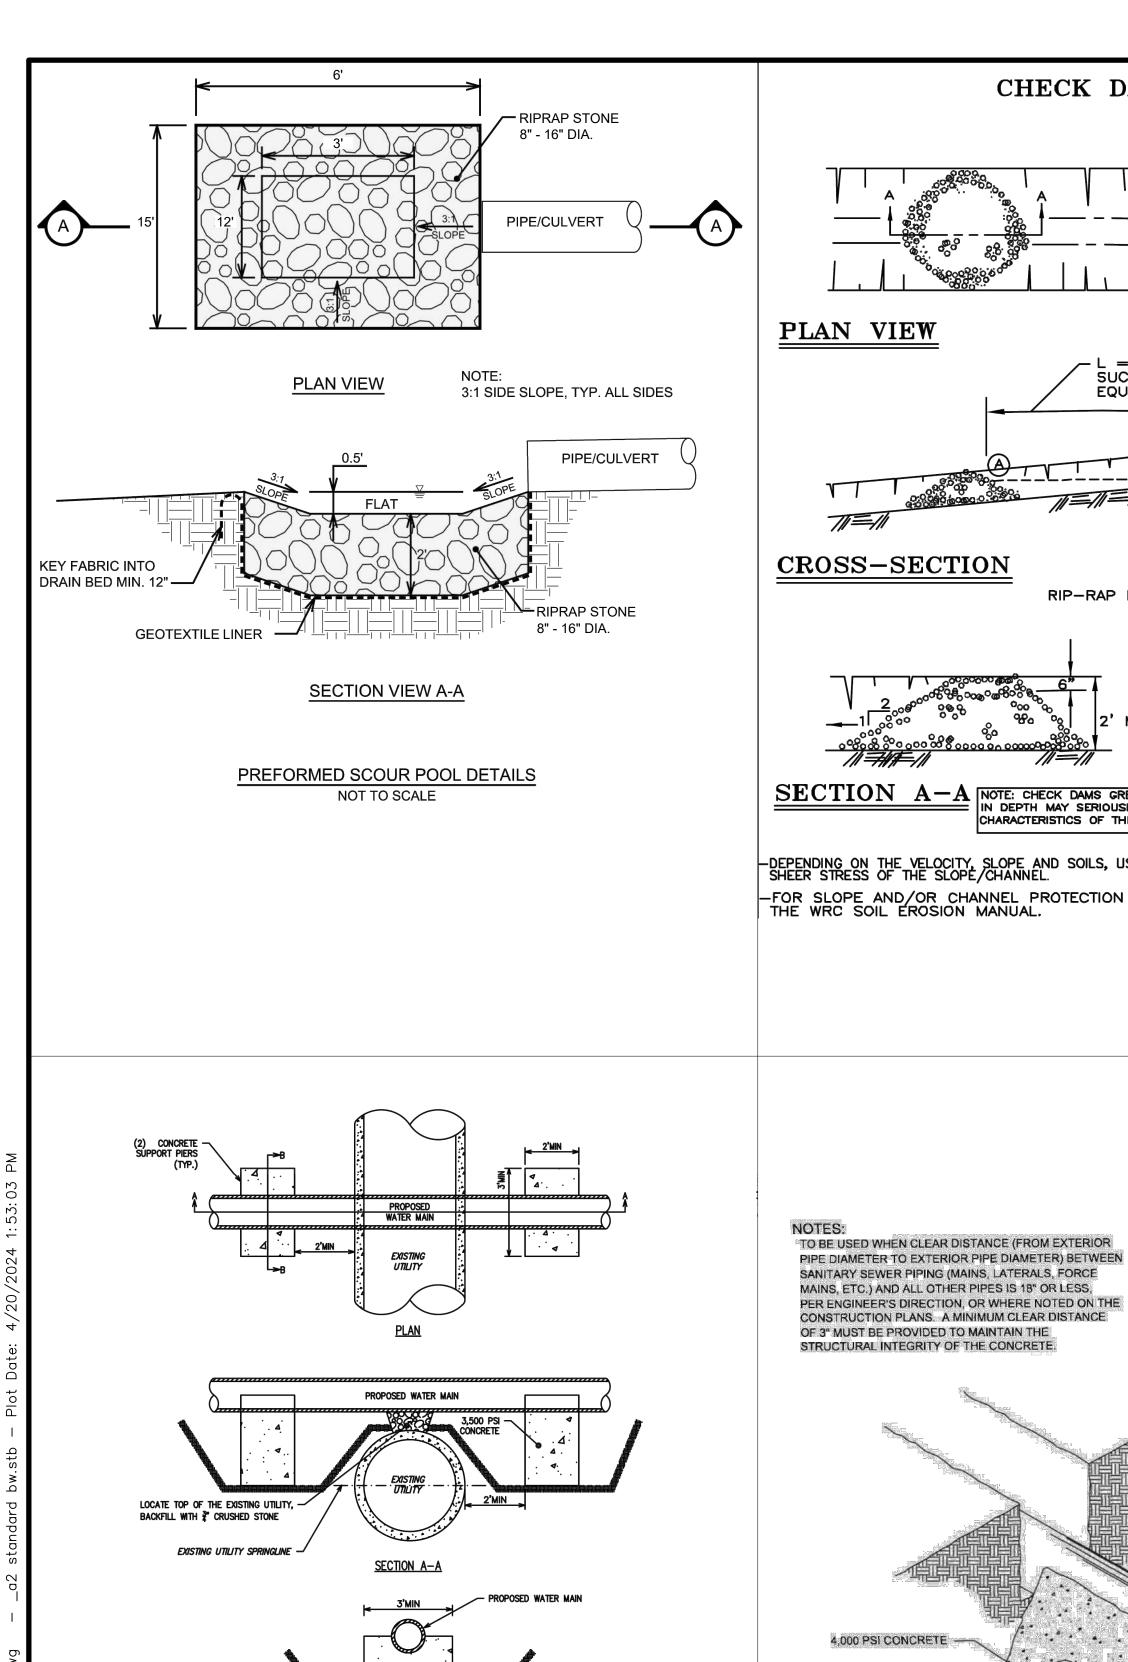

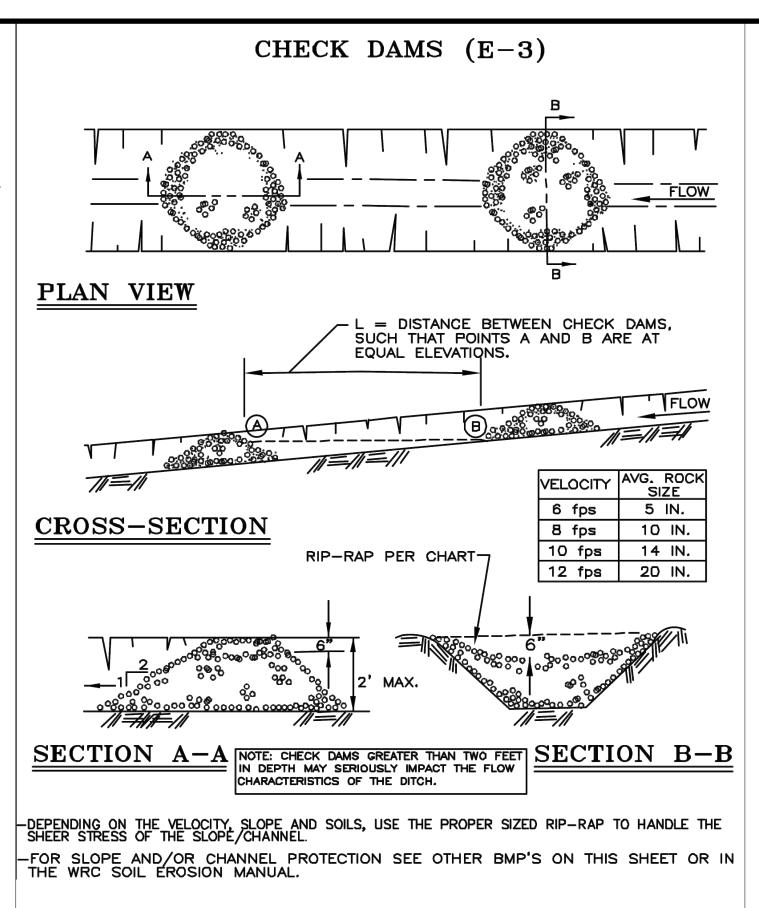

NOTIFY THE CITY OF ANN ARBOR SOIL EROSION CONTROL OFFICE 48 HOURS PRIOR TO BEGINNING WORK ON THE PROJECT. PHONE: 734-794-6265.

- THE CONTRACTOR SHALL IMPLEMENT AND MAINTAIN THE SOIL EROSION CONTROL MEASURES AS SHOWN ON THE PLANS AND AS DIRECTED BY THE ENGINEER AT ALL TIMES DURING CONSTRUCTION. ANY MODIFICATIONS OR ADDITIONS TO THE SOIL EROSION CONTROL MEASURES DUE TO CONSTRUCTION OR CHANGED CONDITIONS SHALL BE AS DIRECTED AND APPROVED BY THE ENGINEER.
- 2. ALL SOIL EROSION AND SEDIMENTATION CONTROL WORK SHALL CONFORM TO THE PERMIT REQUIREMENTS OF THE CITY OF ANN ARBOR, CHAPTER 55 ANN ARBOR UNIFIED DEVELOPMENT CODE, CITY OF ANN ARBOR STANDARDS DIVISION VII, THE LAWS OF THE STATE OF MICHIGAN, AND THE REQUIREMENTS OF THE CONTRACT DOCUMENTS.
- DAILY, OR AFTER ANY STORM EVENT, INSPECTIONS OF EROSION CONTROL MEASURES SHALL BE MADE BY THE CONTRACTOR. PERIODIC INSPECTIONS MAY BE MADE BY THE ENGINEER TO DETERMINE THE
- EFFECTIVENESS OF EROSION AND SEDIMENTATION CONTROL MEASURES. ANY NECESSARY CORRECTIONS SHALL BE MADE WITHOUT DELAY, AND WITHOUT ADDITIONAL COST TO THE CITY OF ANN ARBOR. . EROSION AND SEDIMENTATION FROM WORK ON THE SITE SHALL BE CONTAINED ON THE SITE AND NOT

BE ALLOWED TO COLLECT ON ANY OFF-SITE AREAS, ROADWAYS OR WATERWAYS.

- 5. ALL MUD/SOIL TRACKED ONTO ROADWAYS FROM THE SITE DUE TO CONSTRUCTION, SHALL BE PROMPTLY REMOVED BY THE CONTRACTOR. IF SO ORDERED, THE CONTRACTOR SHALL PROVIDE AND OPERATE A VACUUM-TYPE STREET SWEEPER, AT NO ADDITIONAL COST TO THE CITY OF ANN ARBOR.
- RESTORATION OF ALL DISTURBED AREAS, INCLUDING PLACEMENT OF TOPSOIL, SEED, FERTILIZER AND MULCH AND/OR SOD SHALL BE PERFORMED WITHIN FIVE (5) DAYS OF THE COMPLETION OF FINAL GRADE EXCÉPT WHERE TEMPORARY SEEDING OR AN ANCHORED MULCH BLANKET ARE SET FORTH AS TEMPORARY MEASURES PER THE APPROVED SEQUENCE OF SOIL EROSION MEASURES.
- . CONSTRUCTION OPERATIONS SHALL BE SCHEDULED AND PERFORMED SO THAT PREVENTATIVE SOIL EROSION CONTROL MEASURES ARE IN PLACE PRIOR TO EXCAVATION IN CRITICAL AREAS AND TEMPORARY STABILIZATION MEASURES ARE IN PLACE IMMEDIATELY FOLLOWING BACKFILLING OPERATIONS.
- 8. SPECIAL PRECAUTIONS WILL BE TAKEN IN THE USE OF CONSTRUCTION EQUIPMENT TO PREVENT SITUATIONS THAT PROMOTE EROSION.


9. PROPER DUST CONTROL SHALL BE MAINTAINED DURING CONSTRUCTION BY USE OF WATER TRUCKS

AND/OR DUST PALLIATIVE AS REQUIRED. 10. THE CONTRACTOR SHALL BE RESPONSIBLE FOR MAINTAINING ALL TEMPORARY SOIL EROSION CONTROL MEASURES AND REMOVAL OF SOME MEASURES UPON AUTHORIZED COMPLETION OF THE PROJECT.

FINAL COMPLETION OF PROJECT WILL NOT BE AUTHORIZED UNTIL ALL SITE WORK AND UTILITY

- CONSTRUCTION IS COMPLETE AND ALL SOILS ARE STABILIZED. 11. THE CONTRACTOR SHALL NOT GRADE INTO ADJACENT PROPERTIES. SILT AND PROTECTIVE FENCE SHALL BE INSTALLED AND MAINTAINED TO PREVENT GRADING, EROSION AND SEDIMENTATION INTO THE
- 12. TREE PROTECTION FENCING MUST REMAIN INTACT UNTIL RESTORATION OF THE SITE IS COMPLETE.

SD-SESC-6

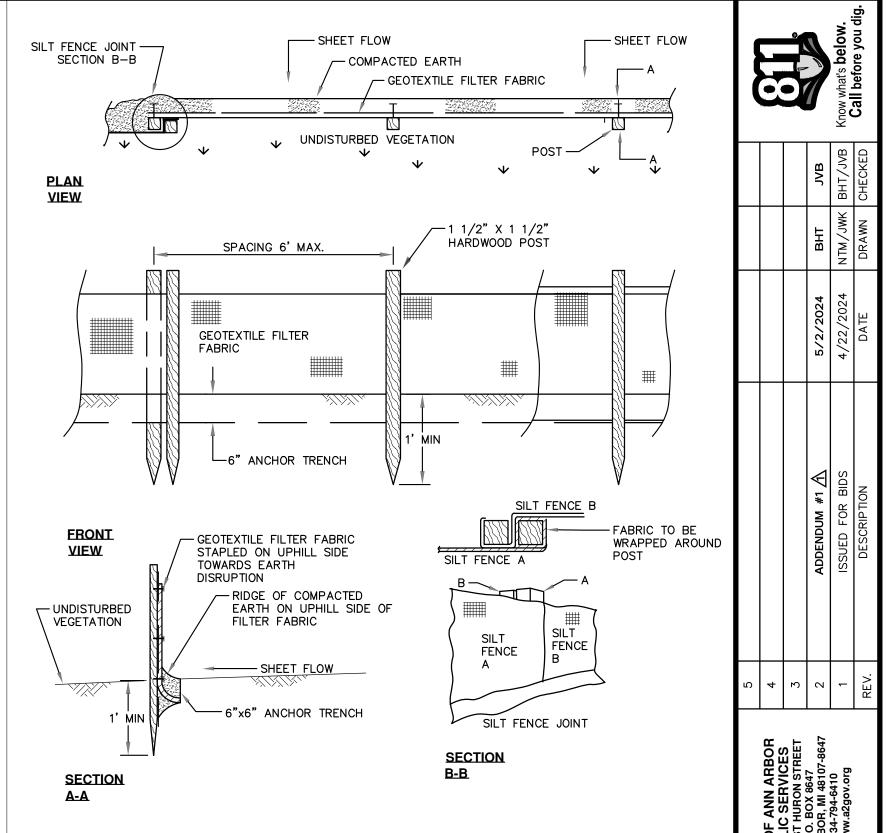






BURY UPHILL END IN

AND STAKE\* 12" O.C.


TRENCH 6" DEEP

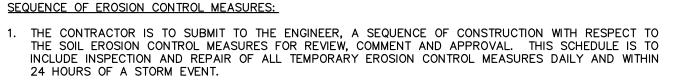

SAMPLE SOIL EROSION AND SEDIMENTATION CONTROL INSTALLATION MINIMUM REQUIREMENTS: INSTALL SILT FENCE, TREE PROTECTION FENCING, MUD MATS, INLET FILTERS ON EXISTING DRAINAGE FEATURES, AND ALL OTHER TEMPORARY SOIL EROSION CONTROLS, PRIOR TO ANY CLEARING OR EARTH MOVING OPERATION.

- 1.2. STRIP AND STOCKPILE TOPSOIL. STABILIZE STOCKPILE AS REQUIRED.
- 1.3. INSTALL WATER MAINS, STORM AND SANITARY SEWERS, AND OTHER ENCLOSED DRAINAGE FEATURES. NEW INLET FILTERS SHALL BE INSTALLED IMMEDIATELY FOLLOWING INSTALLATION OF NEW DRAINAGE
- 1.4. PERFORM MACHINE GRADING OPERATIONS AND CONSTRUCT PAVEMENTS (MAINLINE, SIDEWALKS, DRIVES, ETC.).
- 1.5. CONTINUALLY MAINTAIN EROSION AND SEDIMENTATION CONTROL MEASURES, AS REQUIRED TO ALLOW DRAINAGE AND SEDIMENT REMOVAL. REMOVE ANY ACCUMULATED SEDIMENT IMMEDIATELY.
- 1.6. COMPLETE ALL FINE GRADING.
- 1.7. INSTALL TEMPORARY SEED DURING CONSTRUCTION IN ACCORDANCE WITH ARTICLE 8 OF THE CITY'S PUBLIC WORKS DESIGN AND CONSTRUCTION STANDARDS. DURING MONTHS UNFAVORABLE TO SEEDING, AN ANCHORED MULCH BLANKET SHALL BE INSTALLED PER SD-SESC-4.
- 1.8. REFER TO LANDSCAPE PLANTING PLANS FOR PERMANENT SITE STABILIZATION.
- 1.9. CLEAN OUT STORM SEWER SYSTEMS.
- 1.10. REMEDY ANY NOTED DEFECTS TO THE SATISFACTION OF THE CITY OF ANN ARBOR'S SOIL EROSION AND SEDIMENTATION CONTROL OFFICIAL.
- 1.11. ALL TEMP. SOIL EROSION CONTROL MEASURES MUST BE REMOVED, WITH ENGINEERS APPROVAL, PRIOR TO FINAL INSPECTION

NOTE: THIS SEQUENCE IS FOR INFORMATION ONLY. IT IS INTENDED TO SHOW THE SEQUENCE OF CONSTRUCTION WITH RESPECT TO THE SOIL EROSION AND SEDIMENTATION CONTROL MEASURES. THE CONTRACTOR IS RESPONSIBLE FOR SUBMITTING THEIR OWN DETAILED CONSTRUCTION SEQUENCE AND SCHEDULE TO THE ENGINEER FOR REVIEW, COMMENT, AND APPROVAL. THE APPROVED SEQUENCE OF SOIL EROSION MEASURES MUST BE INCLUDED ON THE APPROVED CONSTRUCTION PLANS.

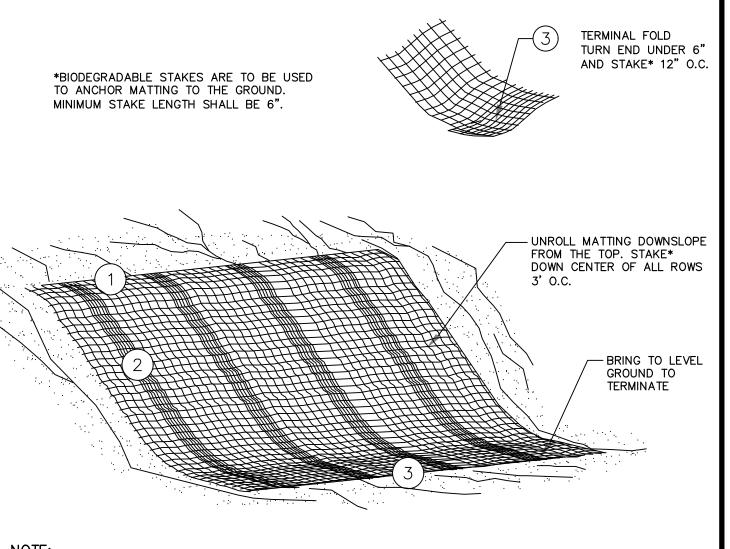

PROVIDE EROSION CONTROL MATTING ON ALL DISTURBED AREAS TO BE PERMANENTLY RESTORED WITH GRASS AND AS DIRECTED BY THE ENGINEER. SEE LANDSCAPE PLANS FOR MORE DETAILS. MATERIAL SHALL BE RAPIDLY BIODEGRADABLE. USE OF PLASTIC MATERIALS IS SPECIFICALLY PROHIBITED.

SD-SESC-7 SEQUENCE OF SOIL EROSION **CONTROL MEASURES** 

SHEET No SD-SESC-4 3 OF 9 **MULCH BLANKET** 

LONGITUDINAL OVERLA

OVERLAP EDGES 6"

AND STAKE\* 12" 0.0

24


BID


DRIVI


entra en SECTION B-B UTILITY CROSSING BRIDGE 1. CROSSING BRIDGE IS REQUIRED WHEN 18 INCHES OF CLEARANCE OR GREATER ABOVE (WITHIN A 1:1 INFLUENCE OF THE SPRING LINE) AN EXISTING UTILITY CANNOT BE

> UTILITY PIPE SPANNING THE EXISTING UTILITY MUST BE CENTERED BETWEEN JOINTS OVER THE EXISTING UTILITY. ALL WORK NECESSARY TO CONSTRUCT THE UTILITY CROSSING BRIDGE AS SHOWN SHALL BE CONSIDERED INCLUDED IN THE UNIT PRICE BID FOR THE ITEM

"DS UTILITY BRIDGE - EA" AND WILL NOT BE PAID FOR SEPARATELY.

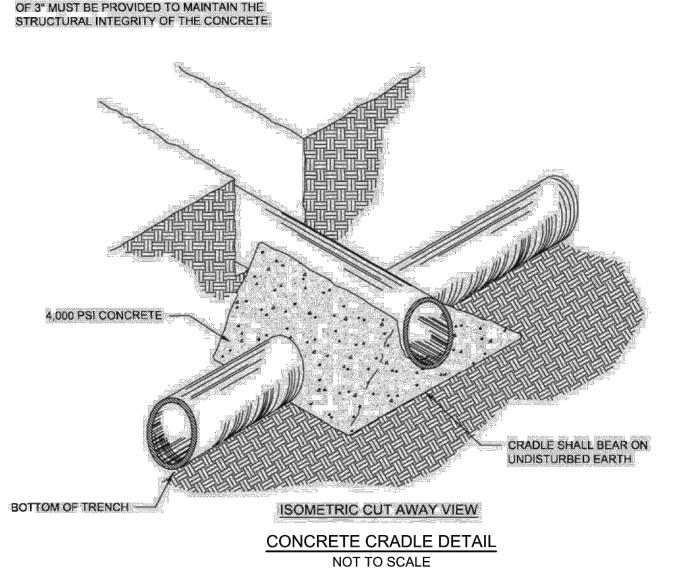

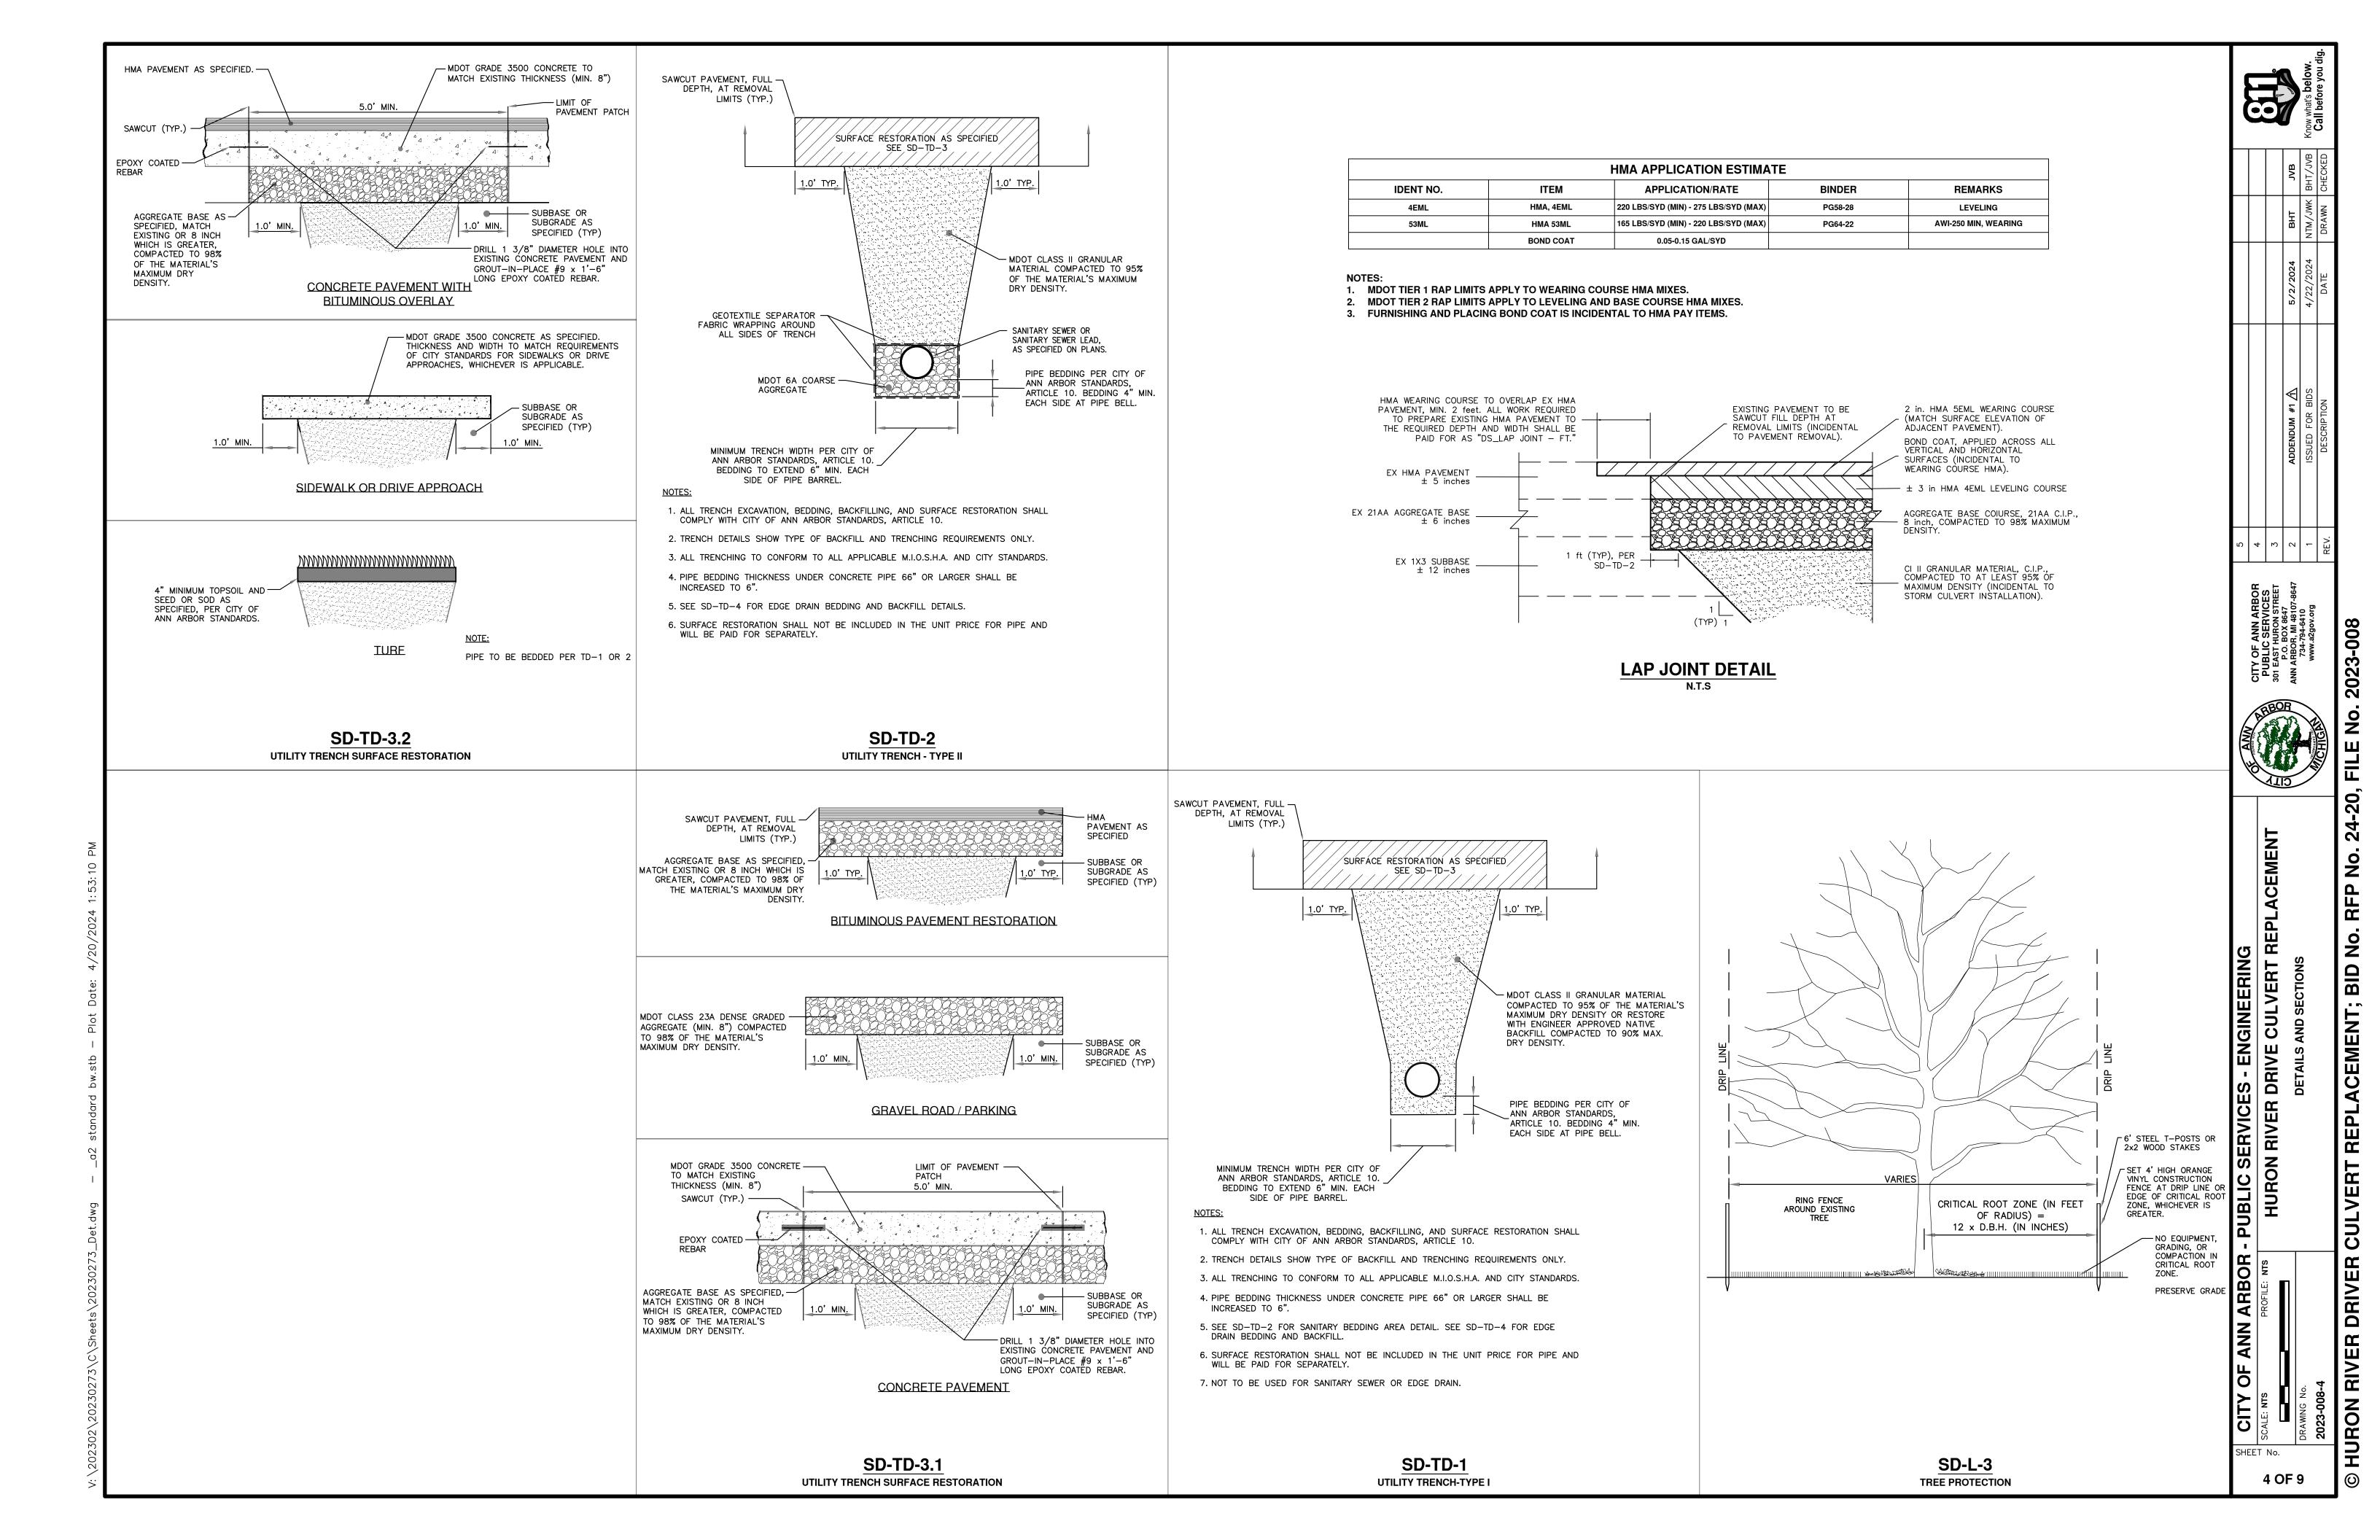

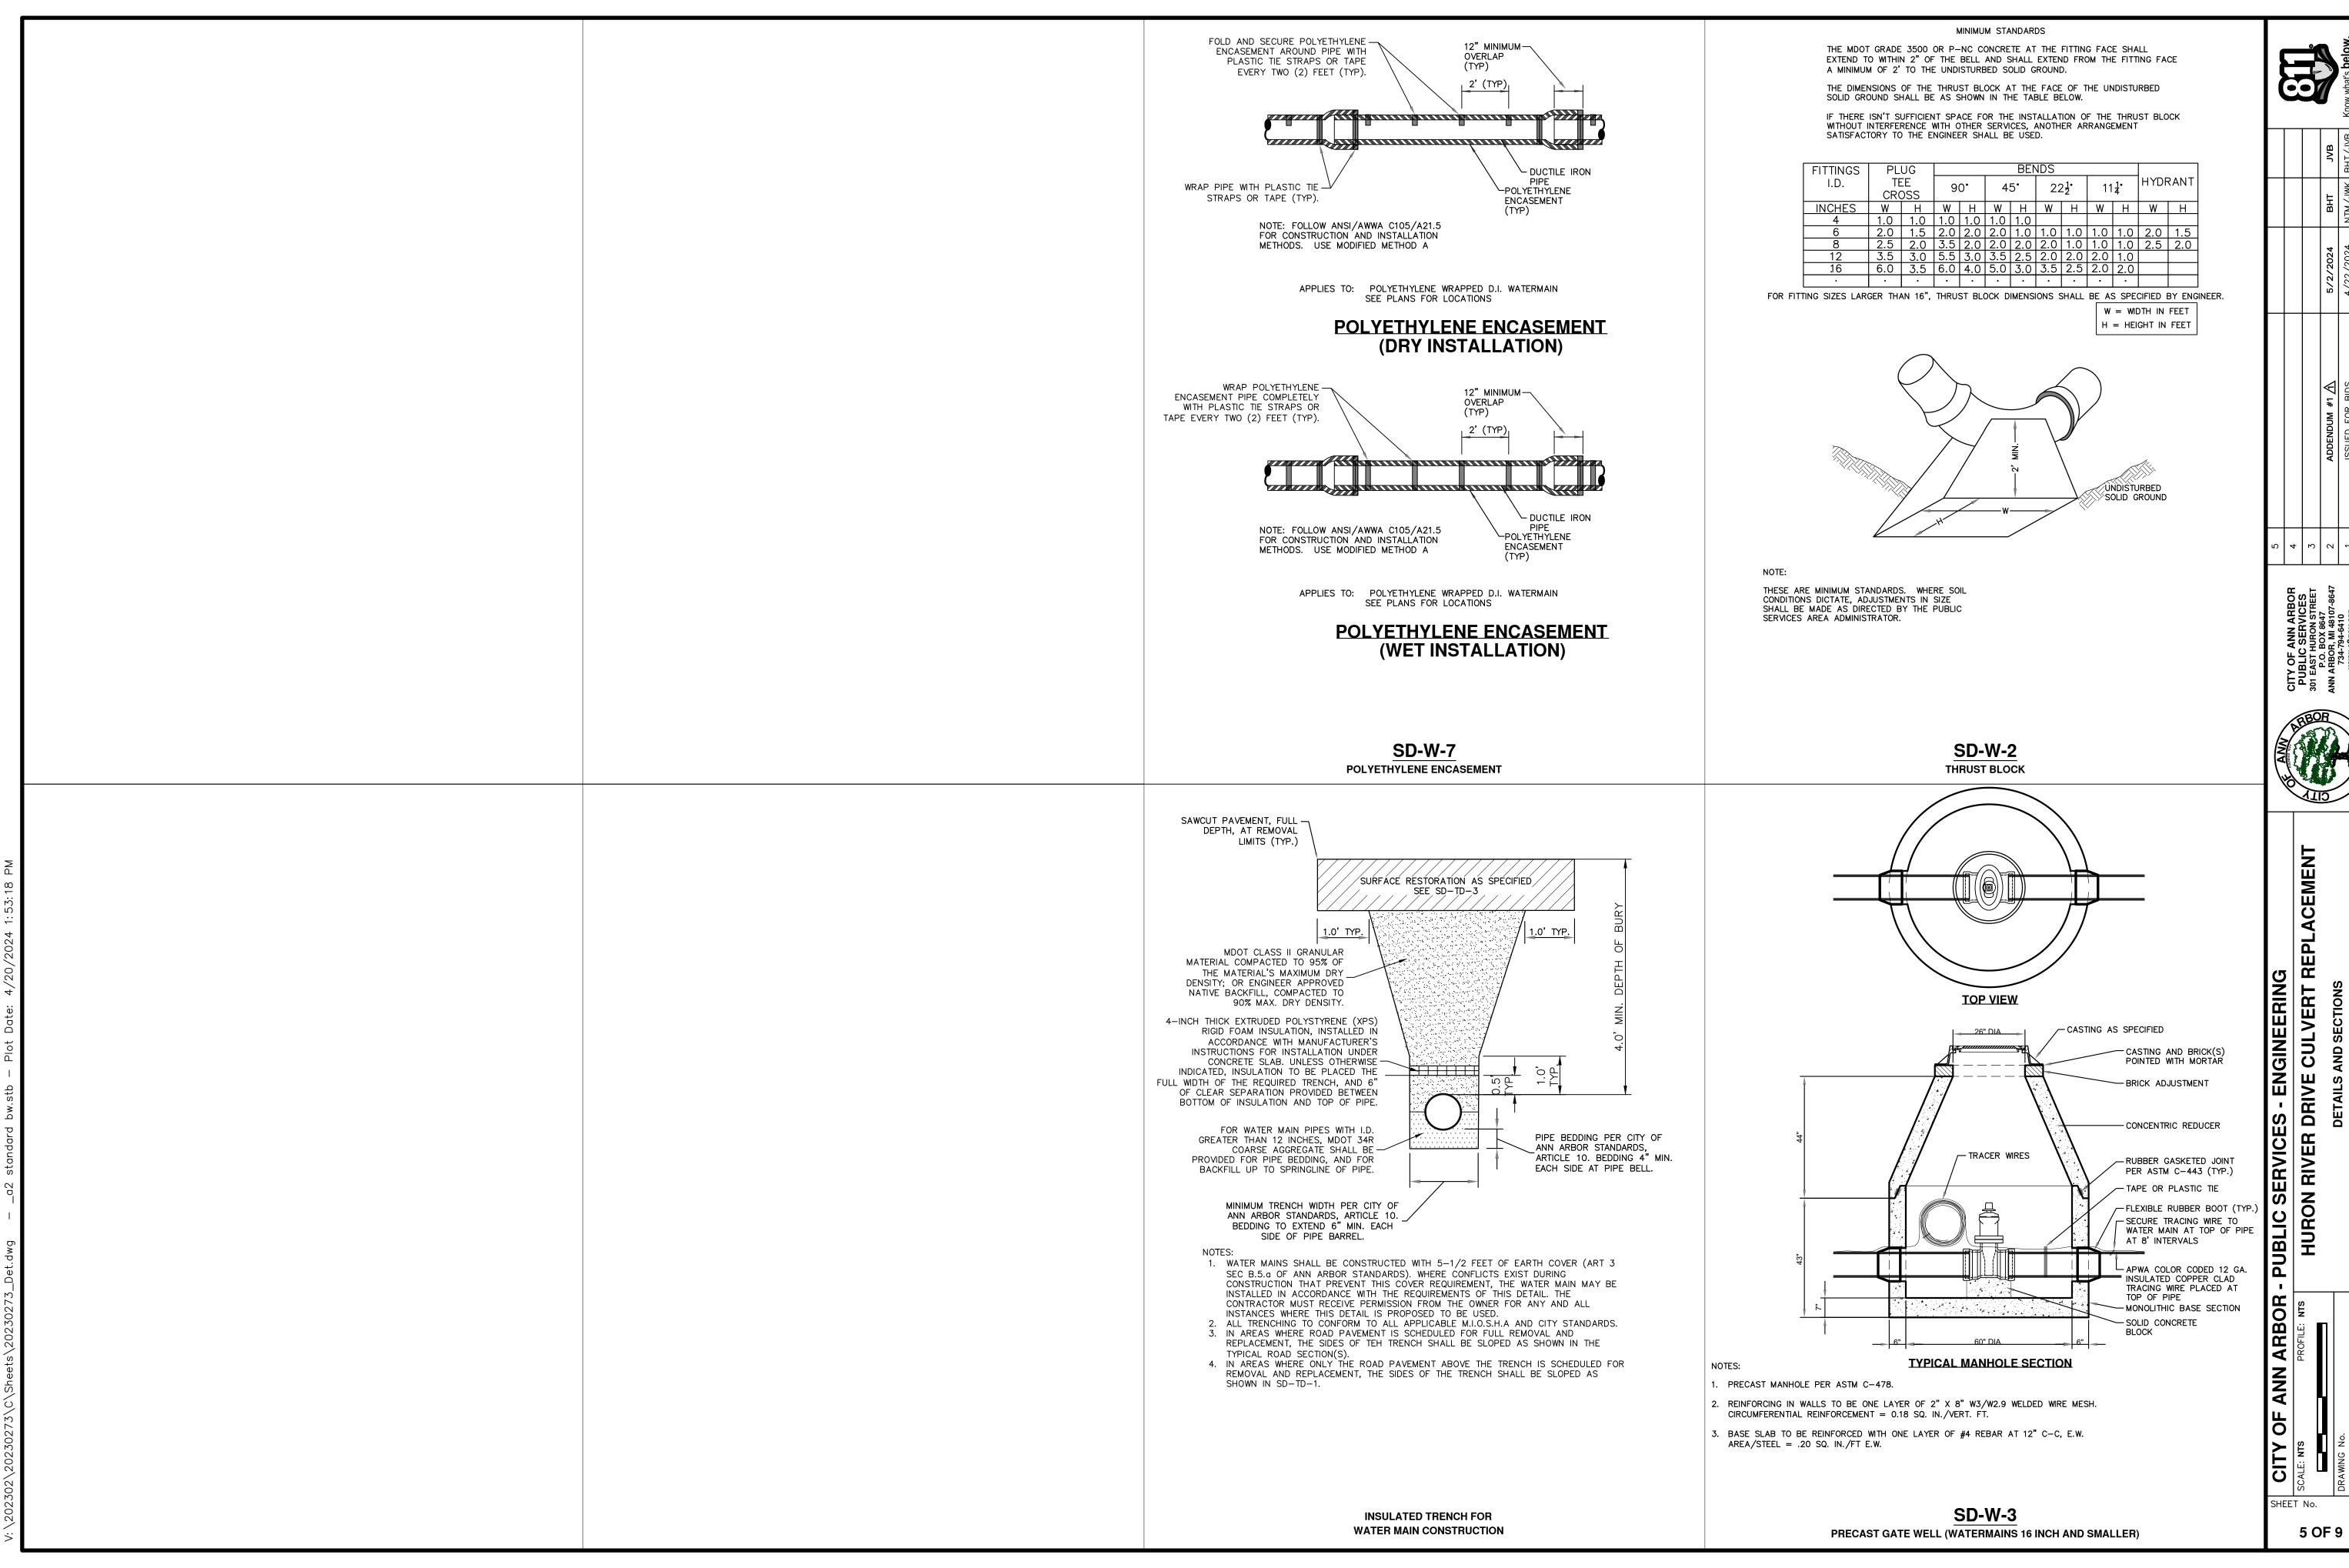




24

BID

DRIVE

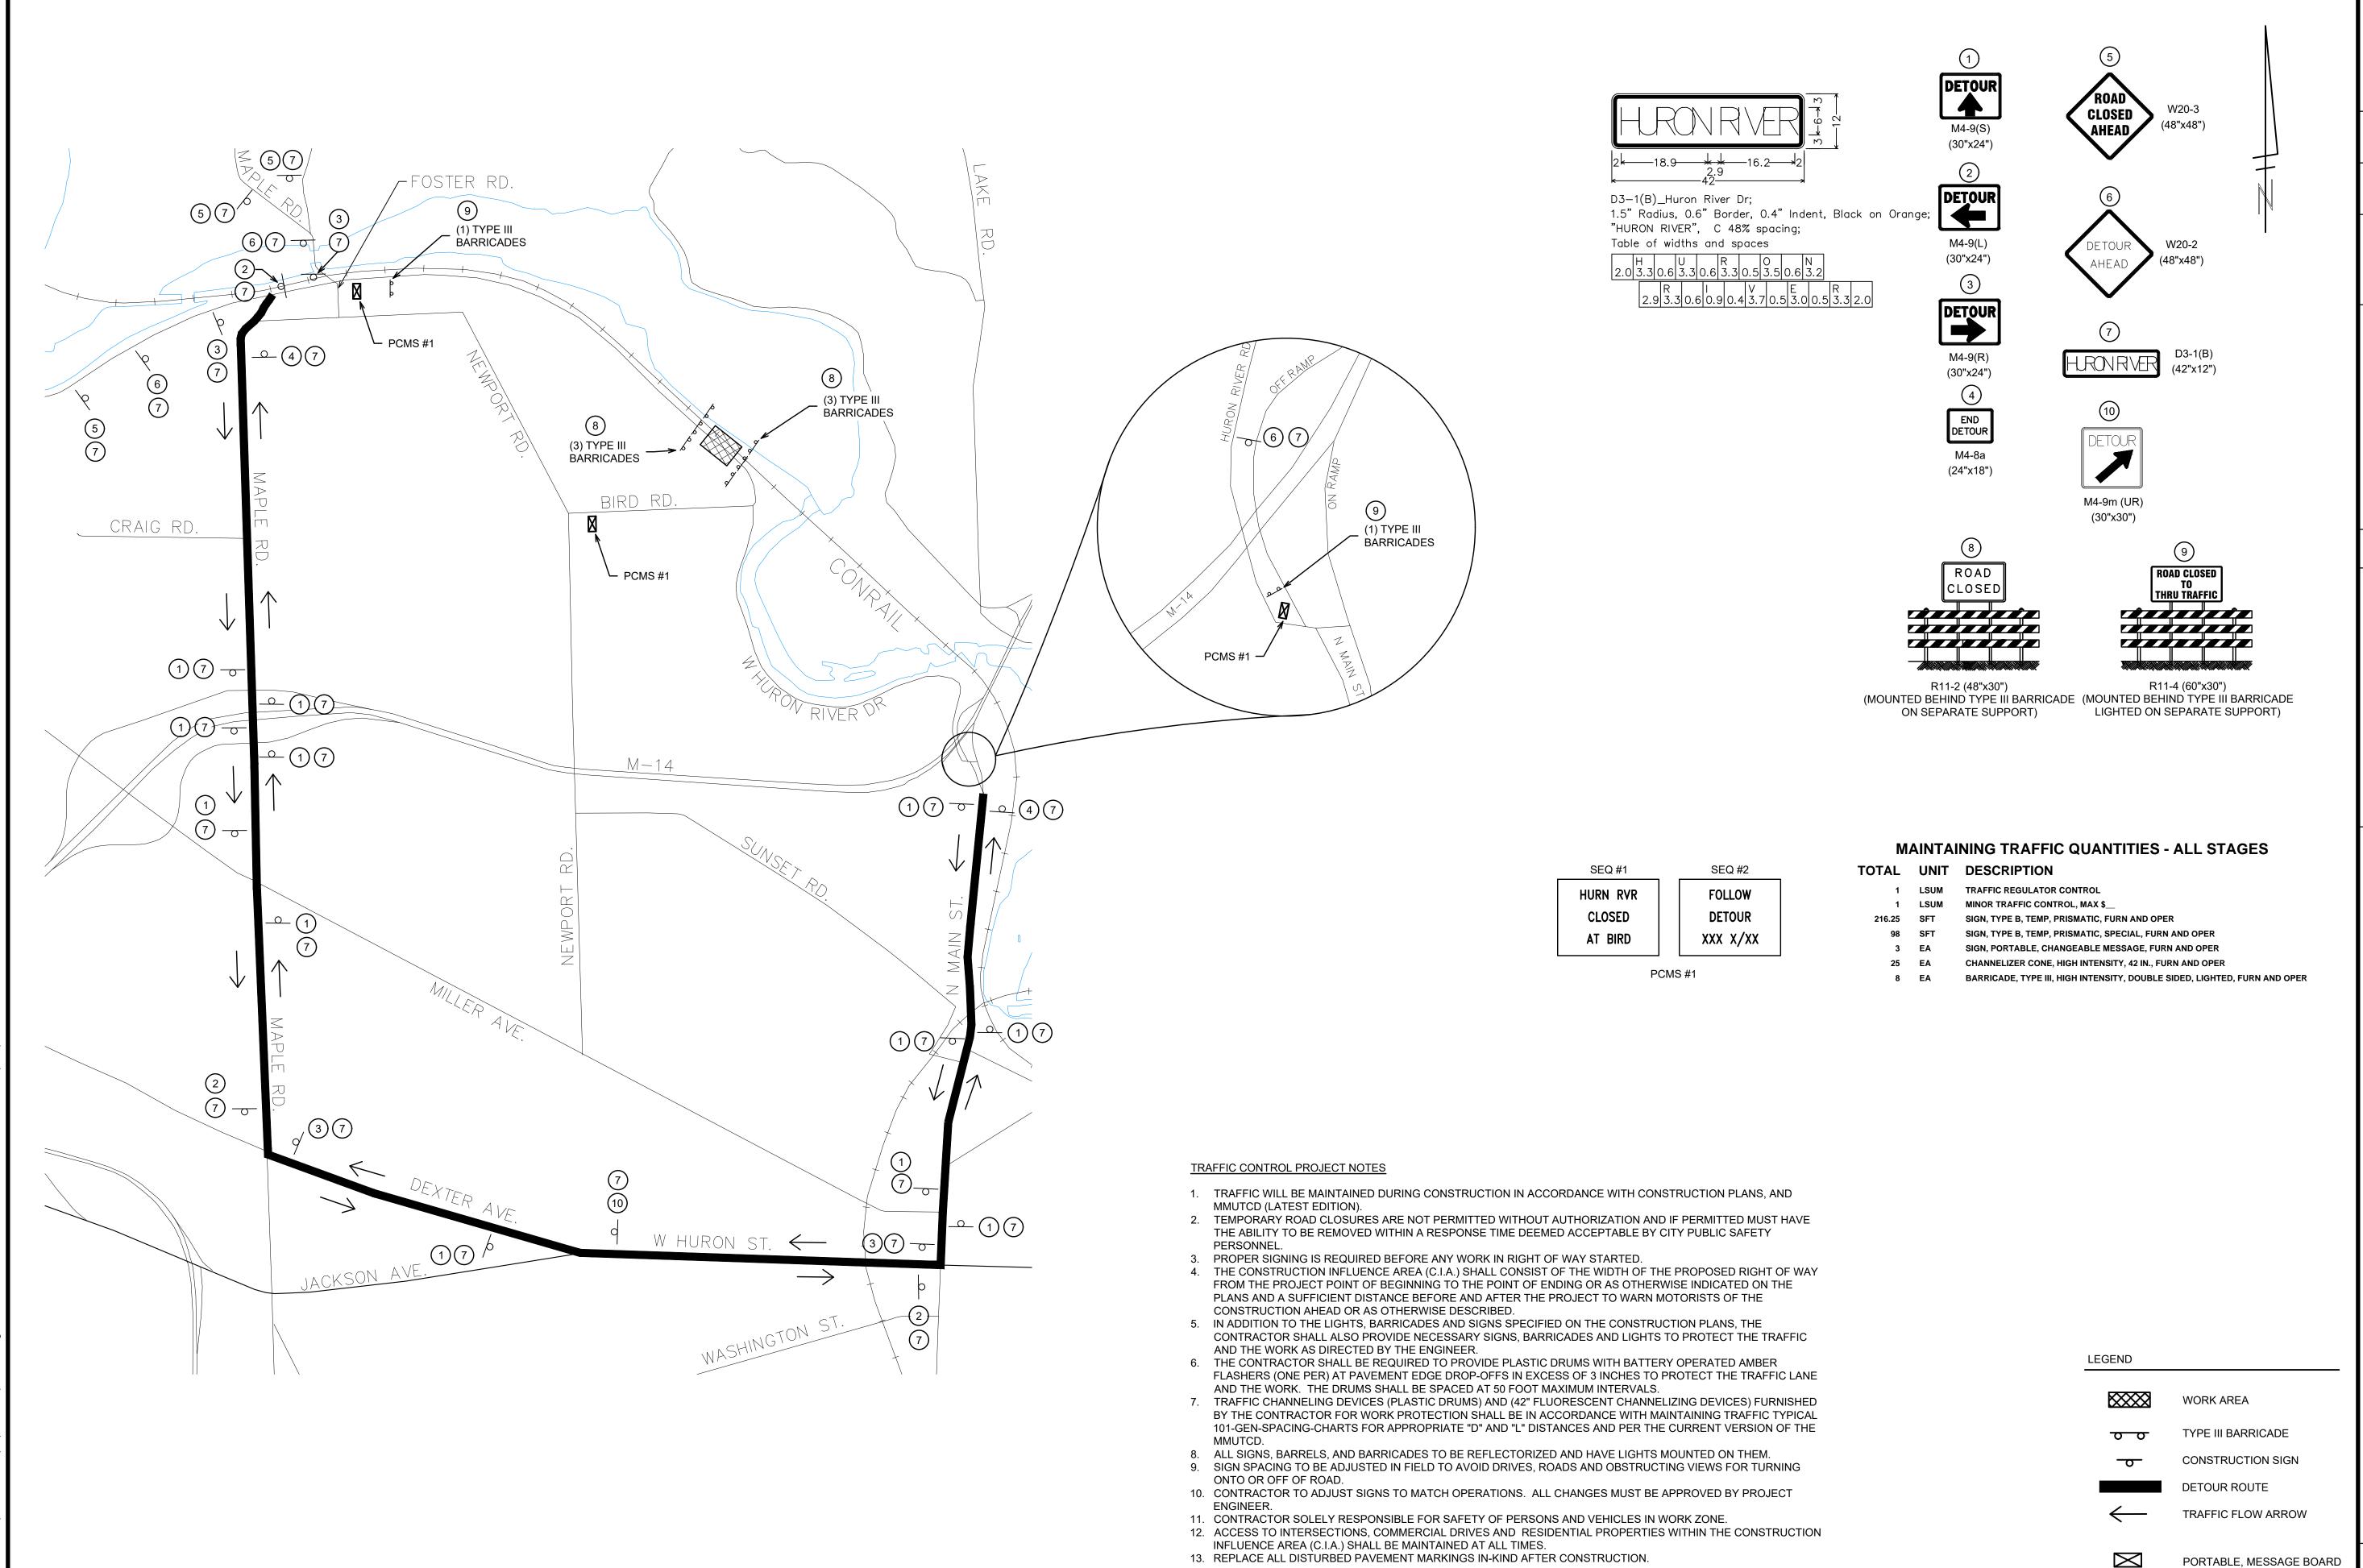






DRIVE

6 OF 9

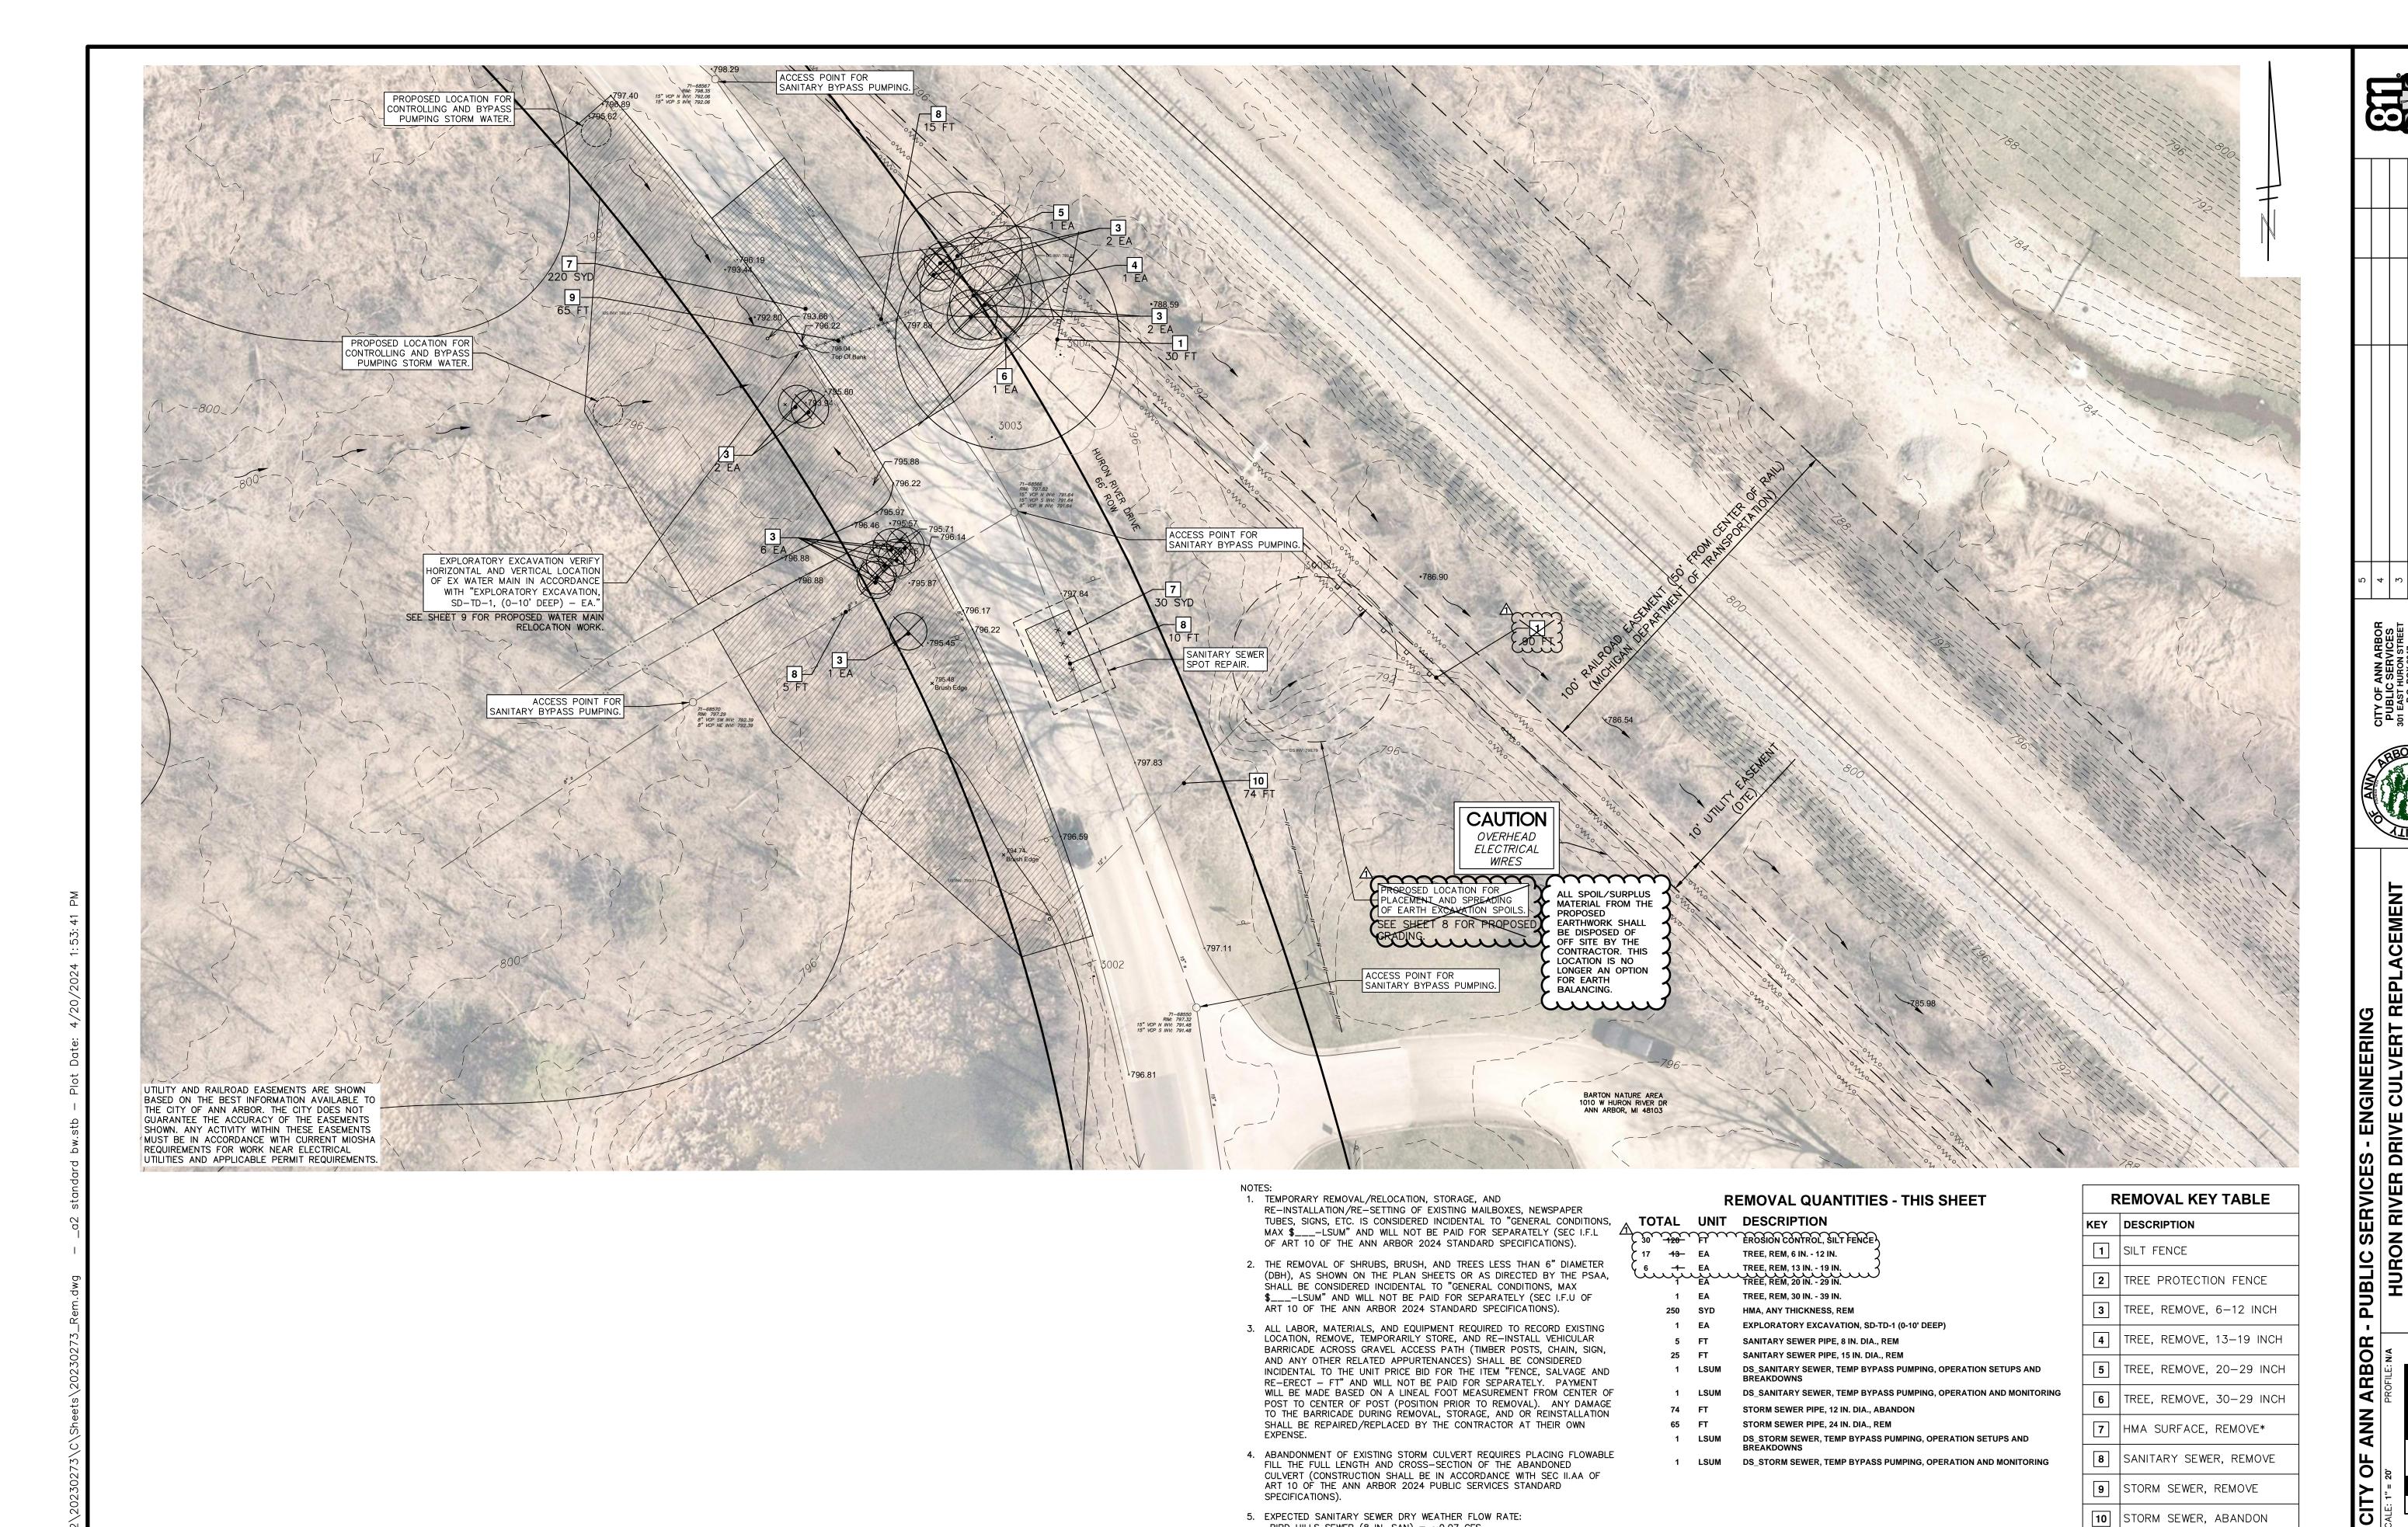

5. EXPECTED SANITARY SEWER DRY WEATHER FLOW RATE: BIRD HILLS SEWER (8 IN. SAN) =  $\sim 0.07$  CFS HURON RIVER SEWER (15 IN. SAN) =  $\sim$ 0.52 CFS

6. EXPECTED SANITARY SEWER WET WEATHER FLOW RATES:

BIRD HILLS SEWER (8 IN. SAN) = TBD

HURON RIVER SEWER (15 IN. SAN) = TBD


BID DRIVE **HURON RIVER** 

SHEET No.

7 OF 9

10 STORM SEWER, ABANDON

\*SAWCUT FULL DEPTH AT REMOVAL LIMITS

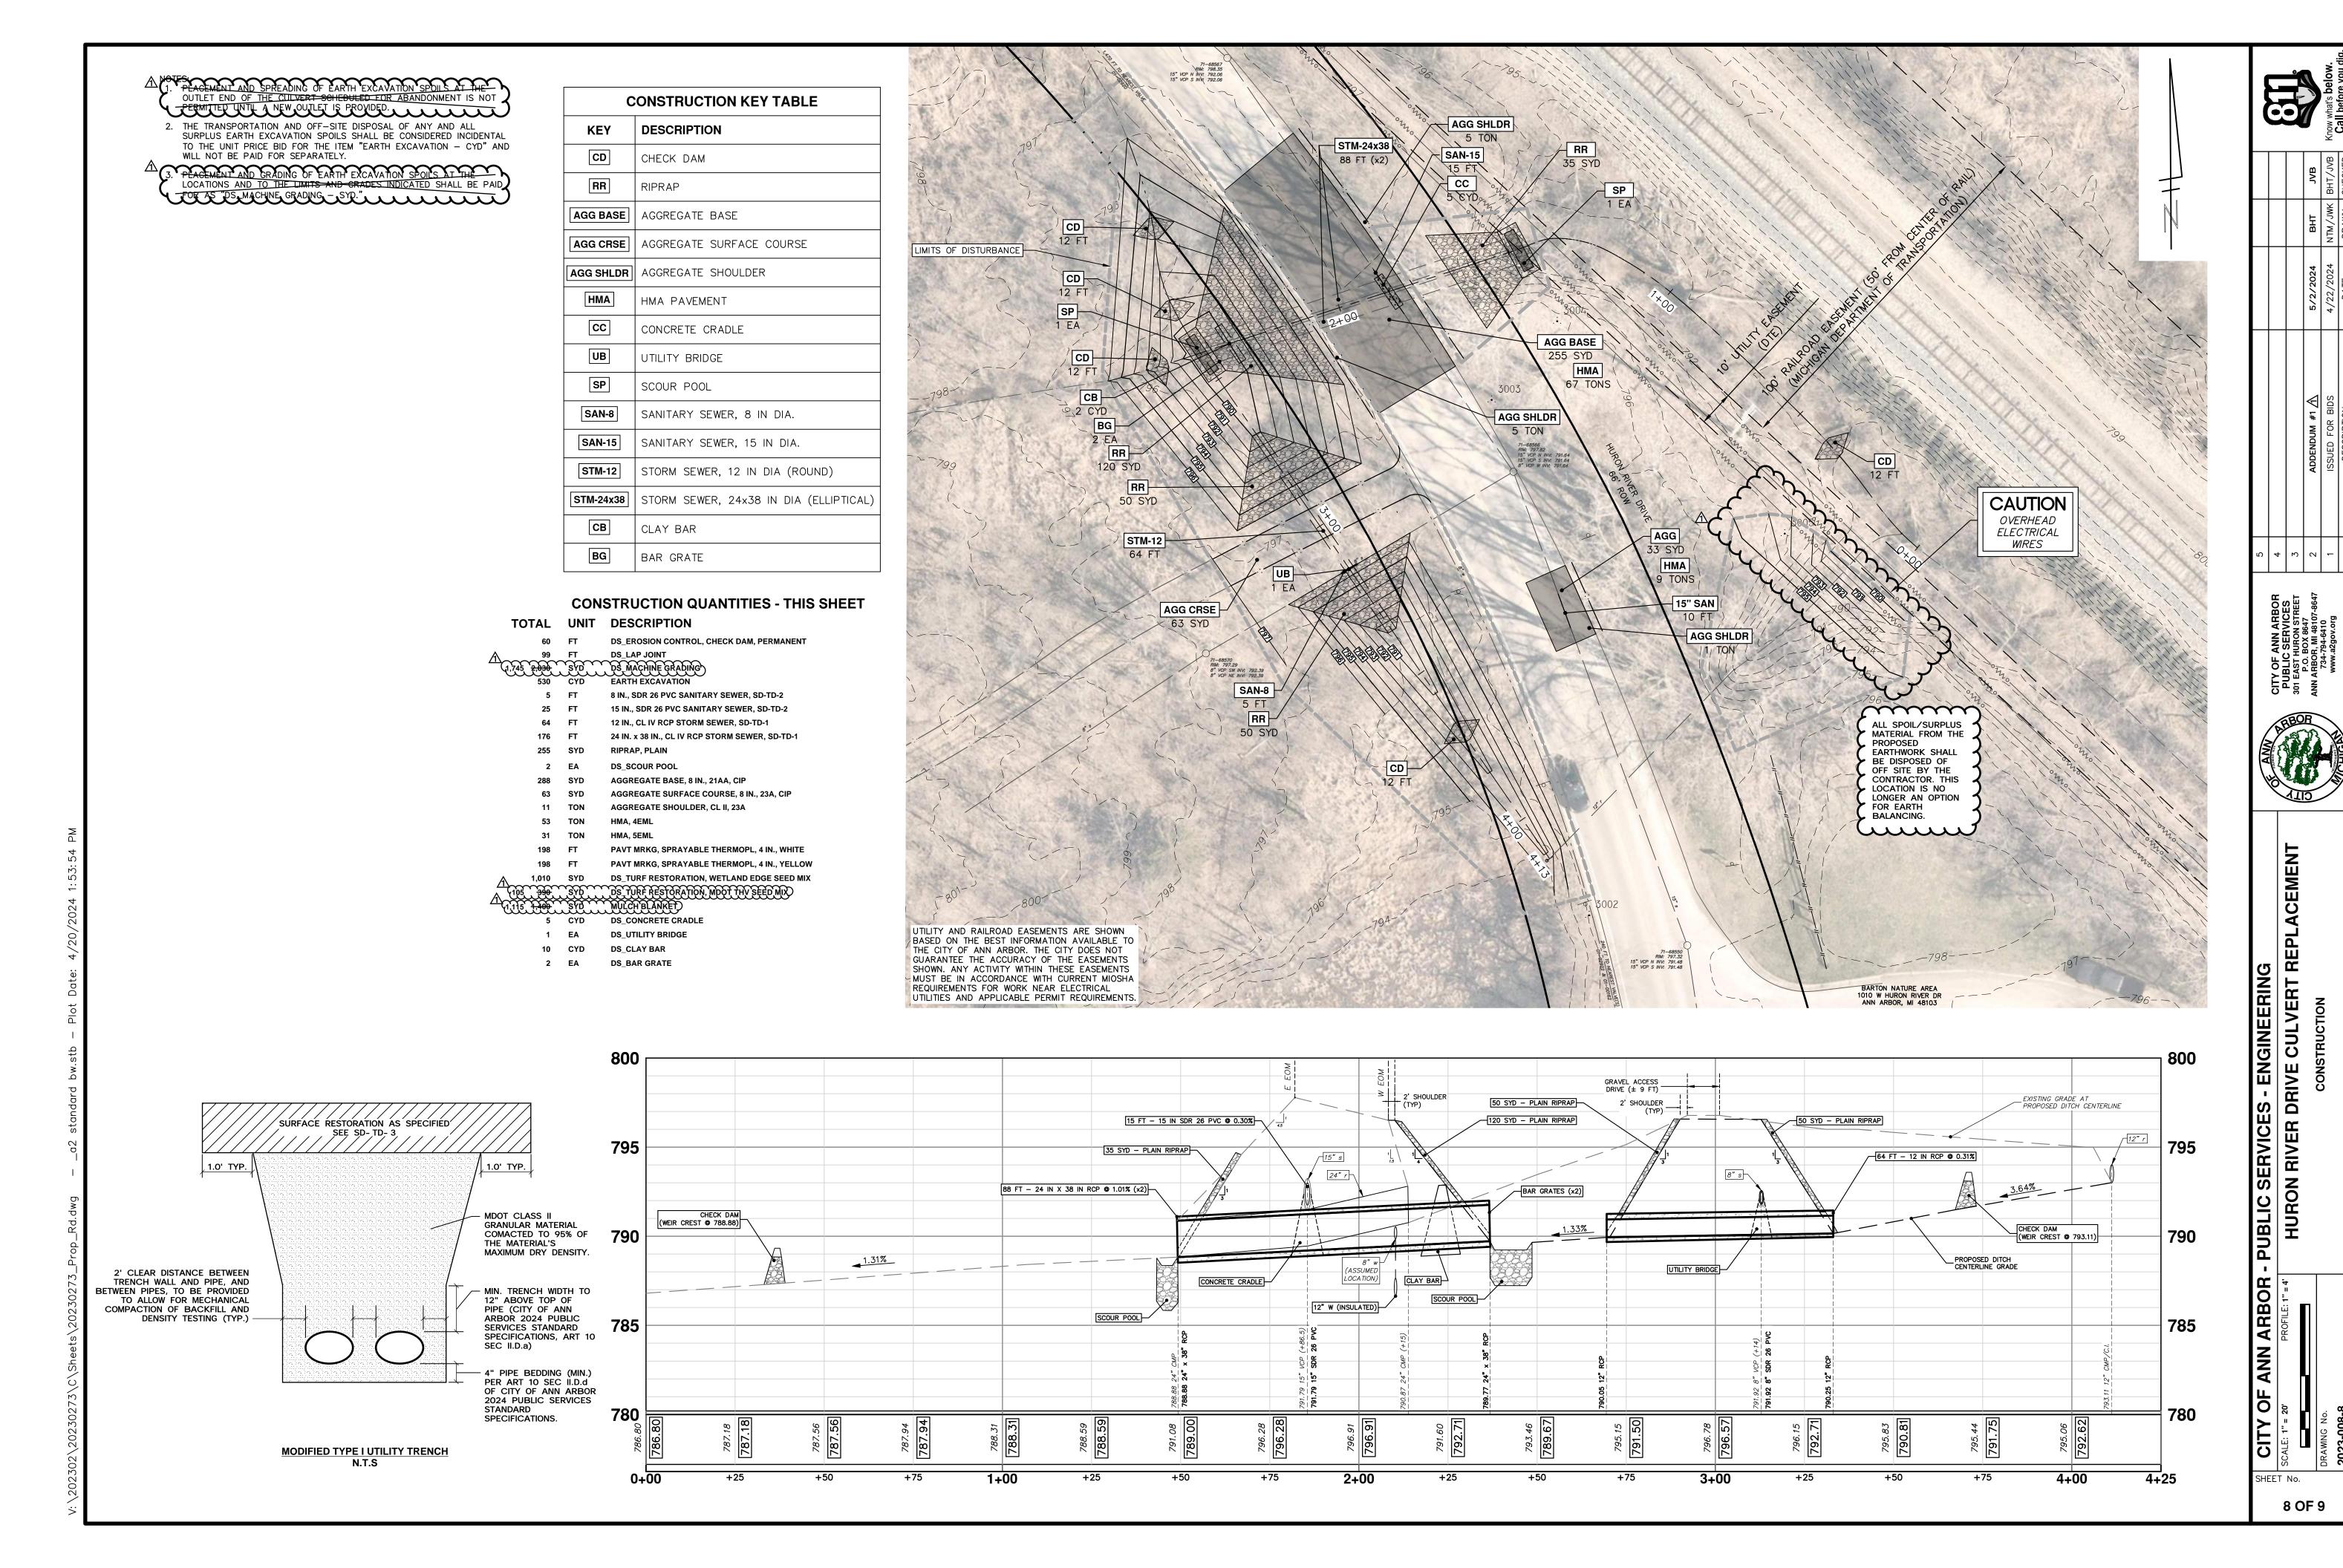

ACEMENT; BID RE **HURON RIVER DRIVER** 

0

# WATER MAIN PROFILE VIEW


VERT: 1" = 4' HORIZ: 1" = 20'

NOTES:

1. STATION 0+00 IS ALIGNED WITH SANITARY MANHOLE 71-68567.

2. THE PROPOSED 24"x38" CULVERTS ARE CENTERED ABOUT STATION 0+71.

3. APPROXIMATE LIMITS OF REMOVAL AND RELOCATION ARE FROM 0+38 TO 0+94. ACTUAL LIMITS AND LOCATIONS OF REMOVAL AND RELOCATION WORK TO BE DETERMINED BY CITY AFTER EXPLORATORY EXCAVATION WORK IS COMPLETED.

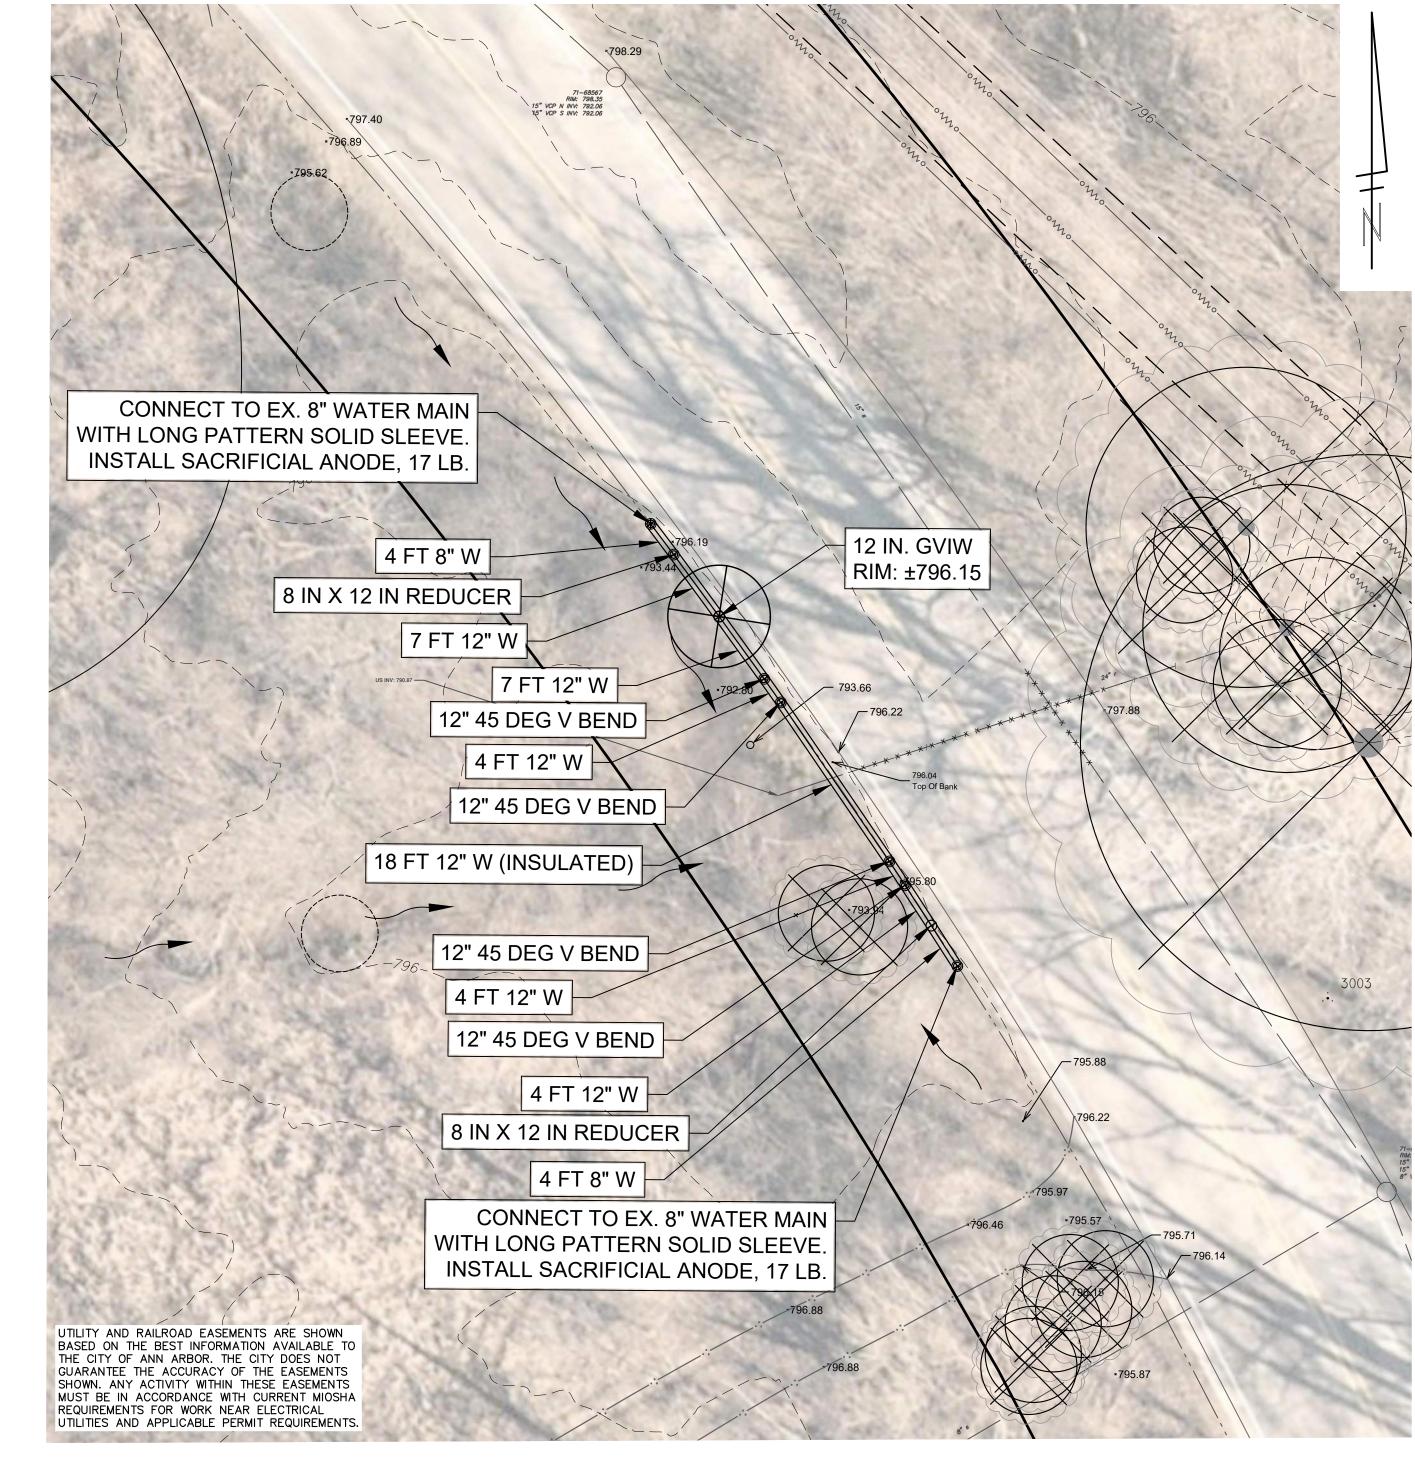

NOTES:

1. WHERE EXISTING WATER MAIN IS EXPOSED FOR A CONNECTION OR APPURTENANCE INSTALLATION, THE CONTRACTOR SHALL INSTALL ONE SACRIFICIAL ANODE ON THE EXISTING PIPE. IF THE NEW FITTING IS INSTALLED IN—LINE WITH THE EXISTING MAIN. SUCH AS AT A CUT—IN TEE OR VALVE INSERTION, ONE ANODE SHALL BE INSTALLED ON THE EXISTING PIPE TO EACH SIDE OF THE NEW FITTING. EACH ANODE INSTALLED ON EXISTING WATER MAIN WILL BE PAID FOR AS "SACRIFICIAL ANODE, \_\_\_ LB."

- 2. THE CONTRACTOR SHALL REMOVE THE NECESSARY PORTIONS OF THE EXISTING WATER MAIN IN ORDER TO FACILITATE THE PROPOSED WATER MAIN RELOCATION WORK. REMOVAL WORK SHALL BE PAID FOR AS "WATER MAIN PIPE, \_\_ IN. DIA., REM FT."
- 3. A DETECTABLE TRACER WIRE SHALL BE INSTALLED THE ENTIRE LENGTH OF THE WATER MAINS, SHALL EXTEND TO ALL HYDRANTS, BLOWOFFS, DEAD ENDS, AND POST INDICATOR VALVES, AND SHALL TERMINATE IN THE GATE VALVES LOCATED AT EACH END OF THE WATER MAIN CONSTRUCTION, OR AS DIRECTED BY THE CITY ENGINEER.
- 4. FURNISHING AND INSTALLING LONG PATTERN SOLID SLEEVES FOR CONNECTIONS (NEW WM TO EX WM) SHALL BE CONSIDERED INCIDENTAL TO THE UNIT PRICE BID FOR "\_\_ IN., PC 350 DIP W/POLYWRAP, SD-TD-1 FT," AND WILL NOT BE PAID FOR SEPARATELY.
- 5. A MINIMUM DISTANCE EQUAL TO 10 FEET FOR EVERY INCH OF PIPE DIAMETER (ID) SHALL BE PROVIDED BETWEEN THE PROPOSED POINTS OF CONNECTION BETWEEN THE NEW AND EXISTING WATER MAINS, AND THE LOCATION OF THE PROPOSED TEMPORARY WATER MAIN LINE STOPS.
- 6. THE REMOVAL OF EXISTING PAVEMENT REQUIRED FOR TEMPORARY WATER MAIN LINE STOP SHALL BE PAID FOR AS "HMA, ANY THICKNESS, REM SYD." THE RE—CONSTRUCTION OF ANY AGGREGATE SHOULDER, AGGREGATE BASE, AND/OR HMA PAVEMENT WITHIN THE LIMITS OF A PROPOSED WATER MAIN LINE STOP SHALL BE PAID FOR AS "AGGREGATE SHOULDER, CL II, 23A TON." "AGGREGATE BASE, 8 IN., 21AA, CIP SYD." AND "HAND PATCHING TON," RESPECTIVELY.

7. THE LOCATION OF PROPOSED CONNECTION LOCATIONS, FITTINGS, AND VALVES ARE SHOWN BASED ON LIMITED INFORMATION AVAILABLE TO THE CITY OF ANN ARBOR FOR THE EXISTING 8 IN WATER MAIN IN THIS AREA. IT IS THE OWNER'S INTENT TO HAVE AN EXPLORATORY INVESTIGATION PERFORMED BY THE CONTRACTOR PRIOR TO ANY OTHER WORK BEGINNING, IN ORDER TO CONFIRM THE HORIZONTAL AND VERTICAL LOCATION OF THE EXISTING 8 IN WATER MAIN. THE LOCATION OF PROPOSED VALVES, FITTINGS, AND CONNECTION POINTS MAY BE REVISED BY THE OWNER BASED ON THE CONFIRMED LOCATION OF THE EXISTING

WATER MAIN.

8. WATER MAIN, WHERE INDICATED IN THE PLANS, OR AS DIRECTED BY THE OWNER, SHALL BE INSULATED IN ACCORDANCE WITH THE DETAIL GIVEN ON SHEET 5. ALL LABOR, MATERIALS, AND EQUIPMENT REQUIRED TO INSULATE WATER MAIN IN ACCORDANCE WITH THE REQUIREMENTS OF THESE PLANS SHALL BE CONSIDERED INCIDENTAL TO THE UNIT PRICE BID FOR THE ITEM(S) "\_\_\_\_ IN., PC 350 DIP W/POLYWRAP, SD-TD-1 - FT" AND WILL NOT BE PAID FOR SEPARATELY.

# WATER MAIN QUANTITIES - THIS SHEET TOTAL UNIT DESCRIPTION

8 FT 8 IN., PC 350 DIP W/POLYWRAP, SD-TD-1
44 FT 12 IN., PC 350 DIP W/POLYWRAP, SD-TD-1

4 EA 12 IN. 45 DEG DIP BEND
2 EA 8 IN. X 12 IN. DIP REDUCER

1 EA DS\_GATE VALVE IN WELL, 12 IN.
2 EA SACRIFICIAL ANODE, 17-POUND

EA TEMPORARY WATER MAIN LINES STOP, 8 IN. OR LESS
FT WATER MAIN PIPE, 8 IN. DIA., REM

WATER MAIN STRUCTURE TABLE							
STRUCTURE	TYPE	STATION	RIM	DEPTH T/P	DIAMETER	COVER TYPE	
						MDOT	

GVIW | N/A  $|\pm 796.15| \pm 5.75$  | 60 IN.

© HURON RIVER DRIVER CULVERT REPLACEMENT; BID No. RFP No.

SHEET No.

9 OF 9