

ADDENDUM No. 4

RFP No. 26-03

ANN STREET IMPROVEMENTS

Due: January 29, 2026, at 2:00 PM (local time)

The information contained herein shall take precedence over the original documents and all previous addenda (if any) and is appended thereto. **This Addendum includes 12 pages.**

The Proposer is to acknowledge receipt of this Addendum No. 4, including all attachments in its Proposal by so indicating in the proposal that the addendum has been received. Proposals submitted without acknowledgement of receipt of this addendum may be considered non-conforming.

The following forms provided within the RFP Document should be included in submitted proposal:

- **Attachment B – General Declarations**
- **Attachment D - Prevailing Wage Declaration of Compliance**
- **Attachment E - Living Wage Declaration of Compliance**
- **Attachment G - Vendor Conflict of Interest Disclosure Form**
- **Attachment H - Non-Discrimination Declaration of Compliance**

Proposals that fail to provide these completed forms listed above upon proposal opening may be rejected as non-responsive and may not be considered for award.

I. CORRECTIONS/ADDITIONS/DELETIONS

Changes to the RFP documents which are outlined below are referenced to a page or Section in which they appear conspicuously. Offerors are to take note in its review of the documents and include these changes as they may affect work or details in other areas not specifically referenced here.

Section/Page(s)	Change
Schedule of Pricing / Cost	Schedule of Pricing/ Cost has been replaced in its entirety. Changes include: Revised sidewalk and pavement quantities.
Plan Sheets 11 to 16	Plan sheets have been replaced in their entirety. Changes include: Reconciled missing sidewalk/pavement callouts and quantities to reflect overall scope of work. Extent of work is unchanged.

Offerors are responsible for any conclusions that they may draw from the information contained in the Addendum.

E. Schedule of Pricing/Cost – 20 Points**Company:****Project: Ann Street Improvements****File #: 2022-025****RFP #: 26-03**

ITEM NUMBER	LEGEND	UNIT	ESTIMATED QUANTITY	UNIT PRICE	TOTAL PRICE
General					
01000.00	General Conditions, Max. \$500,000	LSUM	1	\$	\$
01001.00	Project Supervision, Max. \$250,000	LSUM	1	\$	\$
01002.00	Project Clean-Up and Restoration	LSUM	1	\$	\$
01003.00	Digital Audio Visual Coverage	LSUM	1	\$	\$
01004.00	Allowance for Unforeseen Conditions	Dlr	50,000	\$	\$
01021.00	Erosion Control, Inlet Protection, Fabric Drop	Ea	66	\$	\$
01030.00	Tree Protection Fence	Ft	250	\$	\$
01040.00	Minor Traffic Control, Max. \$50,000	LSUM	1	\$	\$
01050.00	Sign, Type B, Temp, Prismatic, Furn & Oper	Sft	2,107	\$	\$
01051.00	Sign, Type B, Temp, Prismatic, Special, Furn & Oper	Sft	1,363	\$	\$
01052.00	Temporary "No Parking" Sign	Ea	50	\$	\$
01061.00	Lighted Arrow, Type B, Furn & Oper	Ea	1	\$	\$
01070.00	Sign, Portable, Changeable Message, Furn & Oper	Ea	4	\$	\$
01080.00	Plastic Drum, High Intensity, Lighted, Furn & Oper	Ea	20	\$	\$
01081.00	Channelizer Cone, High Intensity, 42 In., Furn & Oper	Ea	250	\$	\$
01092.00	Barricade, Type III, High Intensity, Double Sided, Lighted, Furn & Oper	Ea	10	\$	\$
01100.00	Pedestrian Type II Barricade, Temp, Furn & Oper	Ea	100	\$	\$
01101.00	Pedestrian Channelizer Device, Furn & Oper	Ea	350	\$	\$
01102.00	Temporary Pedestrian Ramp, Furn & Oper	Ea	10	\$	\$
01103.00	Temporary Pedestrian Mat, Furn & Oper	Ft	300	\$	\$
01160.71	DS_Sign, Type III, Rem	Ea	18	\$	\$
01160.72	DS_Fdn, Perforated Steel Square Tube Breakaway System, Rem	Ea	39	\$	\$
01160.73	DS_Ground Mtd Sign Support, Rem	Ea	38	\$	\$
01160.75	DS_Sign, Type IIIB, Modified	Sft	99	\$	\$
01160.77	DS_Perforated Steel Square Tube Breakaway System, Modified	Ea	39	\$	\$
01160.78	DS_Post, Steel, 3 Lb.	Ft	128	\$	\$
01170.81	DS_Parking Meter, Rem	Ea	37	\$	\$
01170.82	DS_Parking Meter, Install	Ea	37	\$	\$
Removals					
02000.01	Tree, Rem, 6 In. - 12 In.	Ea	16	\$	\$
02000.02	Tree, Rem, 13 In. - 19 In.	Ea	2	\$	\$
02021.00	HMA Surface, Rem	Syd	245	\$	\$
02025.00	Concrete Pavt, Any Thickness, Rem	Syd	7,138	\$	\$
02030.00	Curb, Gutter, and Curb and Gutter, Any Type, Rem	Ft	2,634	\$	\$
02040.00	Sidewalk, Sidewalk Ramp, and Driveway Approach, Any Thickness, Rem	Sft	15,039	\$	\$
02050.00	Sign, Rem, Salv	Ea	97	\$	\$
Earthwork					
03000.00	Machine Grading, _____, Modified	Sta	13.75	\$	\$
03022.00	Subgrade Undercutting, Type III	Cyd	100	\$	\$
03030.01	Exploratory Excavation, SD-TD-1, (0-10' Deep)	Ea	12	\$	\$
Sanitary Sewer					
04014.01	6 In., SDR 26 PVC Sanitary Service Lead, SD-TD-2	Ft	100	\$	\$
04061.00	Sanitary Structure Cover, Adjust	Ea	7	\$	\$
TOTAL THIS PAGE (BF-1)					\$

E. Schedule of Pricing/Cost – 20 Points**Company:****Project: Ann Street Improvements****File #: 2022-025****RFP #: 26-03**

ITEM NUMBER	LEGEND	UNIT	ESTIMATED QUANTITY	UNIT PRICE	TOTAL PRICE
Storm and Drainage					
06000.01	12 In., CL IV RCP Storm Sewer, SD-TD-1	Ft	758	\$	\$
06000.03	18 In., CL IV RCP Storm Sewer, SD-TD-1	Ft	185	\$	\$
06000.05	24 In., CL IV RCP Storm Sewer, SD-TD-1	Ft	41	\$	\$
06003.01	6 In., PE Storm Sewer, SD-TD-2	Ft	12	\$	\$
06003.06	18 In., PE Storm Sewer, SD-TD-2	Ft	138	\$	\$
06030.01	Storm Sewer Tap, 6 In. Dia.	Ea	3	\$	\$
06030.04	Storm Sewer Tap, 12 In. Dia.	Ea	7	\$	\$
06030.06	Storm Sewer Tap, 18 In. Dia.	Ea	1	\$	\$
06030.08	Storm Sewer Tap, 24 In. Dia.	Ea	4	\$	\$
06050.01	Storm Manhole, 48 In. Dia. (0-8' deep)	Ea	7	\$	\$
06050.02	Storm Manhole, 48 In. Dia., Additional Depth	Ft	4	\$	\$
06050.03	Storm Manhole, 60 In. Dia. (0-8' deep)	Ea	4	\$	\$
06050.04	Storm Manhole, 60 In. Dia., Additional Depth	Ft	4	\$	\$
06060.03	Storm Inlet-Junction, 48 In. Dia., (0-8' deep)	Ea	5	\$	\$
06060.04	Storm Inlet-Junction, 48 In. Dia., Additional Depth	Ft	3	\$	\$
06060.05	Storm Inlet- Junction, 60 In. Dia., (0-8' deep)	Ea	1	\$	\$
06060.06	Storm Inlet-Junction, 60 In. Dia., Additional Depth	Ft	1	\$	\$
06070.01	Storm Single Inlet, 24 In. Dia., (0-8' deep)	Ea	3	\$	\$
06090.01	Storm Manhole with Weir, 72 In. Dia., (0-8' deep)	Ea	2	\$	\$
06090.02	Storm Manhole with Weir, 72 In. Dia., Additional Depth	Ft	1	\$	\$
06091.01	DS_Storm Manhole, 48 In. Dia., with Leaching Base (0-10' deep)	Ea	5	\$	\$
06091.02	DS_Storm Single Inlet, 24 In. Dia., with Leaching Base (0-10' deep)	Ea	12	\$	\$
06110.03	Storm Sewer Pipe, 12 In. Dia., Abandon	Ft	186	\$	\$
06110.05	Storm Sewer Pipe, 18 In. Dia., Abandon	Ft	280	\$	\$
06120.03	Storm Sewer Pipe, 12 In. Dia., Rem	Ft	559	\$	\$
06120.05	Storm Sewer Pipe, 18 In. Dia., Rem	Ft	415	\$	\$
06120.07	Storm Sewer Pipe, 24 In. Dia., Rem	Ft	23	\$	\$
06140.00	Storm Sewer Structure, Rem	Ea	22	\$	\$
06160.01	Storm Structure Cover	Ea	13	\$	\$
06160.02	Storm Structure Cover, Adjust	Ea	89	\$	\$
06180.02	Underdrain, Subgrade, 6 In.	Ft	100	\$	\$
06220.01	DS_Infiltration Trench	Ft	490	\$	\$
Water Mains					
07000.01	4 In., PC 350 DIP w/polywrap, SD-TD-1	Ft	101	\$	\$
07000.02	6 In., PC 350 DIP w/polywrap, SD-TD-1	Ft	126	\$	\$
07000.03	8 In., PC 350 DIP w/polywrap, SD-TD-1	Ft	36	\$	\$
07000.05	12 In., PC 350 DIP w/polywrap, SD-TD-1	Ft	1,585	\$	\$
07001.01	16 In., PC 250 DIP w/polywrap, SD-TD-1	Ft	195	\$	\$
07010.02	6 In. 45° DIP Bend	Ea	14	\$	\$
07011.01	8 In. 90° DIP Bend	Ea	2	\$	\$
07011.02	8 In. 45° DIP Bend	Ea	2	\$	\$
07013.01	12 In. 90° DIP Bend	Ea	4	\$	\$
07013.02	12 In. 45° DIP Bend	Ea	54	\$	\$
07013.03	12 In. 22.5° DIP Bend	Ea	2	\$	\$
07013.04	12 In. 11.25° DIP Bend	Ea	2	\$	\$
TOTAL THIS PAGE (BF-2)					\$

E. Schedule of Pricing/Cost – 20 Points**Company:****Project: Ann Street Improvements****File #: 2022-025****RFP #: 26-03**

ITEM NUMBER	LEGEND	UNIT	ESTIMATED QUANTITY	UNIT PRICE	TOTAL PRICE
Water Mains (Continued)					
07014.01	16 In. 90° DIP Bend	Ea	4	\$	\$
07014.02	16 In. 45° DIP Bend	Ea	8	\$	\$
07016.02	DS_4 In. 45° DIP Bend	Ea	6	\$	\$
07020.03	8 In. X 6 In. DIP Reducer	Ea	3	\$	\$
07020.07	12 In. X 4 In. DIP Reducer	Ea	1	\$	\$
07020.08	12 In. X 6 In. DIP Reducer	Ea	4	\$	\$
07020.09	12 In. X 8 In. DIP Reducer	Ea	2	\$	\$
07020.14	16 In. X 12 In. DIP Reducer	Ea	2	\$	\$
07020.30	DS_16 in. x 14 in. DIP Reducer	Ea	2	\$	\$
07030.11	12 In. X 12 In. X 4 In. DIP Tee	Ea	4	\$	\$
07030.12	12 In. X 12 In. X 6 In. DIP Tee	Ea	4	\$	\$
07030.13	12 In. X 12 In. X 8 In. DIP Tee	Ea	2	\$	\$
07030.15	12 In. X 12 In. X 12 In. DIP Tee	Ea	6	\$	\$
07030.17	16 In. X 16 In. X 8 In. DIP Tee	Ea	1	\$	\$
07030.18	16 In. X 16 In. X 12 In. DIP Tee	Ea	1	\$	\$
07030.20	16 In. X 16 In. X 16 In. DIP Tee	Ea	2	\$	\$
07050.01	Gate Valve in Box, 6 In.	Ea	5	\$	\$
07050.04	Gate Valve in Box, 12 In.	Ea	3	\$	\$
07050.05	Gate Valve in Box, 16 In.	Ea	2	\$	\$
07050.11	DS_Gate Valve in Box, 4 In.	Ea	4	\$	\$
07051.01	DS_PCCP Gate Valve in Box, 12 In.	Ea	1	\$	\$
07060.04	Gate Valve in Well, 12 In.	Ea	7	\$	\$
07080.00	Excavate & Backfill For Water Service Tap and Lead	Ft	132	\$	\$
07091.00	Water Structure Cover, Adjust	Ea	1	\$	\$
07100.00	Fire Hydrant Assembly, Complete	Ea	3	\$	\$
07102.00	Fire Hydrant Assembly, Rem	Ea	3	\$	\$
07110.01	Sacrificial Anode, 17-pound	Ea	9	\$	\$
07110.02	Sacrificial Anode, 32-pound	Ea	2	\$	\$
07120.00	Gate Box, Adjust	Ea	6	\$	\$
07130.01	Temporary Water Main Line Stop, 8 In. or less	Ea	13	\$	\$
07130.08	DS_Temporary Water Main Line Stop, 14 In.	Ea	1	\$	\$
07131.00	Temporary Water Main Line Stop, Additional Rental Day	Ea	6	\$	\$
07140.02	Water Main Pipe, 6 In. Dia., Abandon	Ft	1,525	\$	\$
07140.06	Water Main Pipe, 14 In. Dia., Abandon	Ft	131	\$	\$
07150.02	Water Main Pipe, 6 In. Dia., Rem	Ft	180	\$	\$
07150.03	Water Main Pipe, 8 In. Dia., Rem	Ft	40	\$	\$
07150.05	Water Main Pipe, 12 In. Dia., Rem	Ft	25	\$	\$
07150.06	Water Main Pipe, 14 In. Dia., Rem	Ft	25	\$	\$
07170.02	Gate Valve in Box, 6 In. Dia., Rem	Ea	4	\$	\$
07170.03	Gate Valve in Box, 8 In. Dia., Rem	Ea	2	\$	\$
07180.02	Gate Valve in Well, 6 In. Dia., Abandon	Ea	2	\$	\$
07190.02	Gate Valve in Well, 6 In. Dia., Rem	Ea	2	\$	\$
07200.01	DS_Insulation Board, 2-inch	Sft	240	\$	\$
Streets, Driveways, & Sidewalks					
08000.00	Subbase, CIP	Cyd	445	\$	\$
TOTAL THIS PAGE (BF-3)					\$

E. Schedule of Pricing/Cost – 20 Points**Company:****Project: Ann Street Improvements****File #: 2022-025****RFP #: 26-03**

ITEM NUMBER	LEGEND	UNIT	ESTIMATED QUANTITY	UNIT PRICE	TOTAL PRICE
Streets, Driveways, & Sidewalks (Continued)					
08010.02	Aggregate Base, 4 In., 21AA, CIP	Syd	12	\$	\$
08010.03	Aggregate Base, 6 In., 21AA, CIP	Syd	1,590	\$	\$
08010.03	Aggregate Base, 8 In., 21AA, CIP	Syd	7,370	\$	\$
08050.00	Geotextile Separator Fabric	Syd	314	\$	\$
08051.00	Geotextile Stabilization Fabric	Syd	112	\$	\$
08070.11	HMA, 3EML	Ton	931	\$	\$
08070.15	HMA, 4EML	Ton	630	\$	\$
08070.19	HMA, 5EML	Ton	740	\$	\$
08110.00	Conc, Curb or Curb & Gutter, All Types	Ft	2,167	\$	\$
08120.01	Conc, Driveway Opening, Type M	Ft	855	\$	\$
08130.01	Conc, Sidewalk, 4 In.	Sft	540	\$	\$
08131.01	Conc, Sidewalk, Drive Approach, or Ramp, 6 In.	Sft	4,914	\$	\$
08131.02	Conc, Sidewalk, Drive Approach, or Ramp, 8 In.	Sft	15,351	\$	\$
08132.01	Conc, Sidewalk, Drive Approach, or Ramp, 6 In., High Early	Sft	100	\$	\$
08132.02	Conc, Sidewalk, Drive Approach, or Ramp, 8 In., High Early	Sft	100	\$	\$
08140.01	Brick Pavers, Sidewalk, Rem and Reinstall	Sft	705	\$	\$
08140.01	DS_Perforated Concrete Base, 6 In.	Sft	2,826	\$	\$
08140.02	DS_Brick Pavers, New	Sft	2,826	\$	\$
08140.03	DS_Salvaged Brick Pavers	Sft	90	\$	\$
08150.00	Detectable Warning Surface	Ft	180	\$	\$
08151.00	DS_Tactile Directional Indicator	Ft	128	\$	\$
08150.00	DS_Pavt Mrkg, Polymer Cement Surface, Bike Lane, Green	Sft	72	\$	\$
08200.07	Pavt Mrkg, Polyurea, 12 In., Crosswalk	Ft	1,224	\$	\$
08200.09	Pavt Mrkg, Polyurea, 24 In., Stop Bar	Ft	264	\$	\$
08200.11	Pavt Mrkg, Polyurea, 4 In., White	Ft	50	\$	\$
08200.12	Pavt Mrkg, Polyurea, 4 In., Yellow	Ft	2,112	\$	\$
08200.13	Pavt Mrkg, Polyurea, 6 In., White	Ft	48	\$	\$
08251.00	Recessing Pavt Mrkg, Longit	Ft	2,112	\$	\$
08252.00	Recessing Pavt Mrkg, Transv	Sft	496	\$	\$
08300.00	Monument Box, Adjust	Ea	1	\$	\$
Lighting and Electrical					
09000.02	Conductors, No. 6AWG	Ft	4,363	\$	\$
09011.01	Conduit, Schedule 80 PVC, 2 In., Qty 2	Ft	1,570	\$	\$
09030.01	Handhole Assembly, 17 In. X 30 In. x 18 In.	Ea	13	\$	\$
09030.01	DS_Handhole, Adjust	Ea	10	\$	\$
09040.03	DS_Electrical Cabinet	Ea	2	\$	\$
09050.00	Foundation, Light Pole	Ea	13	\$	\$
09060.00	Foundation, Light Pole, Rem	Ea	2	\$	\$
09090.01	Light Pole, DDA	Ea	17	\$	\$
09112.01	Light Fixture, Decorative Globe	Ea	24	\$	\$
Landscaping					
10000.02	Tree, Large, B&B	Ea	19	\$	\$
10010.03	Plant, Gal	Ea	1,230	\$	\$
10040.00	Landscape Maintenance and Warranty, 1 Year	LS	1	\$	\$
10060.00	Turf Restoration	Syd	347	\$	\$
10051.01	DS_Irrigation System	LS	1	\$	\$
TOTAL THIS PAGE (BF-4)					\$

E. Schedule of Pricing/Cost – 20 Points

Company:


Project: Ann Street Improvements

File #: 2022-025

RFP #: 26-03

ITEM NUMBER	LEGEND	UNIT	ESTIMATED QUANTITY	UNIT PRICE	TOTAL PRICE
Landscaping (Continued)					
10061.00	DS_Planting Soil and Mulch	Cyd	383	\$	\$
10100.01	DS_Bike Hoop, Surface Mount	Ea	14	\$	\$
10100.02	DS_Urban Bench	Ea	2	\$	\$
10100.03	DS_DDA Planter Curb	LF	960	\$	\$
10100.04	DS_Tree Grate, 4 ft. x 8 ft.	Ea	14	\$	\$
10100.05	DS_Trash Receptacle	Ea	4	\$	\$
TOTAL THIS PAGE (BF-5)					\$
TOTAL FROM PAGE BF-1:					\$
TOTAL FROM PAGE BF-2:					\$
TOTAL FROM PAGE BF-3:					\$
TOTAL FROM PAGE BF-4:					\$
TOTAL FROM PAGE BF-5:					\$
TOTAL BASE BID:					\$

\\ohm\dfs\Corporate\Projects\0000_0100\0028220080_Ann_St-Washtenaw_Ave_WM_Designs\Drawings\Civil\Removal\220080Rem.dwg Dwg Created: 26-Jan-26 _a2 standard bw.stb _a2 standard bw.stb
Plot Date: 26-Jan-26

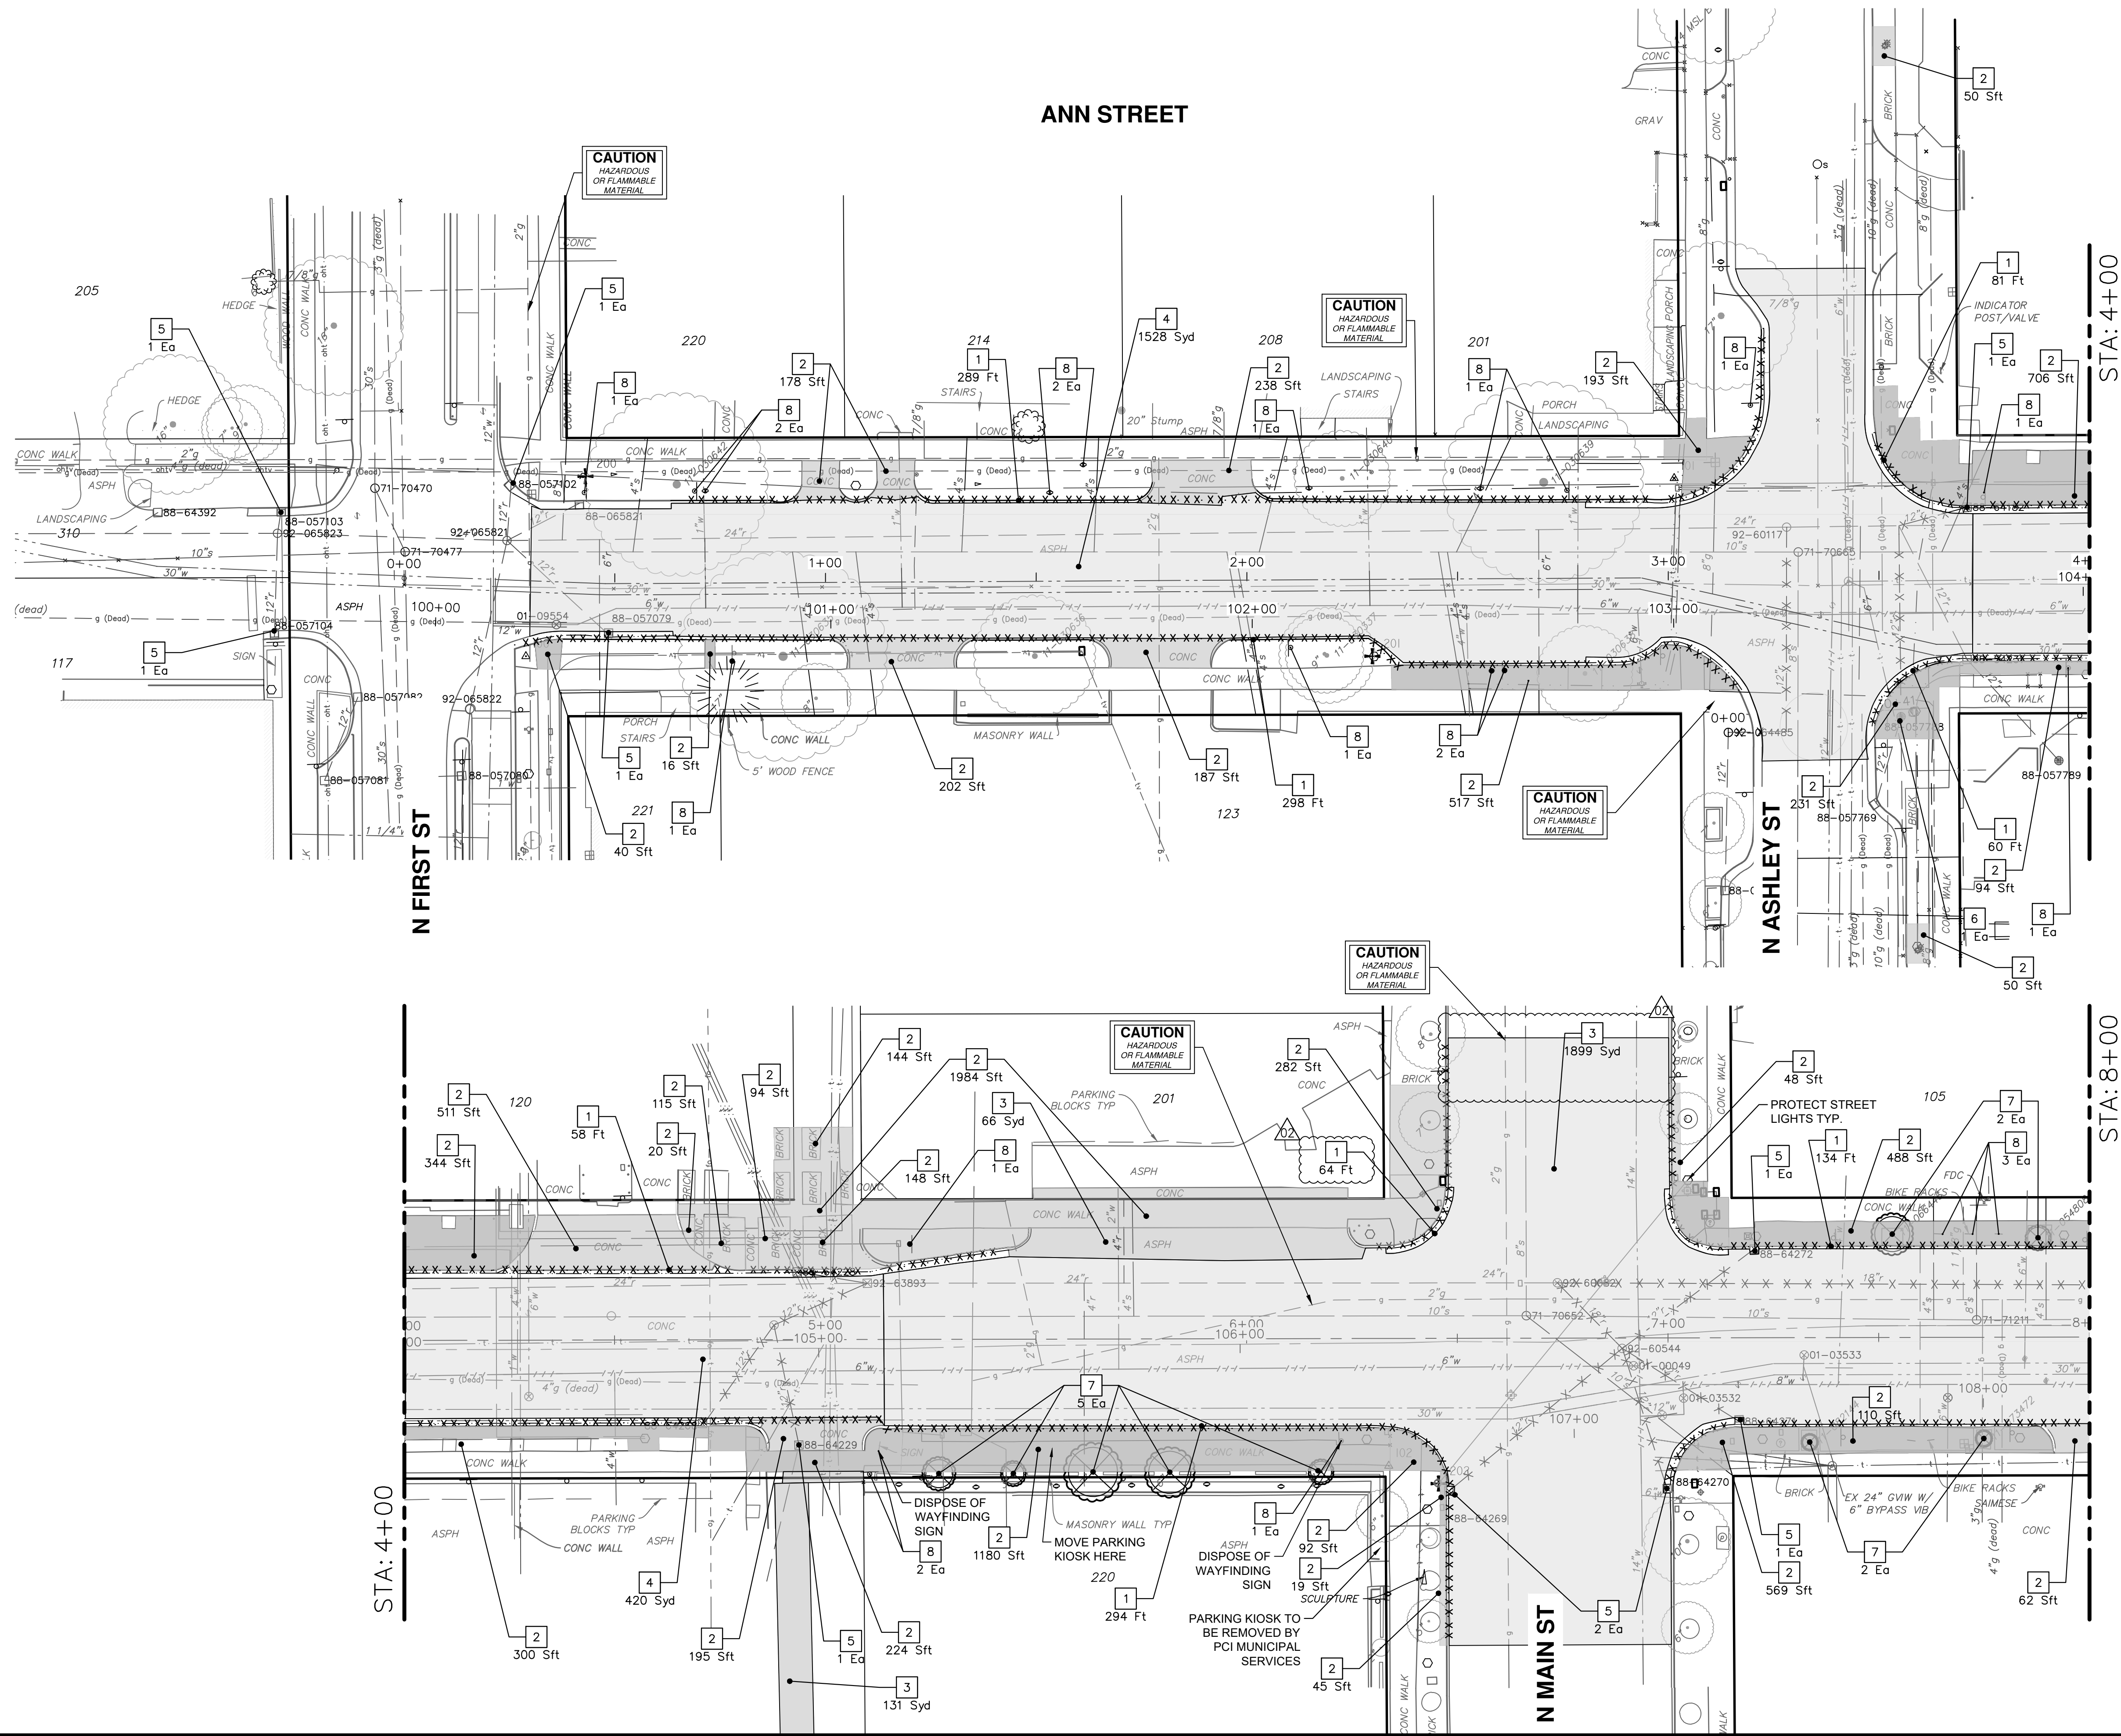

REMOVAL KEY	
KEY	DESCRIPTION
1	REMOVE CONCRETE CURB OR CURB AND GUTTER - ANY TYPE
2	REMOVE CONCRETE SIDEWALK AND DRIVE - ANY THICKNESS *
3	HMA PAVEMENT REMOVAL, ANY DEPTH*
4	CONCRETE PAVEMENT REMOVAL, ANY DEPTH*
5	INLET FILTER
6	N/A
7	REMOVE EXISTING TREE - SIZE VARIES
8	REMOVE AND SALVAGE SIGN, PARKING METER OR BIKE RACK
9	REMOVE BRICK SIDEWALK

- * SAWCUT FULL DEPTH AT REMOVAL LIMITS
- NOTES:
- UTILITY REMOVALS SHOWN ON UTILITY SHEET(S).
 - COMPOSITE PAVEMENT TO BE PAID AS "CONCRETE PAVT, ANY THICKNESS, REM."
 - THE BRICK PAVERS AND CONCRETE PAVER BASE ARE NOT PAID FOR SEPARATELY, BUT ARE TO BE PAID AS "SIDEWALK, SIDEWALK RAMP, AND DRIVEWAY APPROACH, ANY THICKNESS."
 - REMOVAL OF THE HMA OVERLAY ON THE CURB AND GUTTER IS INCLUDED IN THE "CURB AND GUTTER, REM" PAY ITEM.

811

Know what's below. Call before you dig.

CE

AT

SM

SM

DATE

CHECKED

01-26-2026

01-20-2026

12-17-2025

ADDENDUM 4

ADDENDUM 2

BID SET

02

01

00

DESCRIPTION

REV.

CITY OF ANN ARBOR
PUBLIC SERVICES
301 EAST HURON STREET
P.O. BOX 8647
ANN ARBOR MI 48108-8647
www.a2gov.org

CITY OF ANN ARBOR - PUBLIC SERVICES - ENGINEERING

ANN STREET IMPROVEMENTS

REMOVAL PLAN P.O.B. TO STA 8+00


SCALE PLAN: 1" = 20'

PROFILE: 1" = 4'

DRAWING No. 2022-025-11

SHEET No. 11 OF 67



\\ohm\dfs\Corporate\Projects\0000_0100\0028220080_Ann_St-Washtenaw_Ave_WM_Designs\Drawings\Civil\Removal\220080Rem.dwg Dwg Created: 26-Jan-26 - _a2 standard bw.stb - Plot Date: 26-Jan-26

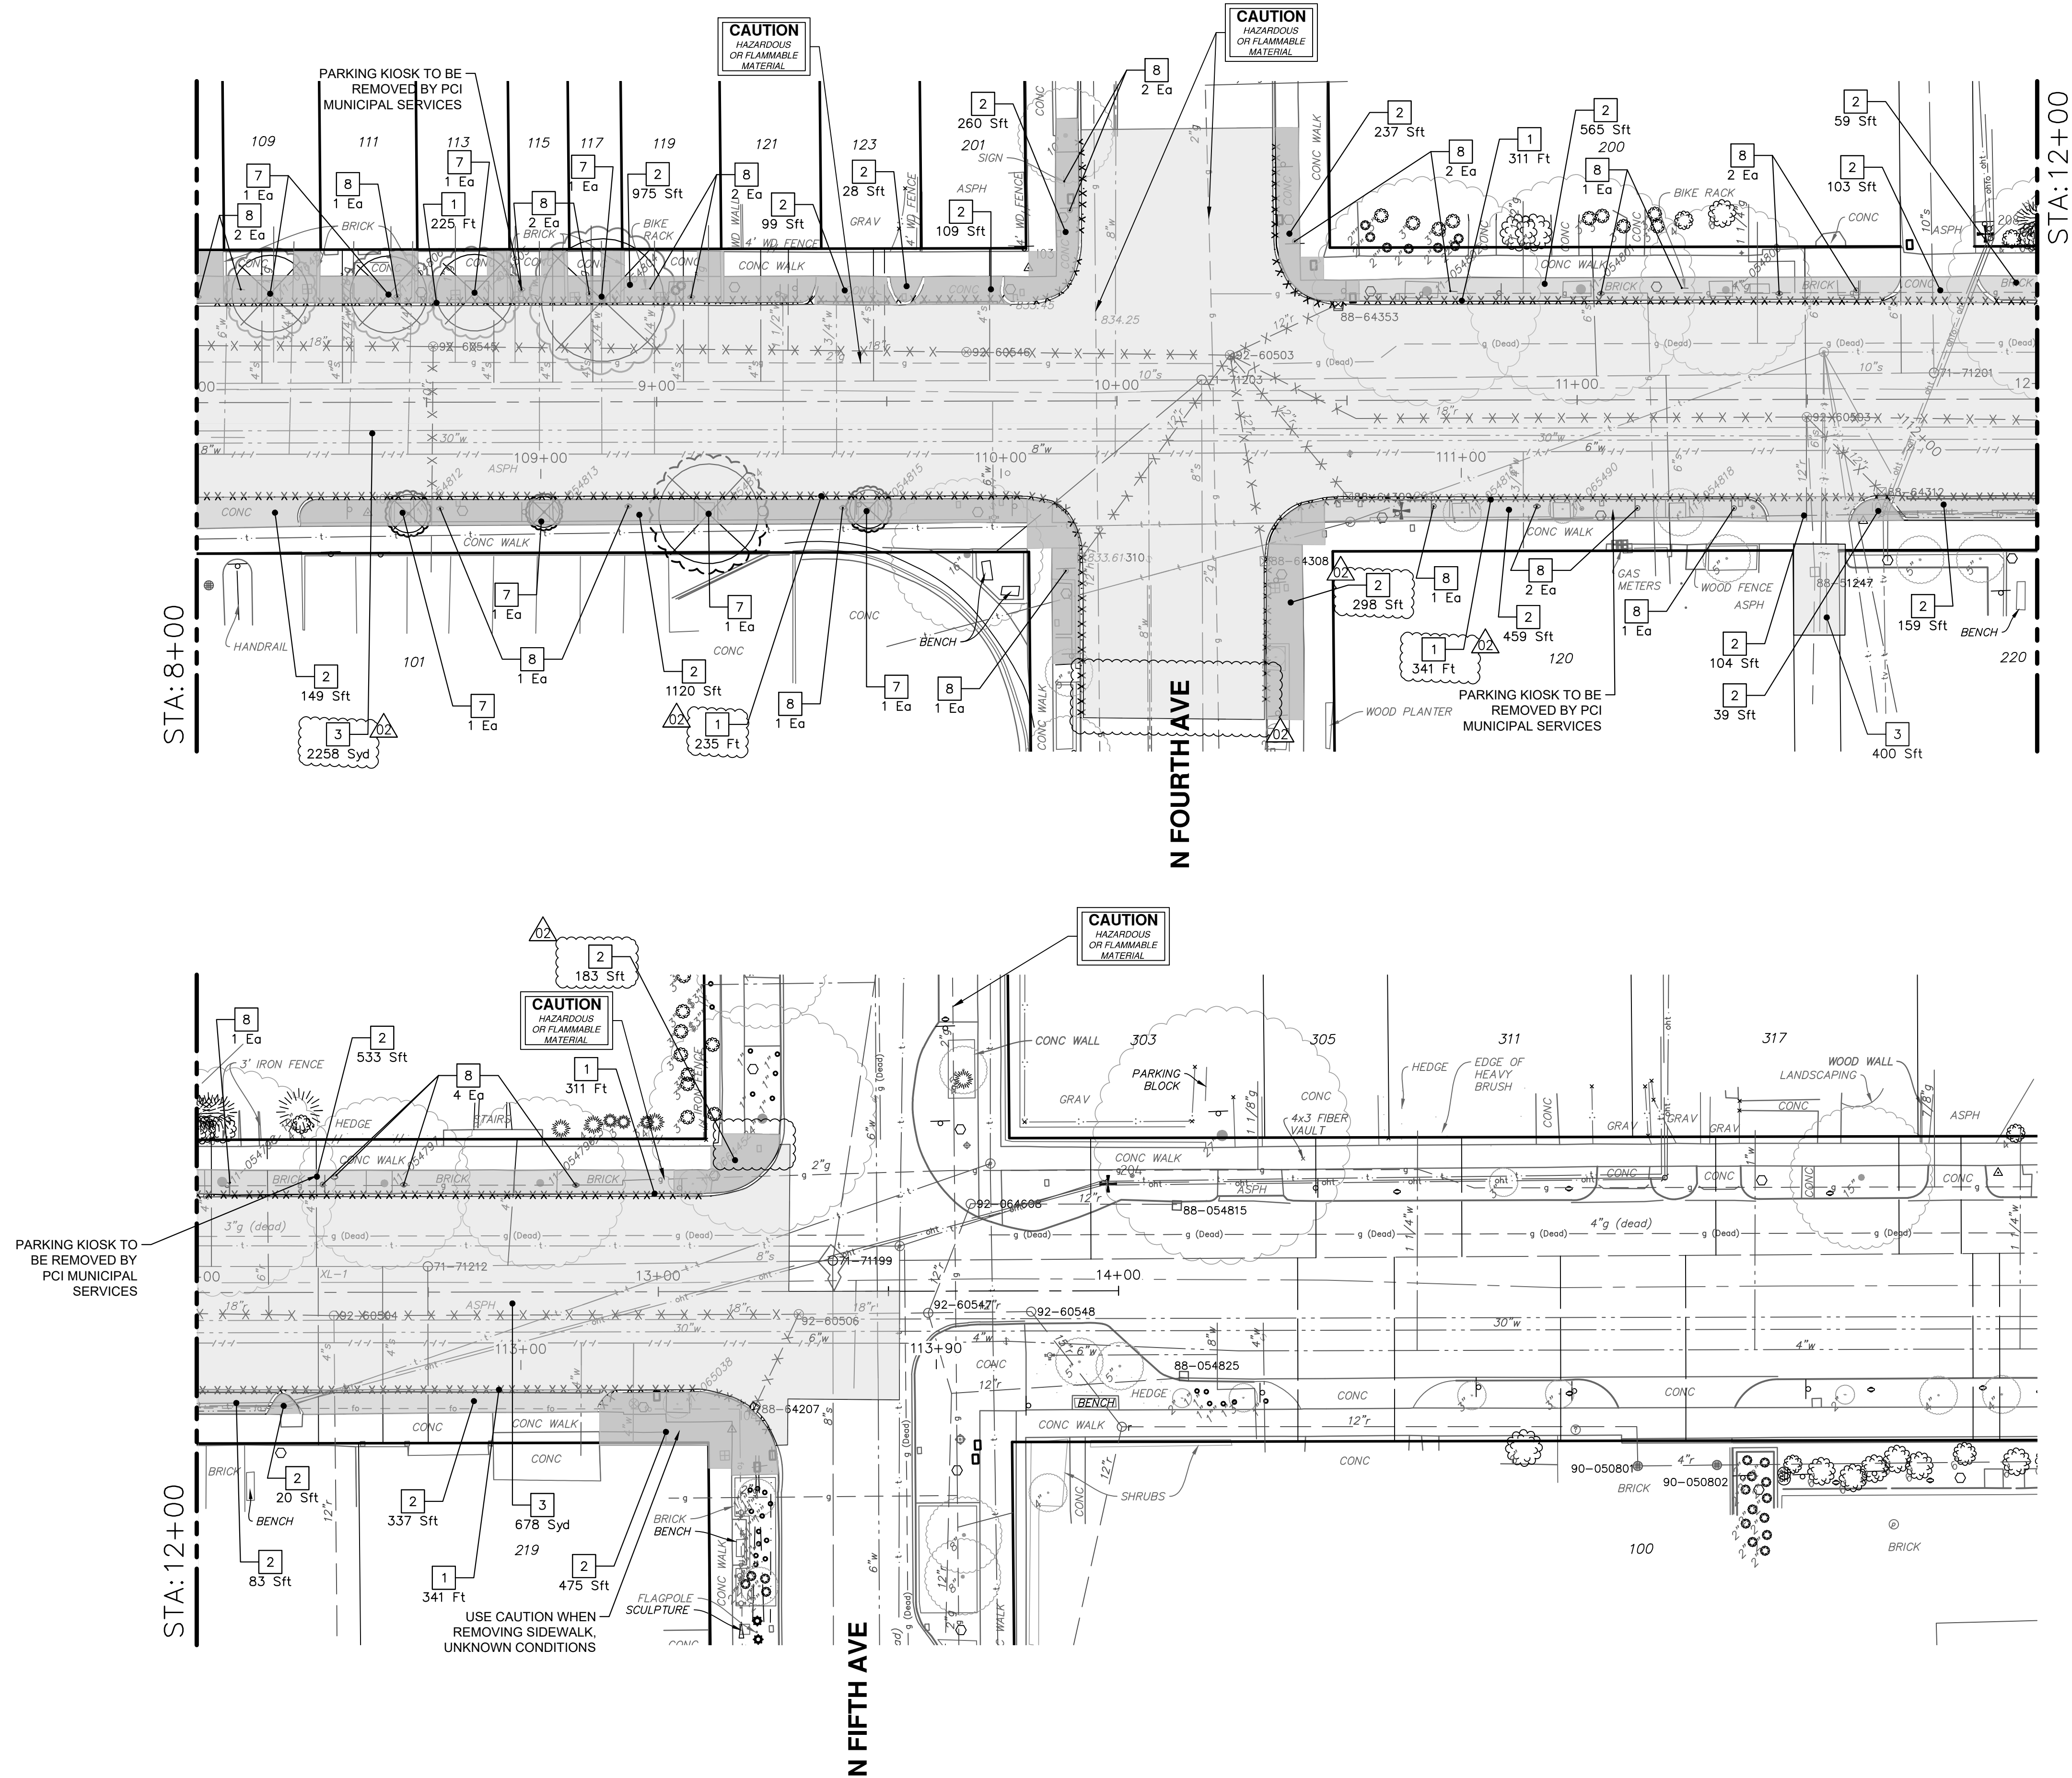


REMOVAL KEY	
KEY	DESCRIPTION
1	REMOVE CONCRETE CURB OR CURB AND GUTTER - ANY TYPE
2	REMOVE CONCRETE SIDEWALK AND DRIVE - ANY THICKNESS *
3	HMA PAVEMENT REMOVAL, ANY DEPTH*
4	CONCRETE PAVEMENT REMOVAL, ANY DEPTH*
5	INLET FILTER
6	N/A
7	REMOVE EXISTING TREE - SIZE VARIES
8	REMOVE AND SALVAGE SIGN, PARKING METER OR BIKE RACK
9	REMOVE BRICK SIDEWALK

- * SAWCUT FULL DEPTH AT REMOVAL LIMITS
- NOTES:
- UTILITY REMOVALS SHOWN ON UTILITY SHEET(S).
 - COMPOSITE PAVEMENT TO BE PAID AS "CONCRETE PAVT, ANY THICKNESS, REM."
 - THE BRICK PAVERS AND CONCRETE PAVER BASE ARE NOT PAID FOR SEPARATELY, BUT ARE TO BE PAID AS "SIDEWALK, SIDEWALK RAMP, AND DRIVEWAY APPROACH, ANY THICKNESS."
 - REMOVAL OF THE HMA OVERLAY ON THE CURB AND GUTTER IS INCLUDED IN THE "CURB AND GUTTER, REM" PAY ITEM.


\\ohm\dfs\Corporate\Projects\0000_0100\0028220080_Ann_St-Washtenaw_Ave_WM_Designs\Drawings\Civil\Plans_Const\220080PPrd.dwg Dwg Created: 26-Jan-26 _a2 standard bw.stb
Plot Date: 26-Jan-26

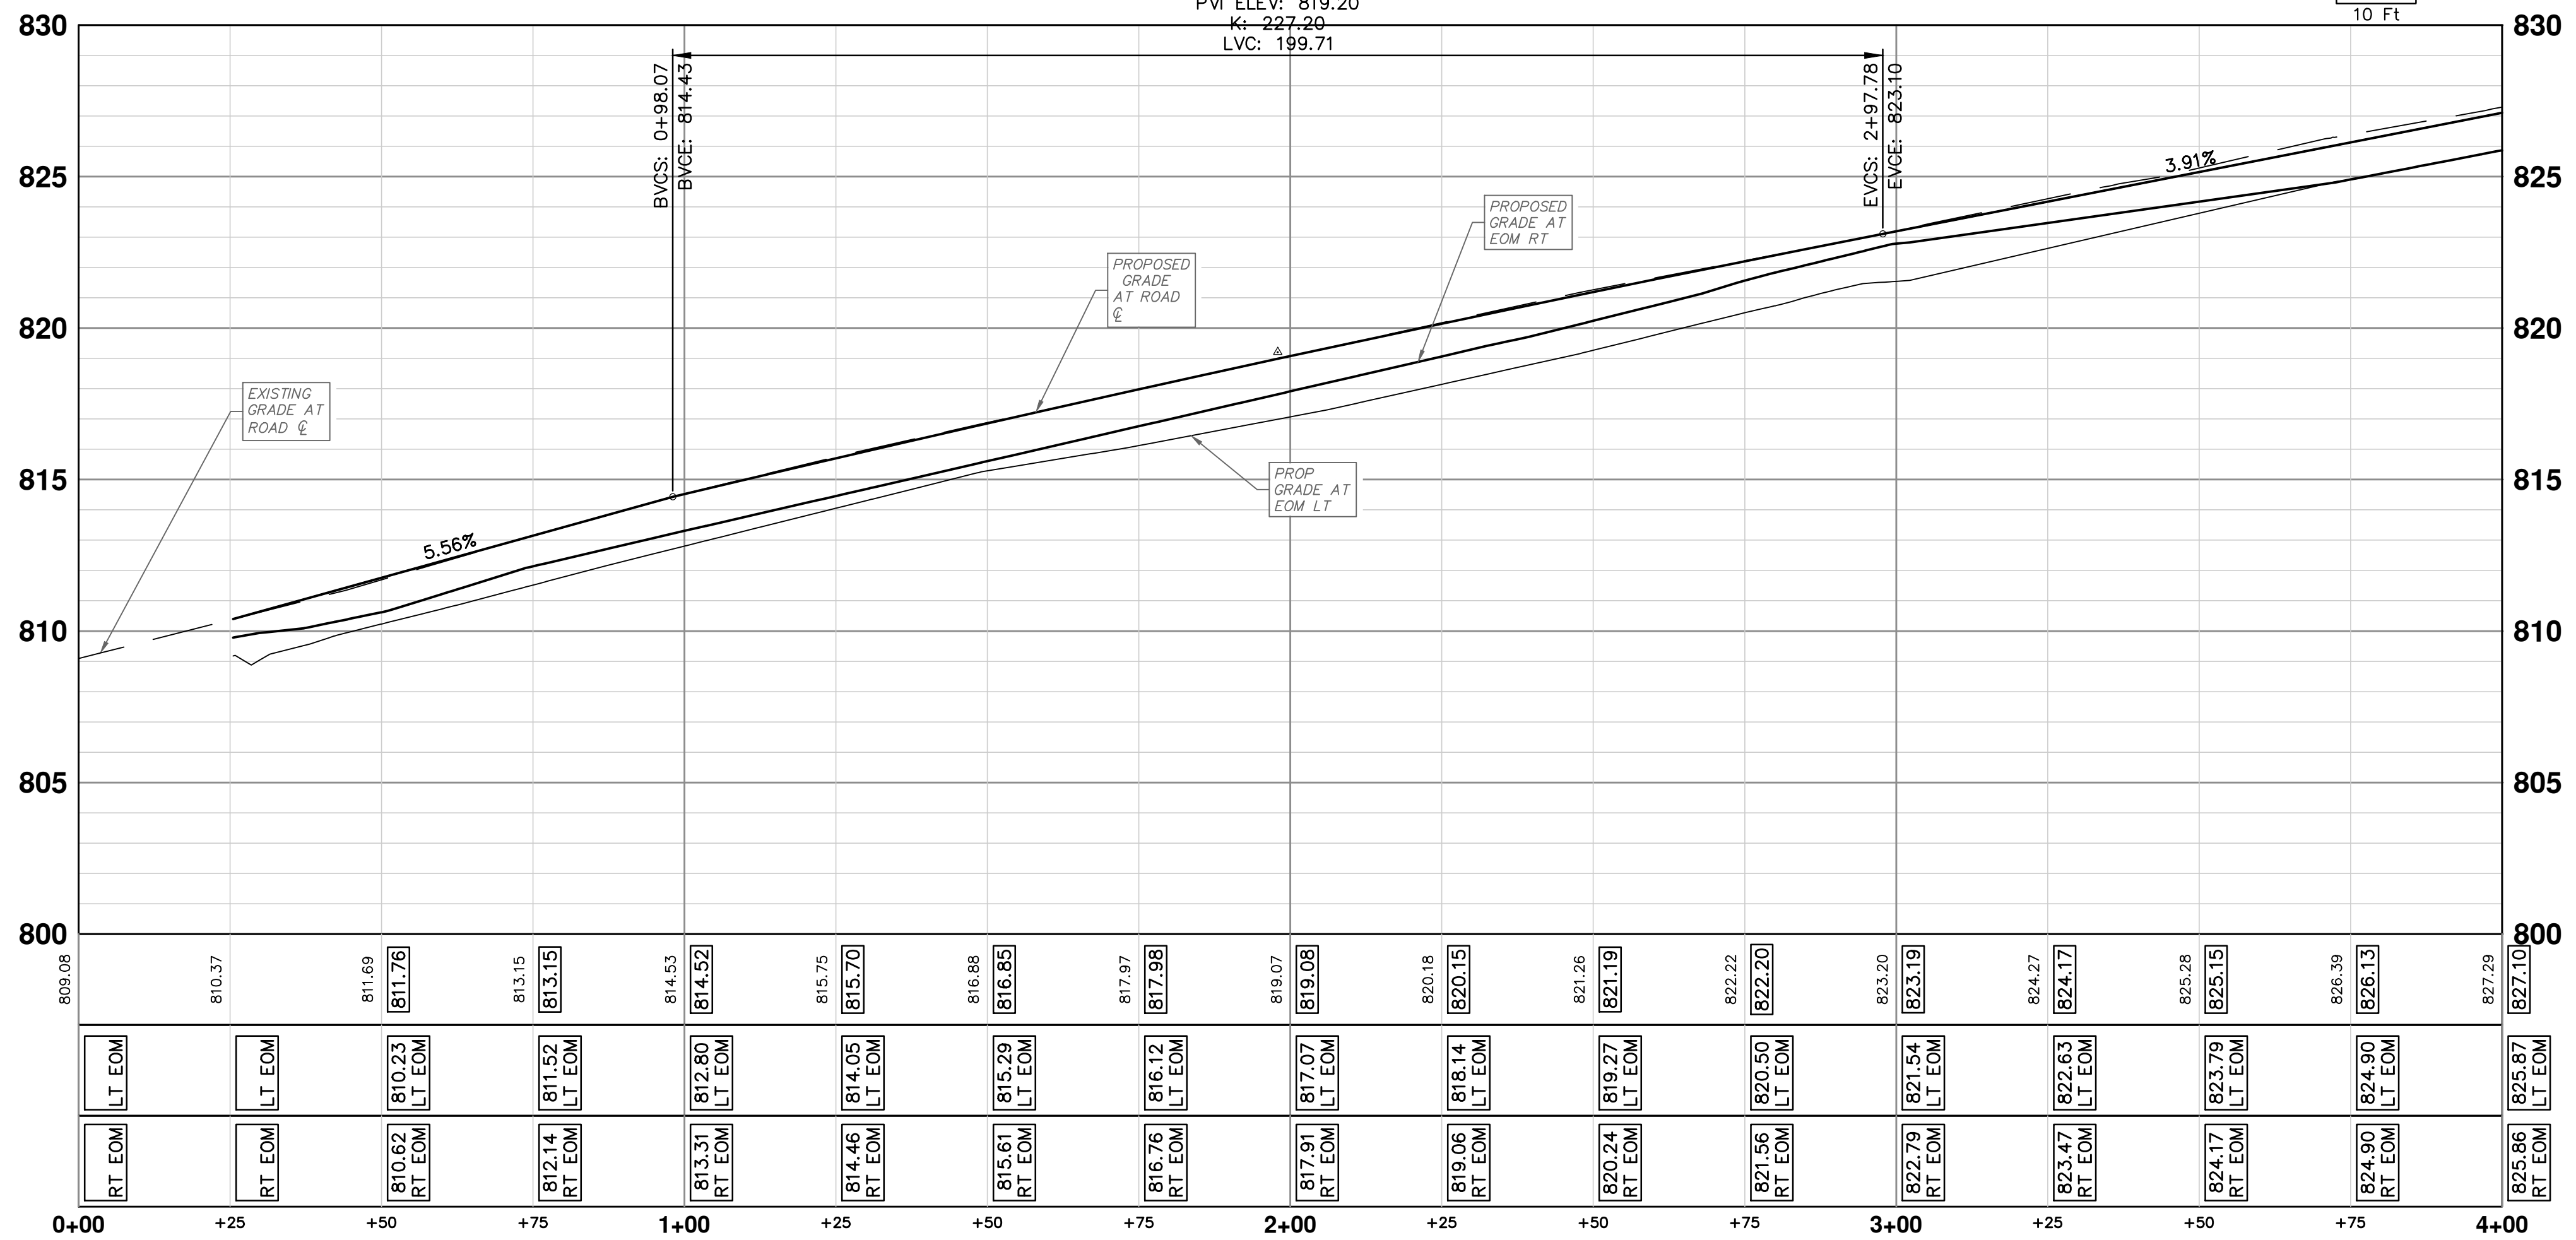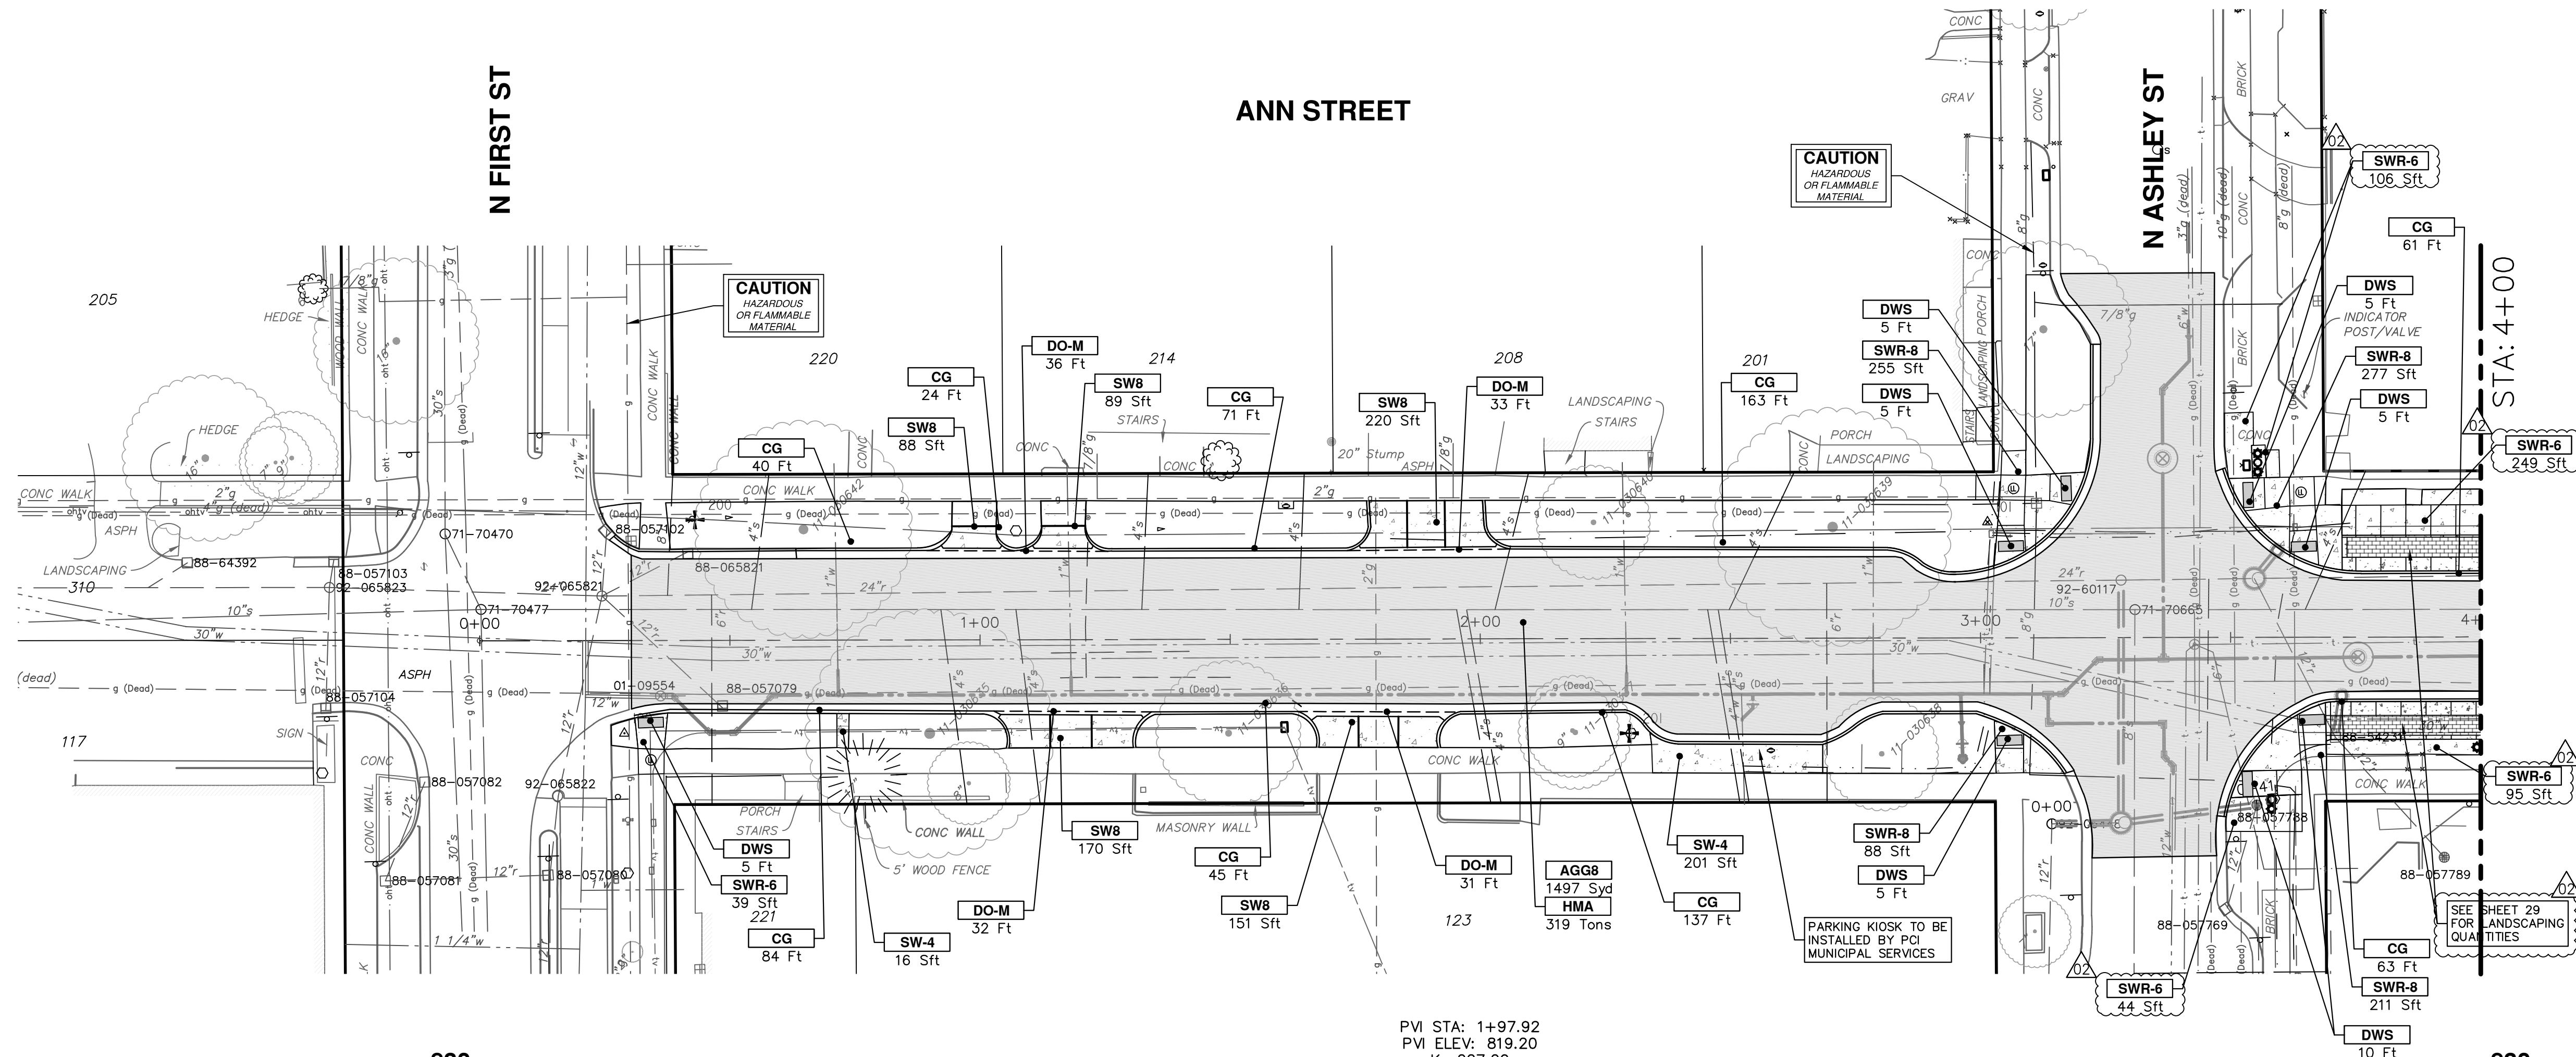


CONSTRUCTION KEY	
KEY	DESCRIPTION
HMA	PLACE HMA, LVSP, PLACE MATERIAL IN LIFTS ACCORDING TO THE TYPICAL SECTION AND AS DIRECTED BY THE ENGINEER.
AGG8	AGGREGATE BASE, 8 IN, 21AA, CIP
HMA APP	PLACE HMA APPROACH
HP	HAND PATCHING
CG	PLACE CURB AND GUTTER, CONC, F4, SPECIAL
DO-M	PLACE DRIVEWAY OPENING, CONC, DETAIL M, P-NC
DC-6	PLACE CONC, DRIVE APPROACH, NON-REINFORCED, P-NC, 6 INCH. PLACE AND COMPACT 6 INCH SUBBASE, CIP, CLASS II GRANULAR MATERIAL, MODIFIED
SW-4	PLACE SIDEWALK, CONC, 4 INCH, MODIFIED
SWR-6	PLACE SIDEWALK, SIDEWALK RAMP, CONC, 6 INCH, MODIFIED
SW8	CONC, SIDEWALK, DRIVE APPROACH OR RAMP, 8 INCH
DWS	DETECTABLE WARNING, CAST IN PLACE
ISW-CB	INTEGRAL SIDEWALK/CURB
ABO	ADJUST BY OTHERS
1	ADJUST GATE VALVE BOX, MONUMENT BOX, OR GAS BOX.
2	ADJUST STRUCTURE COVER

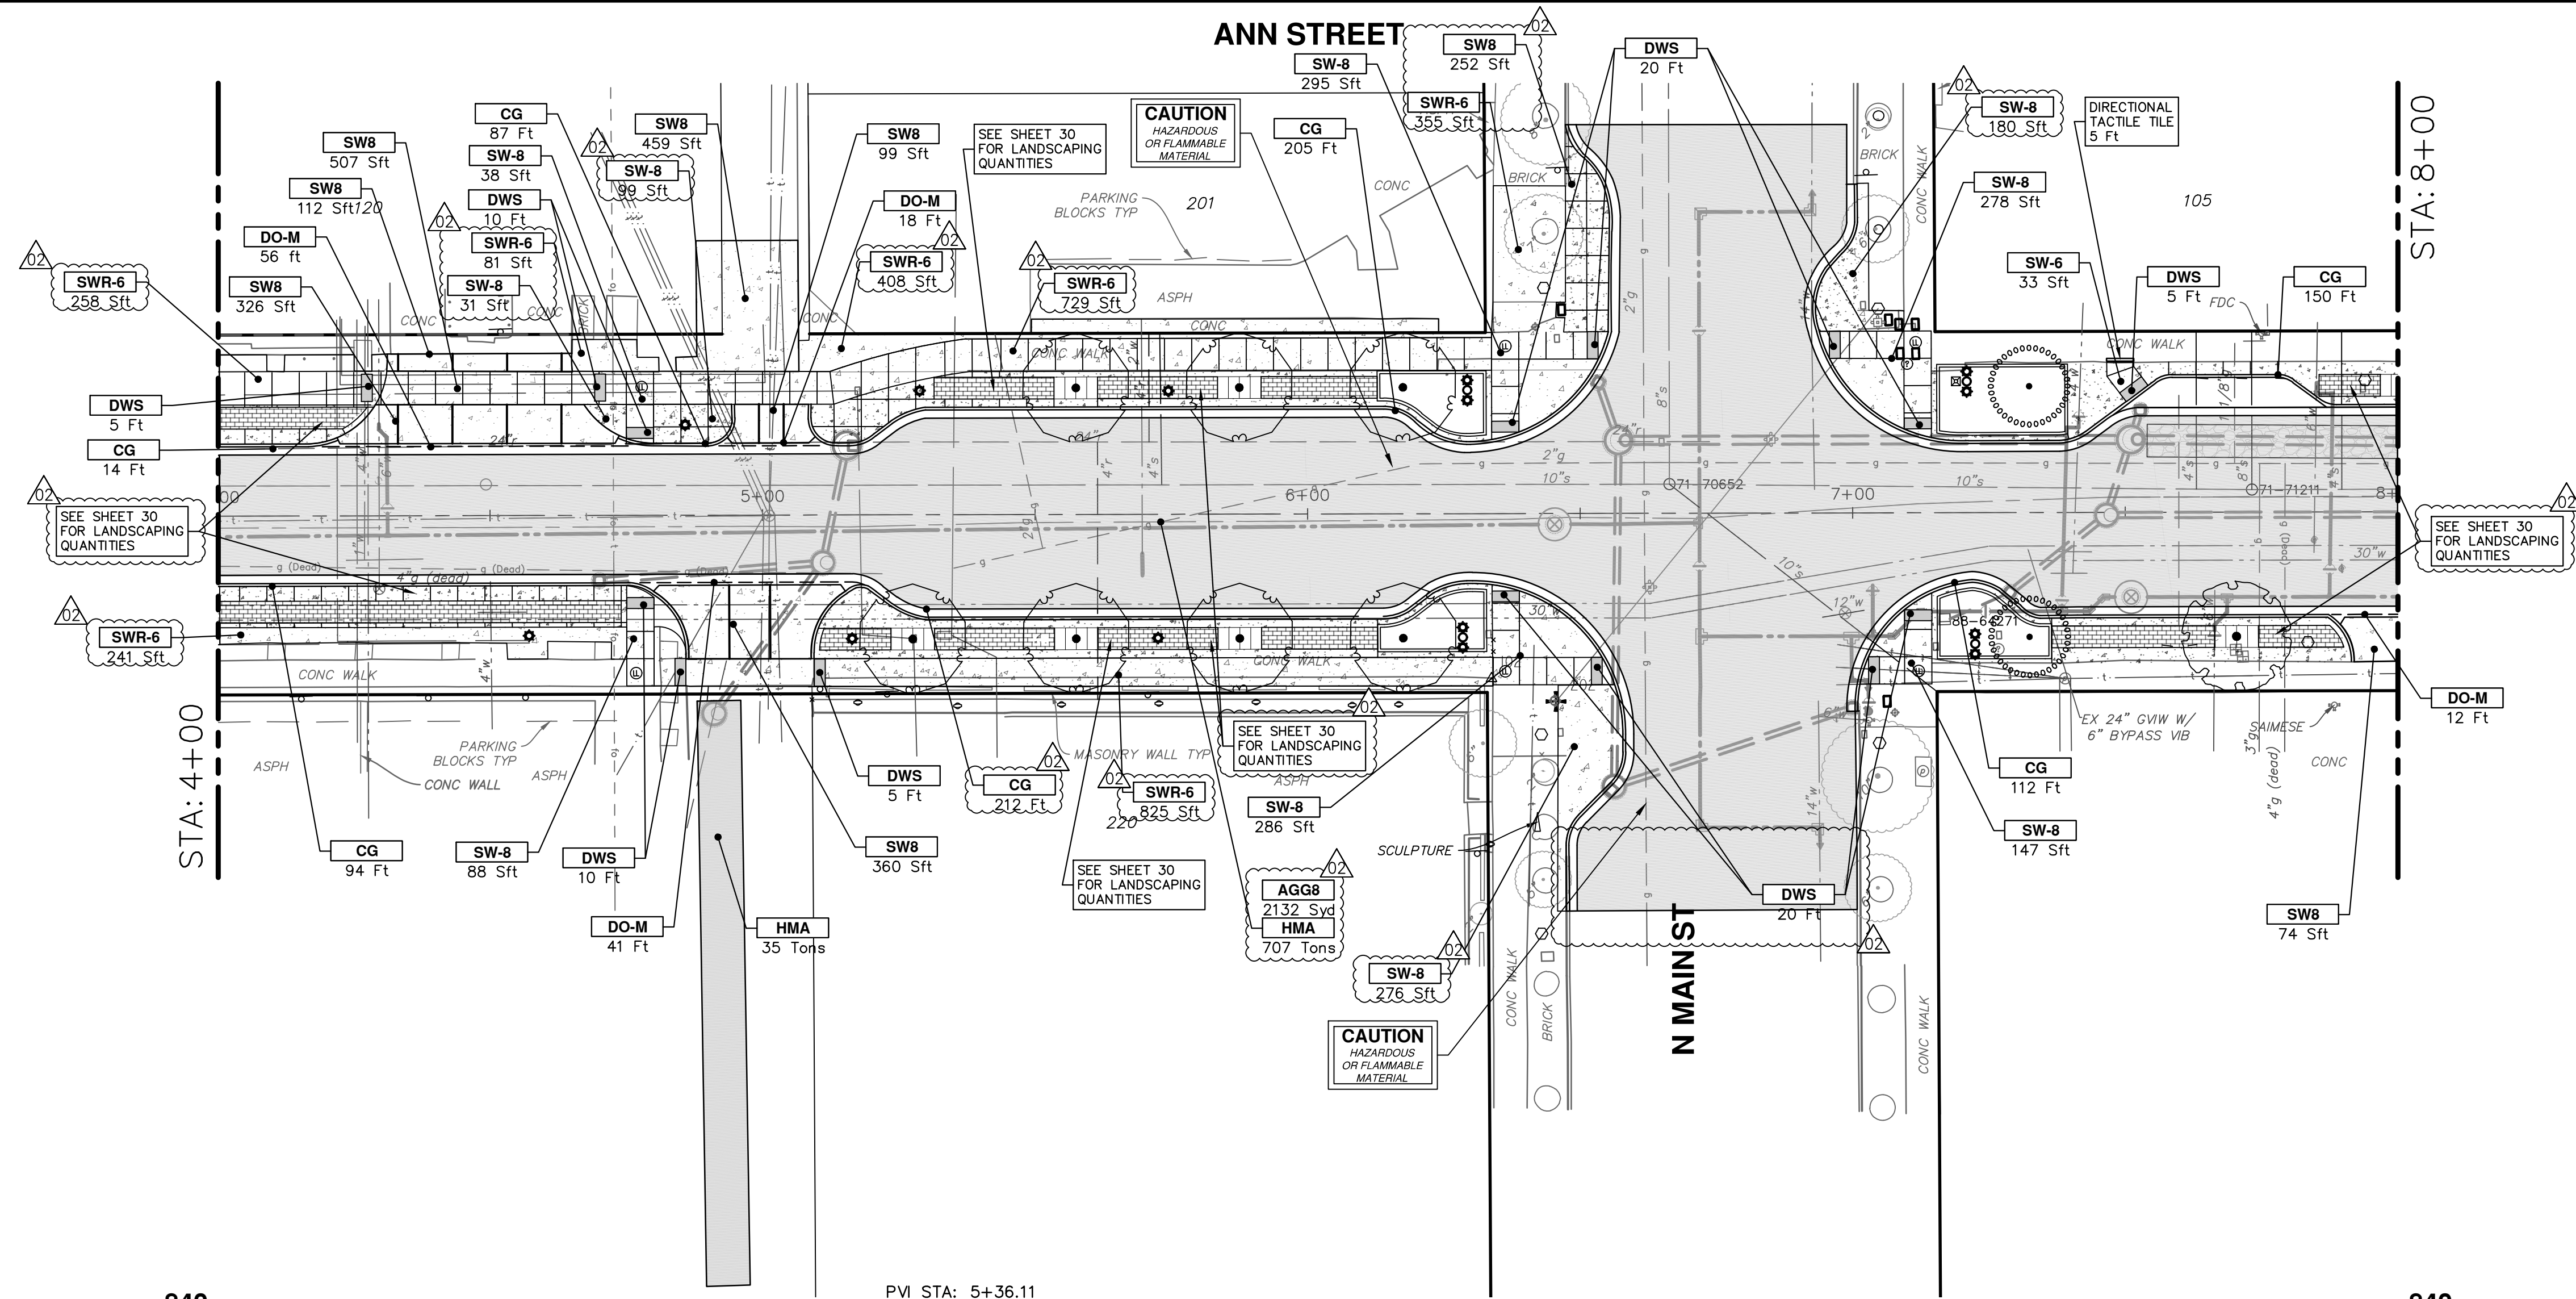



CONSTRUCTION KEY	
KEY	DESCRIPTION
HMA	PLACE HMA, LVSP, PLACE MATERIAL IN LIFTS ACCORDING TO THE TYPICAL SECTION AND AS DIRECTED BY THE ENGINEER.
AGG8	AGGREGATE BASE, 8 IN, 21AA, CIP
HMA APP	PLACE HMA APPROACH
HP	HAND PATCHING
CG	PLACE CURB AND GUTTER, CONC, F4, SPECIAL
DO-M	PLACE DRIVEWAY OPENING, CONC, DETAIL M, P-NC
DC-6	PLACE CONC, DRIVE APPROACH, NON-REINFORCED, P-NC, 6 INCH. PLACE AND COMPACT 6 INCH SUBBASE, CIP, CLASS II GRANULAR MATERIAL, MODIFIED
SW-4	PLACE SIDEWALK, CONC, 4 INCH, MODIFIED
SWR-6	PLACE SIDEWALK, SIDEWALK RAMP, CONC, 6 INCH, MODIFIED
SW8	CONC, SIDEWALK, DRIVE APPROACH OR RAMP, 8 INCH
DWS	DETECTABLE WARNING, CAST IN PLACE
ISW-CB	INTEGRAL SIDEWALK/CURB
ABO	ADJUST BY OTHERS
1	ADJUST GATE VALVE BOX, MONUMENT BOX, OR GAS BOX.
2	ADJUST STRUCTURE COVER

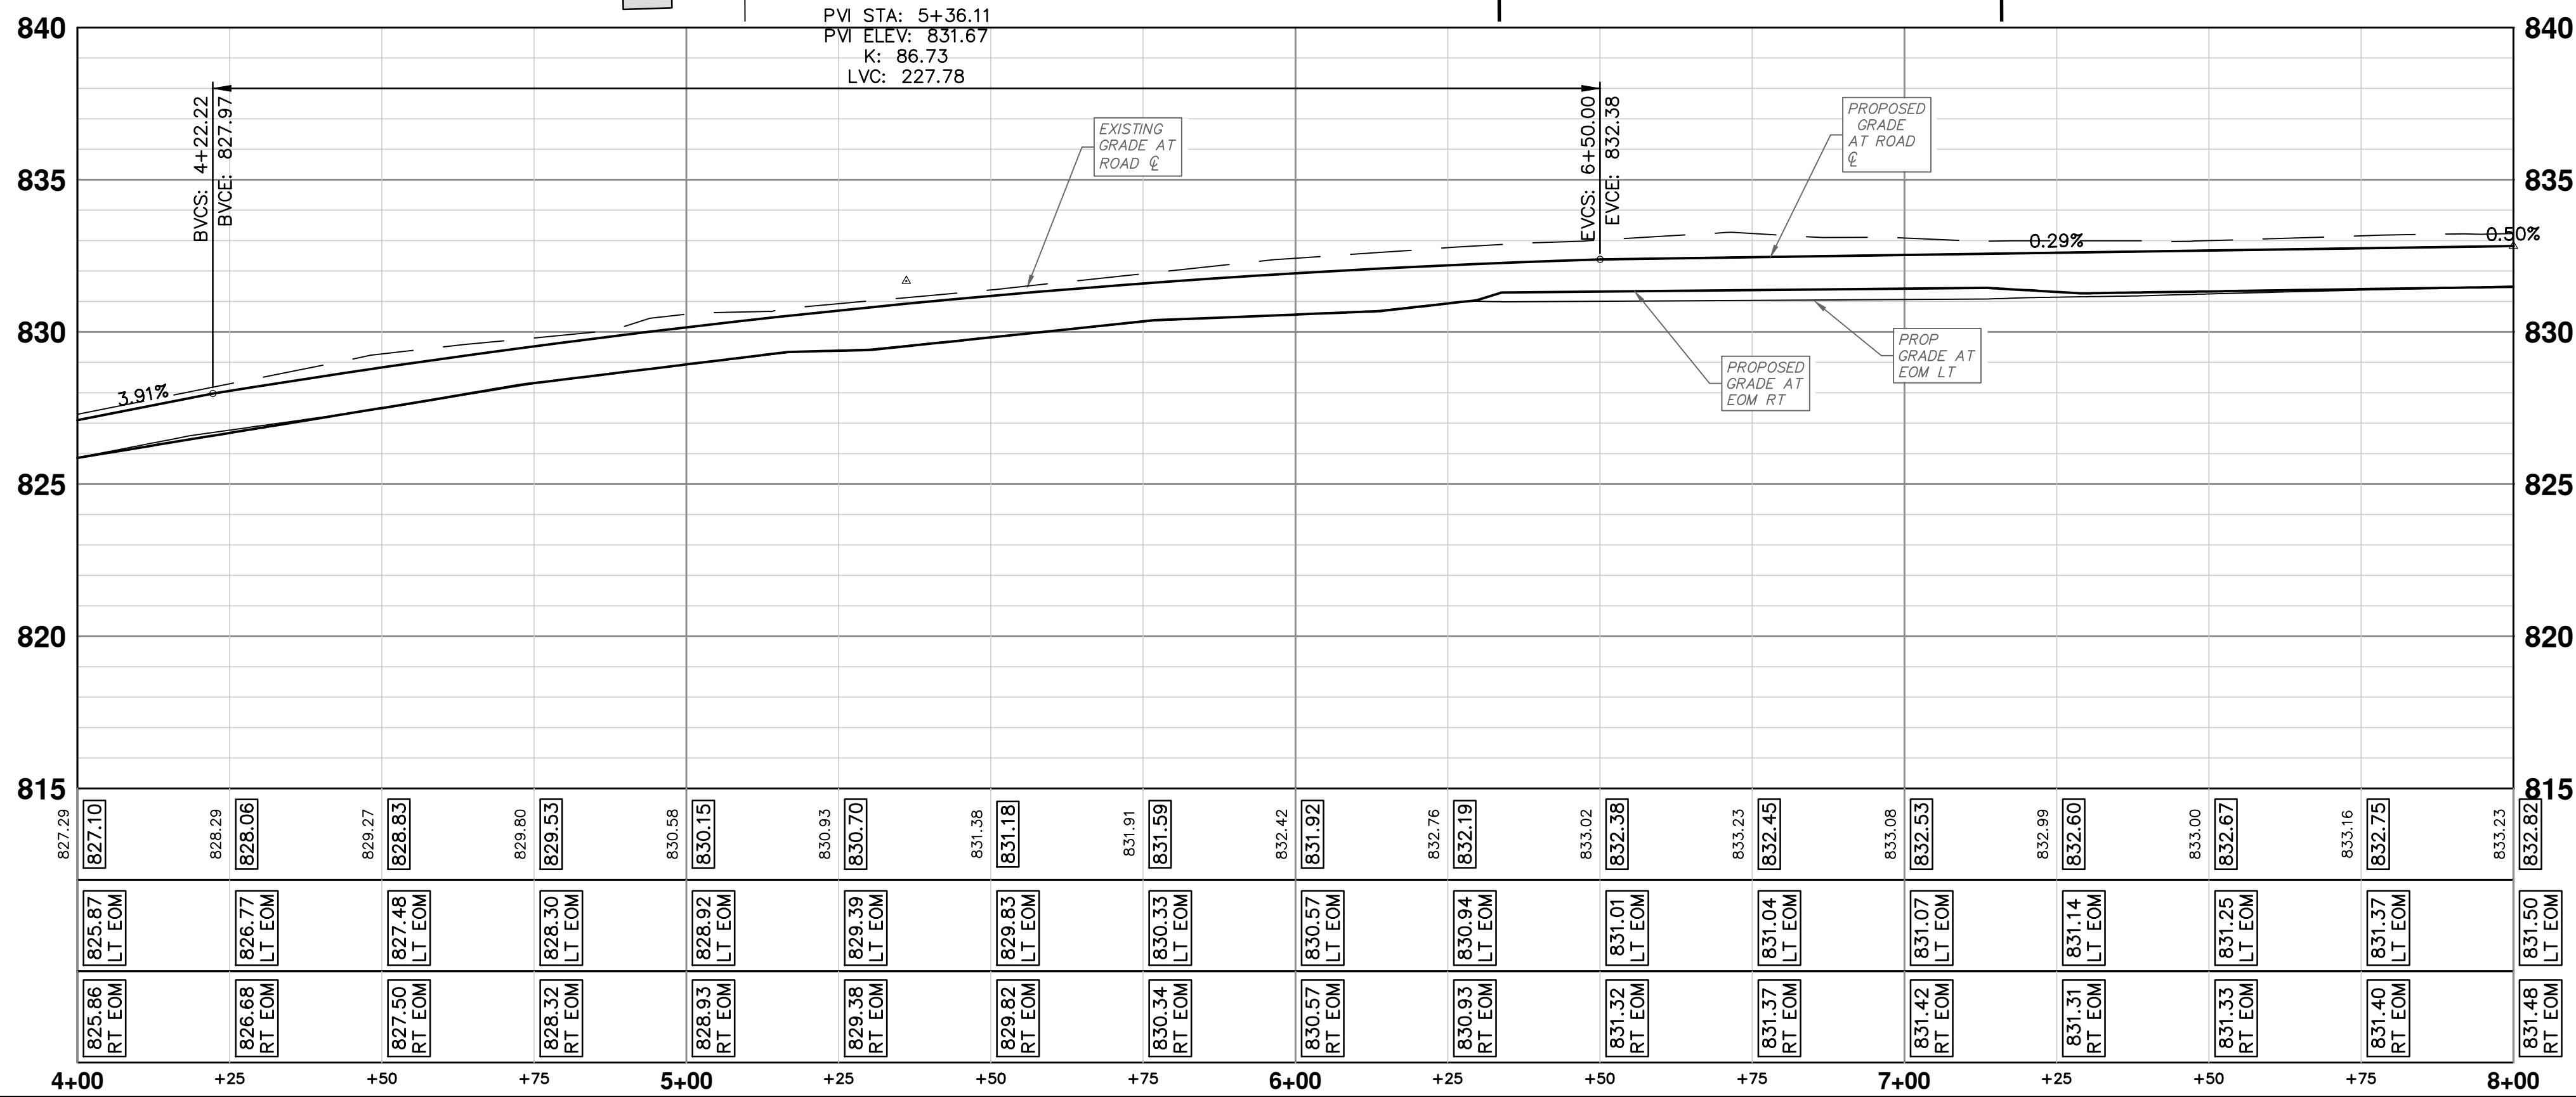

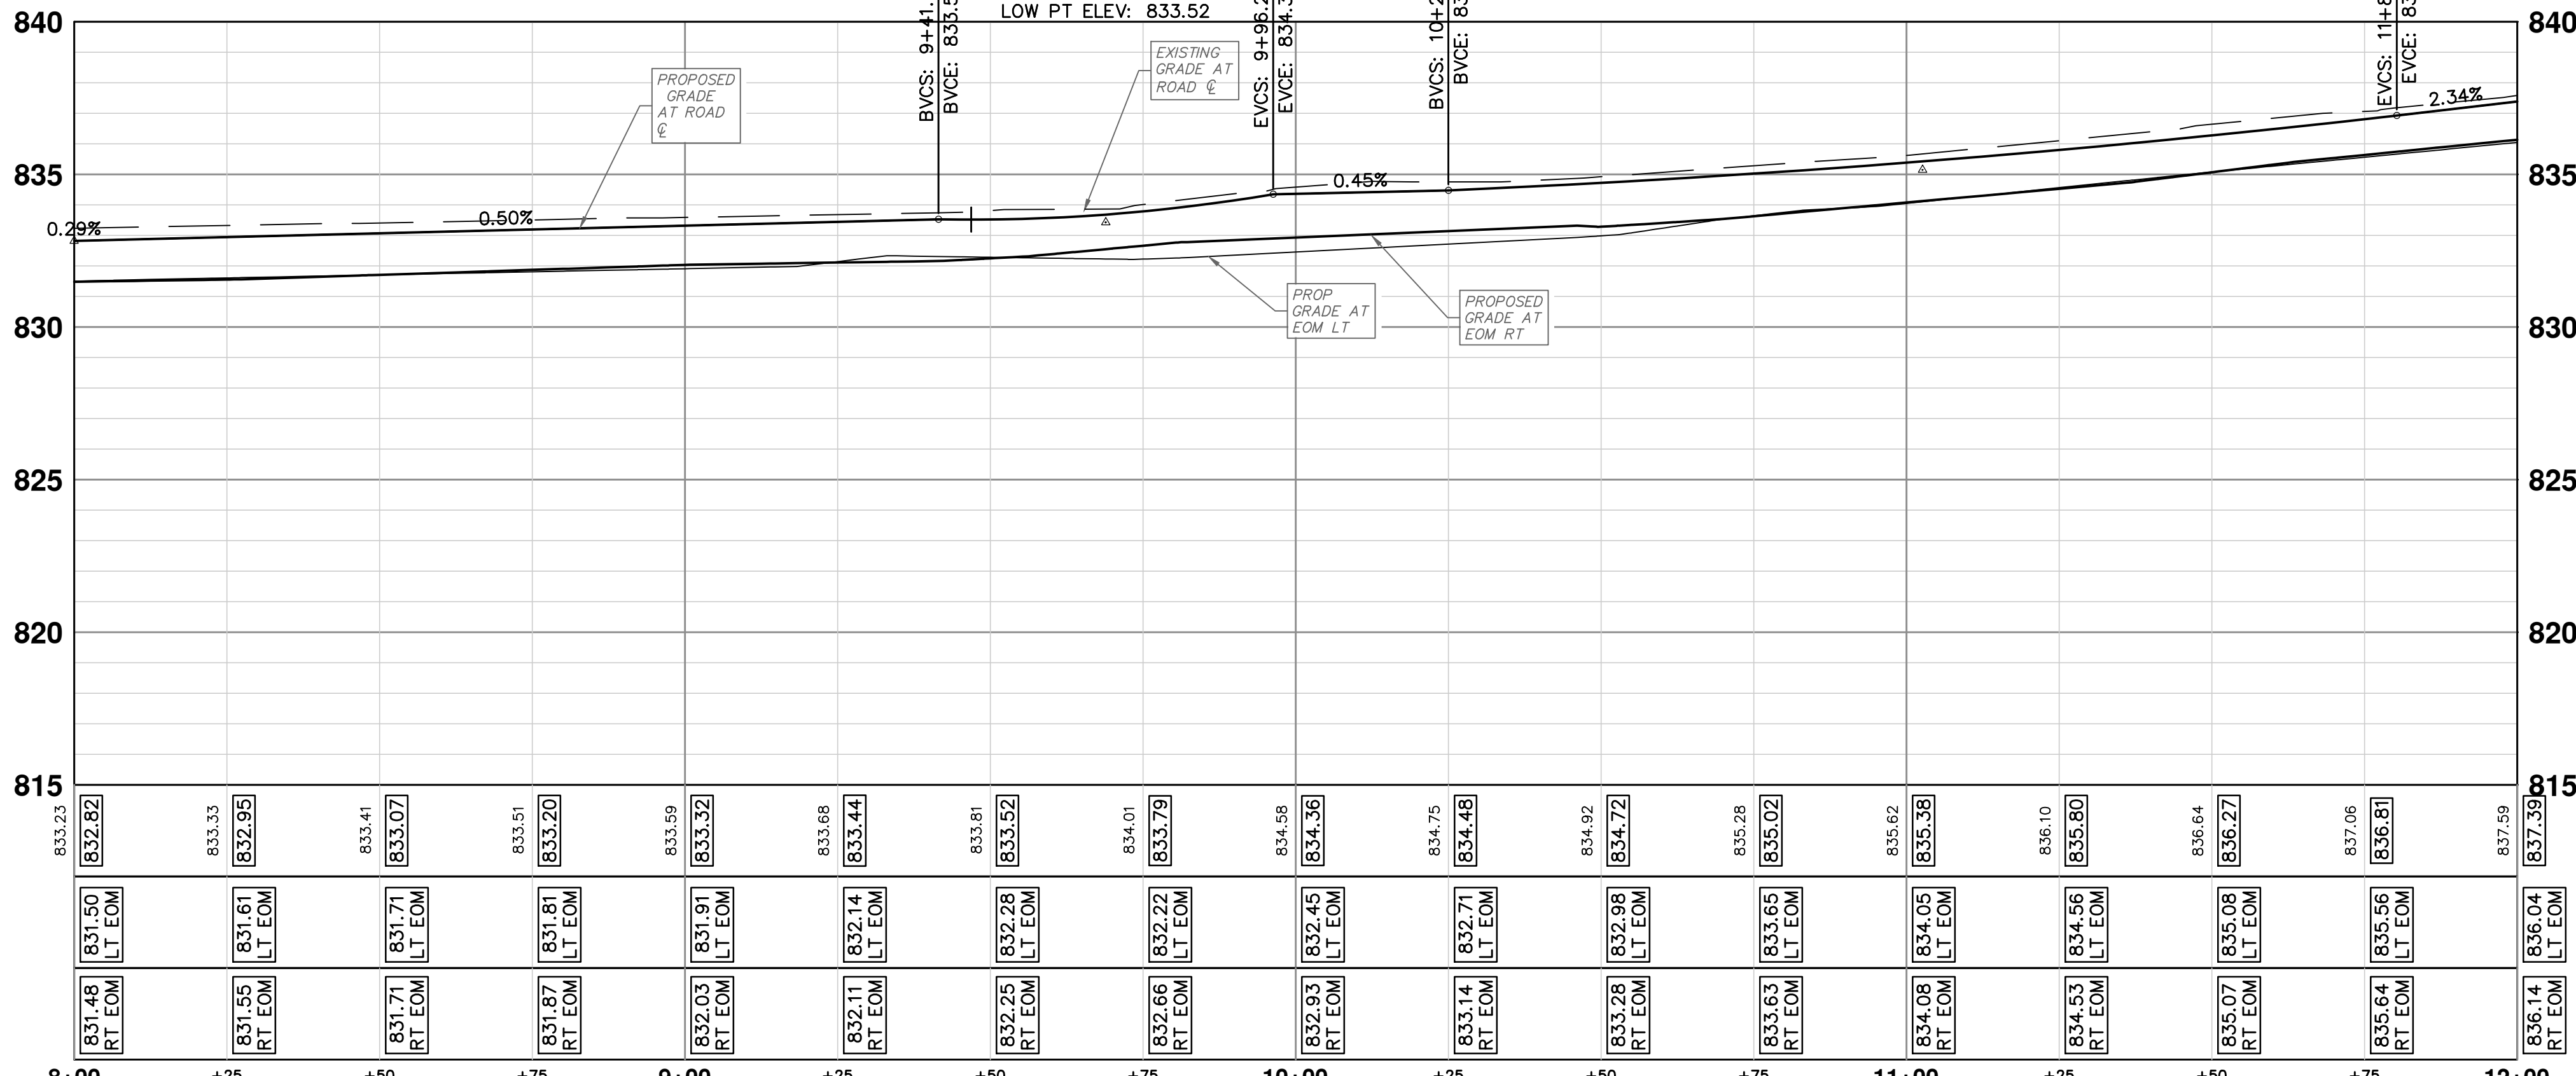

CONSTRUCTION KEY	
KEY	DESCRIPTION
HMA	PLACE HMA, LVSP. PLACE MATERIAL IN LIFTS ACCORDING TO THE TYPICAL SECTION AND AS DIRECTED BY THE ENGINEER.
AGG8	AGGREGATE BASE, 8 IN. 21AA, CIP
HMA APP	PLACE HMA APPROACH
HP	HAND PATCHING
CG	PLACE CURB AND GUTTER, CONC. F4, SPECIAL
DO-M	PLACE DRIVEWAY OPENING, CONC. DETAIL M, P-NC
DC-6	PLACE CONC. DRIVE APPROACH, NON-REINFORCED, P-NC, 6 INCH. PLACE AND COMPACT 6 INCH SUBBASE, CIP, CLASS II GRANULAR MATERIAL, MODIFIED
SW-4	PLACE SIDEWALK, CONC. 4 INCH, MODIFIED
SWR-6	PLACE SIDEWALK, SIDEWALK RAMP, CONC. 6 INCH, MODIFIED
SW8	CONC. SIDEWALK, DRIVE APPROACH OR RAMP, 8 INCH
DWS	DETECTABLE WARNING, CAST IN PLACE
ISW-CB	INTEGRAL SIDEWALK/CURB
ABO	ADJUST BY OTHERS
1	ADJUST GATE VALVE BOX, MONUMENT BOX, OR GAS BOX.
2	ADJUST STRUCTURE COVER

\\ohm\dfs\Corporate\Projects\0000_0100\0028220080_Ann_St-Washtenaw_Ave_WM_Designs\Drawings\Civil\Plans_Const\220080PPrd.dwg Dwg Created: 26-Jan-26 - _a2 standard bw.stb
Plot Date: 26-Jan-26

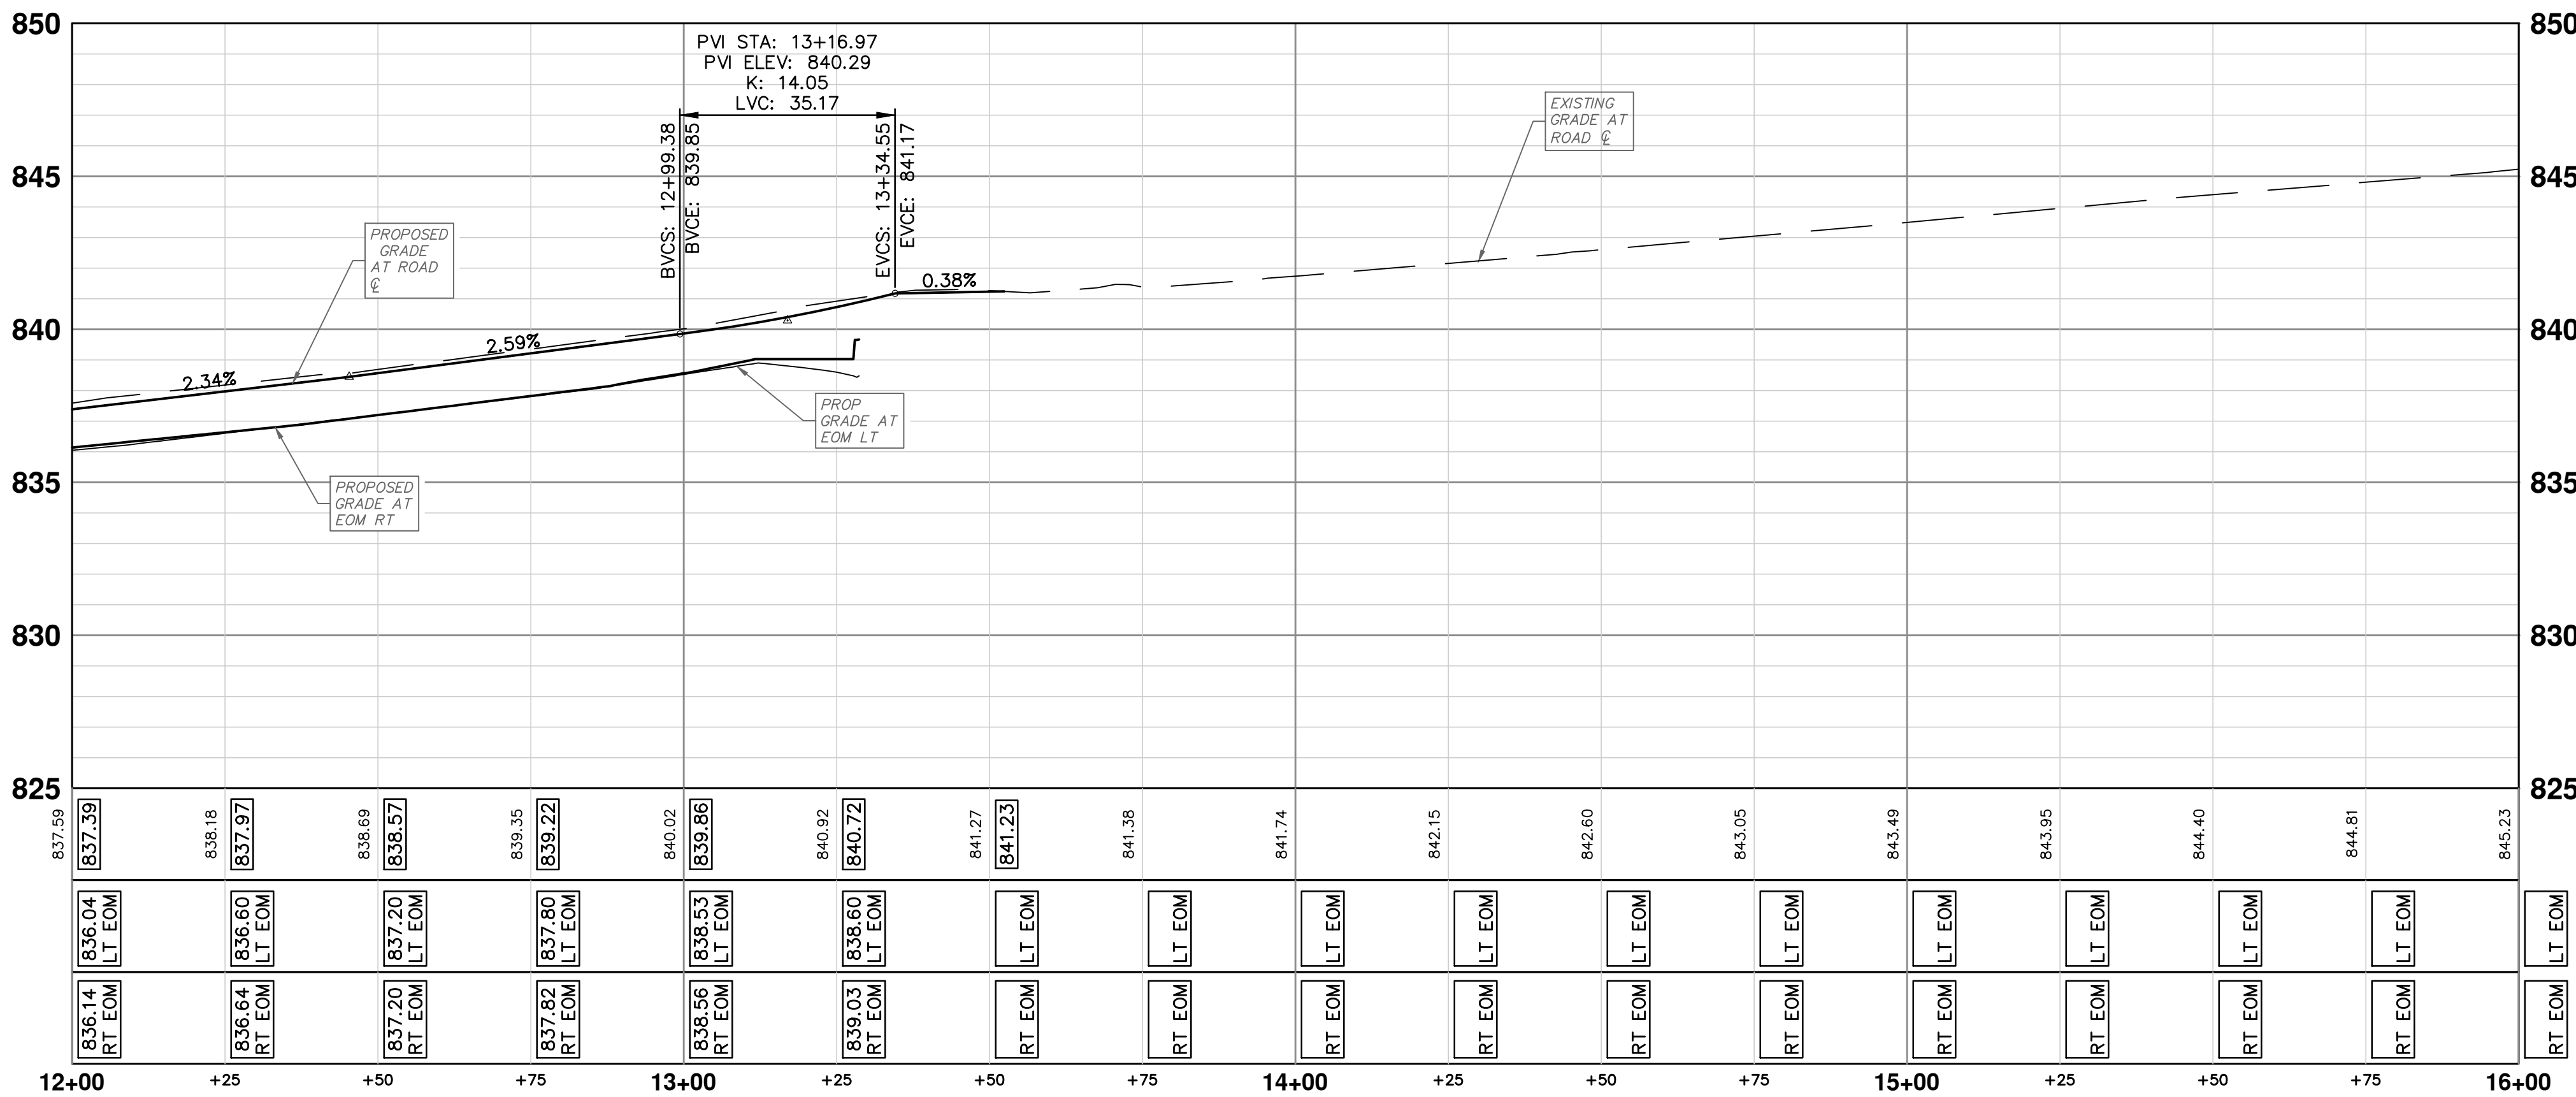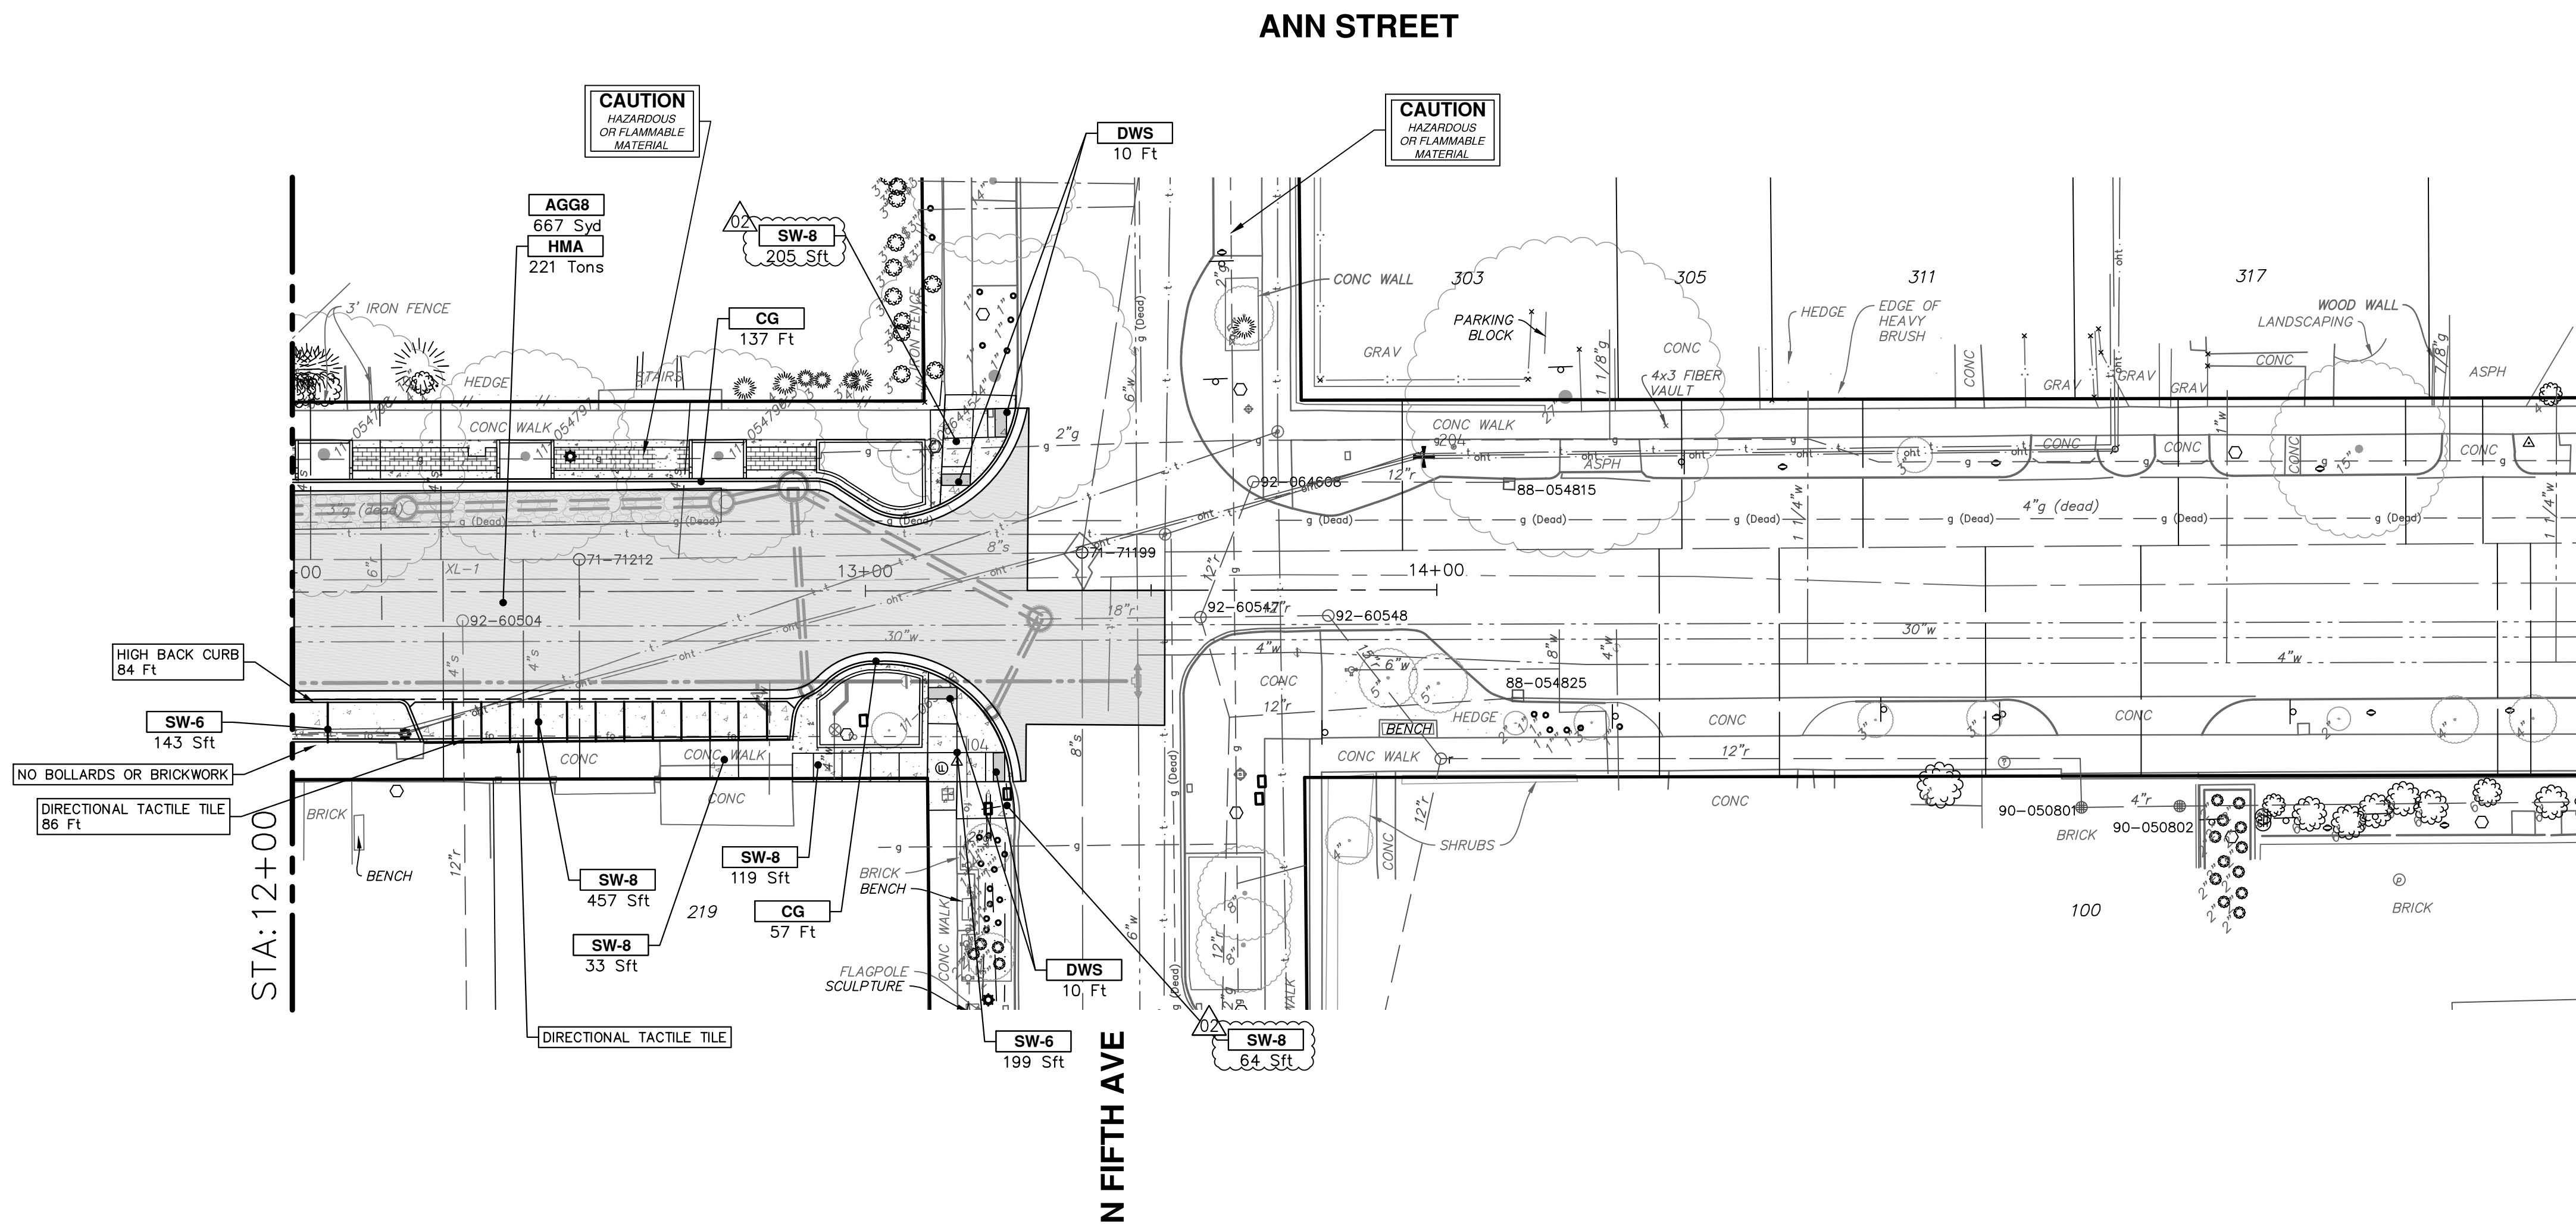

CONSTRUCTION KEY	
KEY	DESCRIPTION
HMA	PLACE HMA, LVSP. PLACE MATERIAL IN LIFTS ACCORDING TO THE TYPICAL SECTION AND AS DIRECTED BY THE ENGINEER.
AGG8	AGGREGATE BASE, 8 IN, 21AA, CIP
HMA APP	PLACE HMA APPROACH
HP	HAND PATCHING
CG	PLACE CURB AND GUTTER, CONC, F4, SPECIAL
DO-M	PLACE DRIVEWAY OPENING, CONC, DETAIL M, P-NC
DC-6	PLACE CONC, DRIVE APPROACH, NON-REINFORCED, P-NC, 6 INCH. PLACE AND COMPACT 6 INCH SUBBASE, CIP, CLASS II GRANULAR MATERIAL, MODIFIED
SW-4	PLACE SIDEWALK, CONC, 4 INCH, MODIFIED
SWR-6	PLACE SIDEWALK, SIDEWALK RAMP, CONC, 6 INCH, MODIFIED
SW8	CONC, SIDEWALK, DRIVE APPROACH OR RAMP, 8 INCH
DWS	DETECTABLE WARNING, CAST IN PLACE
ISW-CB	INTEGRAL SIDEWALK/CURB
ABO	ADJUST BY OTHERS
1	ADJUST GATE VALVE BOX, MONUMENT BOX, OR GAS BOX.
2	ADJUST STRUCTURE COVER

811

Know what's below. Call before you dig.

CE

AT

SM

CE

SM

CE

SM

CHECKED

01-26-2026

01-20-2026

12-17-2025

ADDENDUM 4

ADDENDUM 2

BID SET

DATE

DATE

DATE

02

01

00

ADDENDUM 4

ADDENDUM 2

BID SET

REV.

DESCRIPTION

DATE

CITY OF ANN ARBOR
PUBLIC SERVICES
301 EAST HURON STREET
P.O. BOX 8647
ANN ARBOR MI 48106-8647
www.a2gov.org

CITY OF ANN ARBOR
PUBLIC SERVICES
301 EAST HURON STREET
P.O. BOX 8647
ANN ARBOR MI 48106-8647
www.a2gov.org

CITY OF ANN ARBOR - PUBLIC SERVICES - ENGINEERING

ANN STREET IMPROVEMENTS

CONSTRUCTION PLAN AND PROFILE STA 12+00 TO P.O.E.

SCALE PLAN: 1" = 20'

PROFILE: 1" = 4'

DRAWING No. 2022-025-16

SHEET No. 16 OF 67