

ADDENDUM No. 1

ITB No. 4519

North Fifth Avenue Reconstruction

Bids Due: January 11, 2018 at 10:00 A.M. (local time)

The information contained herein shall take precedence over the original documents and all previous addenda (if any), and is appended thereto. **This Addendum includes 31 pages.**

Bidder is to acknowledge receipt of this Addendum No. 1, including all attachments (if any) in its Bid by so indicating on page ITB-1 of the Invitation to Bid Form. Bids submitted without acknowledgment of receipt of this addendum will be considered nonconforming.

The following forms provided within the ITB Document must be included in submitted bids at bid opening.

- City of Ann Arbor Prevailing Wage Declaration of Compliance
- City of Ann Arbor Living Wage Ordinance Declaration of Compliance
- Vendor Conflict of Interest Disclosure Form
- City of Ann Arbor Non-Discrimination Ordinance Declaration of Compliance

Bids that fail to provide these completed forms listed above upon bid opening will be rejected as non-responsive and will not be considered for award.

I. CORRECTIONS/ADDITIONS/DELETIONS/CLARIFICATIONS

Changes to the Bid documents outlined below are referenced to a page or Section in which they appear conspicuously. The Bidder is to take note in its review of the documents and include these changes as they may affect work or details in other areas not specifically referenced here.

1. Pre-Bid Meeting Minutes and Sign-In Sheets pages ADD1- 5-8
2. Bid Forms, pages BF-1 thru BF-8; replace these pages with attached pages ADD1- 9 – 16
3. Detailed Specifications, pages DS-46 thru DS-49; replace with Special Provision for HMA Pavement Base Course/HMA Pavement Leveling/HMA Pavement Wearing ADD1- 17-20
4. Plan sheets C1.01 thru .03, C3.00, .01, .04, C6.01, C7.00, C8.01, and L1.0; replace with attached pages ADD1 21-30
5. Insert ADD1 – 31 into the plan sheet set as reference of existing and proposed conditions.
6. Clarification: The note regarding plant substitutes at the bottom of the Plant List on Drawing L1.0 has been deleted.
7. Clarification: The actual dimension of the new brick specified to be as follows:
 - Thickness: 4 inches (nominal)
 - Face Size: 3-3/8 inches by 9 inches (nominal)
8. Clarification and Addition: Relative to the Bid Alternate for Sidewalk Brick, the following Pay Items have been added to the Bid Form:
 - 238-2 “Concrete Pavement Base, 6 inch (under sidewalk pavers)”, and

- 241-2 “Brick Pavers, New (sidewalk)”. The specification for brick materials and installation will meet the requirements specified for Pay Item #241 “Brick Pavers, New”
9. Clarification: All concrete paving paid for as Pay Item #238 “Concrete Pavement Base, 8 inch (under pavers)” and #239 “Concrete Crosswalk, 12 inch” will be reinforced with steel mesh as noted in Detail 4, Drawing No. C10.1. Said reinforcement will be included in the unit price for the respective items.
 10. Clarification: The drawings indicate work to be completed outside of the right of way on property owned by the Ann Arbor Public Schools. This work is an extension of the right of way work, and will be paid for based on the applicable unit prices. Machine Grading, Modified will be extended to the limits of grading where work includes property adjacent to the right of way.

II. REQUEST FOR INFORMATION

1. Please clarify if “Machine Grading, Modified” will be paid for twice, for each side of the road, by the station, as necessary. The description in measurement and payment could be read a variety of ways.
 - Response: It will be paid per side of the construction centerline for each station, or portion of, constructed.
2. Is the aggregate / sand sub-base or base material for the concrete curb, concrete ramps, concrete sidewalk, concrete drive approaches, concrete pavement base and concrete crosswalk incidental to the above pay items, or will it be paid for separately as sand sub-base / aggregate base course?
 - Response: Aggregate and sand will be paid for separately. Sand subbase quantities reflect replacing a majority of new sidewalk on existing, in-situ, sand base.
3. Does the pay item for “Temporary Line Stops” include the necessary items for surface restoration (pavement, aggregate, etc.), or will these items be paid for separately? The special provision makes reference to the removals, but does not directly address the restoration. Please clarify.
 - Response: Pavement cross section replacement will be paid for separately. A detail has been provided on C3.0, noting applicable pay items.
4. Please clarify if ANY of the proposed improvements that are scheduled to be performed OUTSIDE of the typical Machine Grading Limits (ROW to ROW) will be included in the stationing for the Machine Grading Pay Item and/or covered in the other typical pay items (pavement removal, agg base, HMA, concrete sidewalk, etc.). Specifically, the hydrant extension on Fifth Street (STA 7+22) appears to extend past the typical Machine Grading pay limits. How will removals and restoration be paid for outside of the typical Machine Grading pay limits?
 - Response: The work at station 7+22 has been revised; see #6 for further information. In other locations outside of the right of way, the pay item limits will extend to the grading limits.
5. It appears that there is no a traffic control plan/staging plan for the proposed water main work and interconnections at the various intersections, Kingsley Street and the southern leg of Detroit Street. Will the City be issuing staging/traffic control plans for these various stages of water main work?
 - Response: See attached plans.

6. Please clarify the water main abandonment limits for the existing main that runs parallel to the proposed hydrant at STA 07+22 on Fifth. The plans are not clear as to the intent of this work.
 - Response: This hydrant will not be replaced, but the lead up to the valve will be upsized per the revised, attached plan.
7. Do you intend on leaving unconnected legs of proposed water main (dead end “stubs”), as required, to allow for a traditional phased ROW improvements? We need to get an idea of what will be REQUIRED by the City in relation to the various water main improvements for each street so that we can marry the water main phasing and scheduling to the ROW improvement phasing.
 - Response: ‘Dead ends’ will not be permitted, and therefore must be temporarily connected to the existing main to ensure continued looping in the system.
8. Could multiple crews install water main simultaneously between the various phases?
 - Response: Yes, as long as work is continuous, and traffic is maintained in accordance with the restrictions noted in the contract documents.
9. Will the road(s) require temporary surface(s) as we make the required interconnections in the intersections and between mainline testing stubs? If so, how will this work be paid for? Do you have a required temporary pavement cross section?
 - Response: It is likely that a temporary surface will be required to maintain traffic. A cross section detail and pay items for temporary pavement have been added to the plans.
11. Would it be possible to get a drawing showing the existing road configuration overlaid with the new road configuration?
 - Response: Included in the addendum.
12. For items 229-1 & 229-2 Brick, Rem/sort. Do these bricks need to be palletized or sorted and dumped in a pile at the specified location?
 - Response: Store salvaged bricks on pallets to preserve their integrity.
13. On Sheet C8.02, item H "Replace damaged brick in this area as directed by the project engineer," what pay item does this go under?
 - Response: The intent of this note is to notify the contractor that the limits of brick road paving in this area of Detroit Street will be determined in the field by the Engineer, and paid for under Pay Item #229-1 “Brick Pavers, Rem, Sort and Salvage, Roadway”, and Pay Item #242 “Brick, Install Salvaged Brick”.
14. Is the intent to use pay item 242 Brick, Install Salvaged Brick for the repaired parts of Detroit Street from 5th Street to Catherine St?
 - Response: Yes
15. The specification for Item 246 Concrete Unit Retaining Wall, Rem, Salvage, and Re-install calls out to backfill the wall with sand; however, manufacturer's recommended installation is to have a minimum of 12" of 100% crushed stone (typically 6A) behind the wall for drainage to prevent hydrostatic pressure behind the wall.
 - Response: Backfill the wall as currently specified in the contract documents.
16. Please also verify what line item the granular material for the tree grates is included in.
 - Response: The granular material noted on Detail 5, Drawing No. C10.4 will be paid for as Pay Item #260- “Sand Subbase Course, Class II - C.I.P.” Excavation required to install the granular material, planting soil and plant material is incidental to the installation of the tree.
17. Do you have a source for the bike hoops?
 - Response: Bike hoops meeting the specifications are available from a number of manufacturers.

- Clarification: The bike hoop pipe itself is to be made of galvanized steel, not stainless steel as noted in the specifications; all mounting hardware is to be made of stainless steel.
18. Are we to include mulch? It is shown in the details, but not on the bid form.
- Response: Mulching is not a separate pay item, but is to be included in the cost of the landscape plantings.
19. Are we to include (2) Quercus macrocarpa per the bid form or (2) Quercus rubra per the plans?
- Response: The correct species is Quercus Macrocarpa, as noted on the revised plan sheet.
20. The (6) Calamagrostis x 'Karl Foerster' shown on L1.0 are missing on the bid form.
- Response: Refer to revised bid form and plan sheet.
21. Will any lawn restoration be required? It is not included on the bid form.
- Response: there is limited lawn restoration, and the work is included in 'Machine Grading, Modified'
22. The plans show (3) ADA benches & tables and (6) non-ADA benches & tables. Do these need to be separate on the bid form? The cost varies between the two.
- Response: Refer to revised bid form.

Bidders are responsible for any conclusions that they may draw from the information contained in the Addendum.

North Fifth Avenue Reconstruction
PreBid Meeting Minutes
Friday, December 15, 2017

I. Introductions

II. General

A. Overview

Partnership with the DDA for construction in the area of North Fifth Avenue and Detroit Street, including water main replacement, roadway reconstruction and resurfacing, storm water improvements, streetscape, and lighting. Per the Bid Documents, questions regarding the construction should be directed to Jenn Nelson (JNelson@a2gov.org) and questions regarding the Bid Process and Compliance should be directed to Colin Spencer (Cspencer@a2gov.org). An Addendum will be issued.

B. Items of Work

1. Water main replacement – 5th Ave (Kingsley to Catherine), Detroit (5th to Kingsley), and Kingsley (5th to Detroit)
2. Reconstruction
 - a) North Fifth full depth asphalt on aggregate base (Catherine to Kingsley)
 - b) Detroit is salvaged bricks on concrete base, supplemented with new bricks. Goal is to salvage as many bricks as possible due to their unique historic character. The salvage rate was assumed to be about 20%. Supplemental new bricks are to be sourced as described in the specifications.
3. Resurfacing of Kingsley
4. Infiltration and minor storm improvements
5. Streetscape
 - a) New sidewalk and ramps
 - b) Plaza reconstruction with benches, planters, and rain garden
 - c) Amenities include trees, tree grates, and plantings
6. Pedestrian lighting
 - a) Conduit is also included for underground telecommunications and City IT fiber
7. Misc.
 - a) Insurance –
 - (1) Add DDA as additional insured
 - (2) Submit endorsements with certificate to ensure timely approval
 - b) Project coordination with merchants, farmers market, and CHS high school to maintain access to businesses at all times. Project requires balancing through traffic and local pedestrian access, so be prepared to need to adjust operations during construction.
 - c) There will be no Farmers Market building construction
 - d) Alternate bid for sidewalk pavers will be issued with first Addendum (Details are already included in plans)
 - e) Items 207 & 284 – Bidders should visit the site to evaluate amenity removal and reinstallation items (e.g., benches, planter, historical marker, etc)

- f) Item 295 Special Plaza Lighting – read spec carefully as City/DDA will be supplying poles and lights for most of project, but some lighting near Farmers Market to be supplied by Contractor.

III. Schedule

- A. Deadline for Questions – 5:00 p.m., Thursday, December 28, 2017
- B. Bid Opening – Thursday, January 11, 2018, 10:00 am
- C. Start late-March or early April, 2018
- D. Completion of November 9, 2018
- E. Maintain one lane on North Fifth
 - 1. Until summer recess June 18, 2018
 - 2. During Art Fair July 18-22, 2018
 - 3. At school start September 4, 2018 through completion

IV. Questions

- A. Area of non-hazardous contamination is near Teriyaki Time which was once a gas station
- B. Engineer's Estimate is \$5.373M
- C. Staking and testing will be by City
- D. Inspection will be by City

Contact Information:

Jennifer Nelson
Project Manager
Phone: (734) 794-6410 ext. 43672
E-mail: jnelson@a2gov.org

PREBID MEETING MEETING SIGN-IN SHEET

PROJECT: North Fifth Ave Reconstruction

File No. 2015-037

Date: 12/15/17

PLEASE PRINT

NAME	REPRESENTING	MAILING ADDRESS	TELEPHONE	EMAIL
Jennifer Nelson Project Engineer	City of Ann Arbor - Project Management	Address: 301 East Huron St, P.O. Box 8647 City, State: Ann Arbor, MI Zip: 48107-8647	Office: (734) 794-6410 x43672 Fax: (734) 994-1744	jnelson@a2gov.org
<i>Bob Doyle</i>	<i>SGWR</i>	Address: <i>201 DEPDT ST.</i> City, State: <i>ANN ARBOR</i> Zip: <i>48104</i>	Office: <i>(734) 669-2695</i> Mobile: <i>(734) 546-0408</i>	<i>bob.doyle@smithgroupjr.com</i>
<i>John Heavey</i>	<i>FENSON COMPANY</i>	Address: <i>7644 WHITMORE LAKE RD</i> City, State: <i>BRIGHTON, MI</i> Zip: <i>48116</i>	Office: <i>(510) 231-5188</i> Mobile: <i>(810) 522-7965</i>	<i>ESTIMATING@FENSONMCC.COM</i>
<i>Mike Hoosier</i>	<i>Doyle & Huggins</i>	Address: <i>3390 Trans Lake Rd</i> City, State: <i>Ann Arbor</i> Zip: <i>48103</i>	Office: <i>(734) 446 9500</i> Mobile: ()	<i>mike@doylehuggins.com</i>
		Address: _____ City, State: _____ Zip: _____	Office: () Mobile: ()	
		Address: _____ City, State: _____ Zip: _____	Office: () Mobile: ()	
		Address: _____ City, State: _____ Zip: _____	Office: () Mobile: ()	
		Address: _____ City, State: _____ Zip: _____	Office: () Mobile: ()	

PREBID MEETING MEETING SIGN-IN SHEET

PROJECT: North Fifth Ave Reconstruction

File No. 2015-037

Date: 12/15/17

MEETING SIGN-IN SHEET PLEASE PRINT

NAME	REPRESENTING	MAILING ADDRESS	TELEPHONE	EMAIL
Liz Rolla	DDA	Address: _____ City, State: _____ Zip: _____	Office: () _____ Mobile: (734) 323-7156	erolla e a2dda.org
Jacob Bailey	Bailey EX	Address: 1073 Toro Dr. City, State: Jackson Zip: 49201	Office: (517) 750-3636 Mobile: (517) 740-0371	Jacob Bailey @ Bailey-Excavating.com
John Nishner	E.T. MACHENZIE COMPANY	Address: 6400 JACOBSON ROAD City, State: ANN ARBOR, MI Zip: 48103	Office: (734) 761.5050 Mobile: (734) 216.0995	jnishner@ machtenzieco.com
		Address: _____ City, State: _____ Zip: _____	Office: () _____ Mobile: () _____	
		Address: _____ City, State: _____ Zip: _____	Office: () _____ Mobile: () _____	
BID FORM
Section 1 - Schedule of Prices
Project ITB - 4519 - North Fifth Avenue Reconstruction

Item Number	Description	Unit	Quantity	Unit Price	Total Cost
101	General Conditions, Max \$200,000	LS	1	\$ _____ = \$ _____	_____
102	Audiovisual Tape Coverage	LS	1	\$ _____ = \$ _____	_____
104	Certified Payroll Compliance and Reporting	LS	1	\$ _____ = \$ _____	_____
120	Project Supervision, Max \$100,000	LS	1	\$ _____ = \$ _____	_____
135	Tree Removal (8" and Larger)	Ea	25	\$ _____ = \$ _____	_____
140	Exploratory Excavation (0-10' deep)	Lft	400	\$ _____ = \$ _____	_____
203	Minor Traf Devices	LS	1	\$ _____ = \$ _____	_____
204	Non-hazardous Contaminated Material Handling and Disposal	Cyd	550	\$ _____ = \$ _____	_____
205	Machine Grading, Modified,	Sta	27	\$ _____ = \$ _____	_____
207	Plaza Amenities, Rem and Salvage	LS	1	\$ _____ = \$ _____	_____
208	Geotextile	Syd	450	\$ _____ = \$ _____	_____
209	Geogrid	Syd	200	\$ _____ = \$ _____	_____
210	Stone Reservoir	Cyd	250	\$ _____ = \$ _____	_____
215	Infiltration Inlet	Ea	4	\$ _____ = \$ _____	_____
220	HMA Base Course	Ton	530	\$ _____ = \$ _____	_____
221	HMA Leveling	Ton	360	\$ _____ = \$ _____	_____
222	HMA Wearing	Ton	315	\$ _____ = \$ _____	_____
223	Temporary Pavement/Pedestrian Access	Syd	1,200	\$ _____ = \$ _____	_____
224	Hand Patching	Ton	100	\$ _____ = \$ _____	_____
226	Recessing Pavt Mrkg, Transv	Sft	2,110	\$ _____ = \$ _____	_____
227	Remove Concrete Sidewalk and Driveways - Any Thickness	Syd	2,529	\$ _____ = \$ _____	_____

BID FORM
Section 1 - Schedule of Prices
Project ITB - 4519 - North Fifth Avenue Reconstruction

Item Number	Description	Unit	Quantity	Unit Price	Total Cost
228	Road Pavement, Rem	Syd	4,347	\$ _____	= \$ _____
229-1	Brick Pavers, Rem, Sort and Salvage, Roadway	Syd	2,168	\$ _____	= \$ _____
229-2	Brick Pavers, Rem, Sort and Salvage, Sidewalk	Syd	343	\$ _____	= \$ _____
230	Remove Concrete Curb or Curb & Gutter - Any Type	Lft	2,160	\$ _____	= \$ _____
231	Concrete Curb, 6 inch Straight	Lft	795	\$ _____	= \$ _____
232	Concrete Planter Curb	Lft	409	\$ _____	= \$ _____
233	Salvage and Reset Stone Curb	Lft	60	\$ _____	= \$ _____
234	Concrete Curb & Gutter - Any Type	Lft	2,162	\$ _____	= \$ _____
235	8 inch Concrete Ramp	Sft	2,716	\$ _____	= \$ _____
236	6-Inch Concrete Sidewalk	Sft	20,224	\$ _____	= \$ _____
237	8-Inch Concrete Drive Approach (TYPE L or M)	Sft	5,595	\$ _____	= \$ _____
238-1	Concrete Pavement Base, 8 inch (under pavers)	Sft	14,851	\$ _____	= \$ _____
239	Concrete Crosswalk, 12 inch	Sft	3,764	\$ _____	= \$ _____
240	Detectable Warning Surface	Sft	322	\$ _____	= \$ _____
241-1	Brick Pavers, New	Sft	11,881	\$ _____	= \$ _____
242	Brick, Install Salvaged Brick	Sft	2,970	\$ _____	= \$ _____
245	Concrete Seat Wall	Lft	179	\$ _____	= \$ _____
246	Concrete Unit Retaining Wall, Rem, Salvage, and Re-install	Lft	30	\$ _____	= \$ _____
249	Hydrant Assembly Abandonment	Ea	3	\$ _____	= \$ _____
250	Drain Pipe, 6 Inch	Lft	60	\$ _____	= \$ _____
251	Landscape Inlet	Ea	2	\$ _____	= \$ _____

BID FORM
Section 1 - Schedule of Prices
Project ITB - 4519 - North Fifth Avenue Reconstruction

Item Number	Description	Unit	Quantity	Unit Price	Total Cost
252	Sewer Bulkhead, 4-inch Through 18-inch diameter	Ea	4	\$ _____ = \$ _____	_____
255	Temporary 6 Inch Water Main Line Stop	Ea	2	\$ _____ = \$ _____	_____
256	Temporary 8 Inch Water Main Line Stop	Ea	2	\$ _____ = \$ _____	_____
257	Temporary 12 Inch Water Main Line Stop	Ea	2	\$ _____ = \$ _____	_____
260	Sand Subbase Course, Class II - C.I.P.	Cyd	350	\$ _____ = \$ _____	_____
261	Planting Soil	Cyd	150	\$ _____ = \$ _____	_____
262	Composite Planting Mix	Cyd	20	\$ _____ = \$ _____	_____
263	Riprap, Fieldstone	Cyd	2	\$ _____ = \$ _____	_____
264	Landscape Maintenance	Month	14	\$ _____ = \$ _____	_____
266	Tree Grate, 3 ft. X 5 ft.	Ea	4	\$ _____ = \$ _____	_____
267	Tree Grate, 3 ft. X 10 ft.	Ea	32	\$ _____ = \$ _____	_____
270	No Parking Sign	Ea	20	\$ _____ = \$ _____	_____
271	Sign, Portable Changeable Message	Ea	1	\$ _____ = \$ _____	_____
272	Channelizing Device, 42 Inch	Ea	80	\$ _____ = \$ _____	_____
273	Barricade Type III - Lighted	Ea	40	\$ _____ = \$ _____	_____
275	Temporary Sign - Type B	Ea	80	\$ _____ = \$ _____	_____
276	Temporary Sign - Type A	Ea	10	\$ _____ = \$ _____	_____
278	Lighted Arrow, Type C, Furnish & Operate	Ea	2	\$ _____ = \$ _____	_____
279	Temporary Pedestrian Type II Barricade	Ea	20	\$ _____ = \$ _____	_____
280	Temporary Pedestrian Type II Channelizer	Ea	1,200	\$ _____ = \$ _____	_____
281	Urban Bench	Ea	8	\$ _____ = \$ _____	_____

BID FORM
Section 1 - Schedule of Prices
Project ITB - 4519 - North Fifth Avenue Reconstruction

Item Number	Description	Unit	Quantity	Unit Price	Total Cost
282-1	Urban Table and Benches, Standard	Ea	6	\$ _____ = \$ _____	_____
282-1	Urban Table and Benches, ADA	Ea	3	\$ _____ = \$ _____	_____
283	Bike Hoops, Surface Mount	Ea	6	\$ _____ = \$ _____	_____
284	Reinstall Plaza Amenities	LS	1	\$ _____ = \$ _____	_____
285	Remove Parking Meter	Ea	25	\$ _____ = \$ _____	_____
286	Install Parking Meter	Ea	24	\$ _____ = \$ _____	_____
287	2" Schedule 80 PVC Electrical Conduit	Lft	1,296	\$ _____ = \$ _____	_____
288	3" Schedule 80 PVC Electrical Conduit	Lft	6,631	\$ _____ = \$ _____	_____
289	4" Schedule 80 PVC Electrical Conduit	Lft	648	\$ _____ = \$ _____	_____
290	Street Light, Rem	Ea	28	\$ _____ = \$ _____	_____
291	Special Trench Detail	Lft	215	\$ _____ = \$ _____	_____
292	Luminaire Installation	Ea	51	\$ _____ = \$ _____	_____
293	Pole Installation	Ea	39	\$ _____ = \$ _____	_____
295	Special Plaza Lighting	LS	1	\$ _____ = \$ _____	_____
296.10	Electrical Wiring - 10 Gauge	Lft	4800	\$ _____ = \$ _____	_____
296.8	Electrical Wiring - 8 Gauge	Lft	4000	\$ _____ = \$ _____	_____
297	Handhole Assembly, 12 inch x 18 inch	Ea	46	\$ _____ = \$ _____	_____
298	Handhole Assembly, 17 inch x 30 inch	Ea	14	\$ _____ = \$ _____	_____
305	SDR 35 PVC Pipe, 8 inch, Tr Det VII	Lft	18	\$ _____ = \$ _____	_____
305	SDR 35 PVC Sanitary Service Pipe, (4-8 inch, Tr Det I)	Lft	160	\$ _____ = \$ _____	_____
320	RCP, 12 inch, CI E, Tr Det I	Lft	505	\$ _____ = \$ _____	_____

BID FORM
Section 1 - Schedule of Prices
Project ITB - 4519 - North Fifth Avenue Reconstruction

Item Number	Description	Unit	Quantity	Unit Price	Total Cost
321	RCP, 15 inch, CI E, Tr Det I	Lft	240	\$ _____ = \$ _____	_____
322	12 inch Infiltration Pipe	Lft	145	\$ _____ = \$ _____	_____
360	Type 1 Manholes	Ea	2	\$ _____ = \$ _____	_____
367	Single Inlet, 4 ft. dia.	Ea	14	\$ _____ = \$ _____	_____
368	Single Inlet, 5 ft. dia.	Ea	1	\$ _____ = \$ _____	_____
369	Single Inlet, 6 ft. dia.	Ea	1	\$ _____ = \$ _____	_____
385	Sewer Pipe Abandonment	Lft	730	\$ _____ = \$ _____	_____
386	Sewer Structure Abandonment	Ea	10	\$ _____ = \$ _____	_____
392	Pipe Undercut & Refill	Cyd	70	\$ _____ = \$ _____	_____
481	Water Main Pipe Abandonment	Lft	1,970	\$ _____ = \$ _____	_____
482	Gate Valve-in-Box, Remove or Abandon	Ea	3	\$ _____ = \$ _____	_____
483	Gate Valve-in-Well, Remove or Abandon	Ea	3	\$ _____ = \$ _____	_____
510	Cold Milling Bituminous Pavement	Syd	450	\$ _____ = \$ _____	_____
516	6" Wrapped Edge Drain	Lft	2,100	\$ _____ = \$ _____	_____
522	Subgrade Undercutting, Type II	Cyd	200	\$ _____ = \$ _____	_____
527	Aggregate Base Course - 21AA - C.I.P.	Syd	6,000	\$ _____ = \$ _____	_____
563	Structure Covers	lbs	1,600	\$ _____ = \$ _____	_____
564	Reconstruct Structure	Ea	2	\$ _____ = \$ _____	_____
566	Adjust Structure Cover	Ea	16	\$ _____ = \$ _____	_____
567	Adjust Monument Box or Gate Valve Box	Ea	4	\$ _____ = \$ _____	_____
582	Temporary Pavement Marking (Type R)-In Place	Lft	500	\$ _____ = \$ _____	_____

BID FORM
Section 1 - Schedule of Prices
Project ITB - 4519 - North Fifth Avenue Reconstruction

Item Number	Description	Unit	Quantity	Unit Price	Total Cost
630-1	Street Light Foundation, Type 1	Ea	39	\$ _____ = \$ _____	_____
630-2	Street Light Foundation, Type 2	Ea	10	\$ _____ = \$ _____	_____
702	Inlet Filter	Ea	40	\$ _____ = \$ _____	_____
703	Silt Fence	Lft	1,200	\$ _____ = \$ _____	_____
810	Acer Griseum	Ea	10	\$ _____ = \$ _____	_____
811	Amelanchier Canadensis 'Autumn Brilliance'	Ea	5	\$ _____ = \$ _____	_____
812	Cercis canadensis	Ea	3	\$ _____ = \$ _____	_____
813	Celtis Occidentalis	Ea	2	\$ _____ = \$ _____	_____
814	Quercus Macrocarpa	Ea	2	\$ _____ = \$ _____	_____
815	Syringa reticula 'Ivory Silk'	Ea	10	\$ _____ = \$ _____	_____
816	Ulmus Japonica 'Discovery'	Ea	14	\$ _____ = \$ _____	_____
817	Ulmus x. 'Prospector'	Ea	8	\$ _____ = \$ _____	_____
818	Arctostaphylos uva-ursi	Ea	61	\$ _____ = \$ _____	_____
819	Hemerocallis 'Stella d'Oro'	Ea	169	\$ _____ = \$ _____	_____
820	Iris siberica 'Baby Sister'	Ea	73	\$ _____ = \$ _____	_____
821	Liriope Muscari 'Variegata'	Ea	416	\$ _____ = \$ _____	_____
822	Narciuss x' Dutch Master'	Ea	455	\$ _____ = \$ _____	_____
823	Sesleria Autumnalis	Ea	304	\$ _____ = \$ _____	_____
824	Carex Vulpinoidea	Ea	49	\$ _____ = \$ _____	_____
825	Panicum Virgatum 'Shenandoah'	Ea	175	\$ _____ = \$ _____	_____
826	Pachysandra Terminalis	Ea	213	\$ _____ = \$ _____	_____

BID FORM
Section 1 - Schedule of Prices
Project ITB - 4519 - North Fifth Avenue Reconstruction

Item Number	Description	Unit	Quantity	Unit Price	Total Cost
827	Calamagrostis X 'Karl Foerster'	Ea	6	\$ _____ = \$ _____	
901	Class 50 DIP w/Polyethylene Wrap, 12 inch, Tr Det I	Lft	1,560	\$ _____ = \$ _____	
902	Class 50 DIP w/Polyethylene Wrap, 8 inch, Tr Det I	Lft	50	\$ _____ = \$ _____	
903	Class 50 DIP w/Polyethylene Wrap, 6 inch, Tr Det I	Lft	115	\$ _____ = \$ _____	
904	Bends and Reducers, 12 inch	Ea	40	\$ _____ = \$ _____	
905	Bends and Reducers, 8 inch	Ea	10	\$ _____ = \$ _____	
906	Bends and Reducers, 6 inch	Ea	10	\$ _____ = \$ _____	
907	Tees & Crosses	Ea	13	\$ _____ = \$ _____	
908	Gate Valve-in-Well, 12 inch	Ea	11	\$ _____ = \$ _____	
910	Fire Hydrant Assembly	Ea	4	\$ _____ = \$ _____	
915	Excavate and Backfill Water Service Trench Tap and Lead	Lft	140	\$ _____ = \$ _____	
920	Pavt Mrkg, Wet Retrflc Polyurea, 4 inch, White	LFt	1,000	\$ _____ = \$ _____	
921	Pavt Mrkg, Wet Retrflc Polyurea, 6 inch, White	LFt	810	\$ _____ = \$ _____	
922	Pavt Mrkg, Wet Retrflc Polyurea, 4 inch, Yellow	LFt	300	\$ _____ = \$ _____	
923	Pavt Mrkg, Wet Retrflc Thermopl, 12 inch, Crosswalk	LFt	1,850	\$ _____ = \$ _____	
924	Pavt Mrkg, Wet Retrflc Thermopl, 12 inch, Cross Hatching, White	Lft	40	\$ _____ = \$ _____	
925	Pavt Mrkg, Wet Retrflc Thermopl, 24 inch, Stop Bar	LFt	210	\$ _____ = \$ _____	
926	Pavt Mrkg, Wet Retrflc Thermopl, Symbol	LFt	5	\$ _____ = \$ _____	
927	Pavt Mtkg, Type R, 4 inch, Black	LFt	200	\$ _____ = \$ _____	

BID FORM
 Section 1 - Schedule of Prices
 Project ITB - 4519 - North Fifth Avenue Reconstruction

Total From BF-1 \$ _____
 Total From BF-2 \$ _____
 Total From BF-3 \$ _____
 Total From BF-4 \$ _____
 Total From BF-5 \$ _____
 Total From BF-6 \$ _____
 Total From BF-7 \$ _____

Total Base Bid \$ _____

Alternate Bid Items for Sidewalk Pavers

The following alternate bid prices for installing sidewalk pavers would replace comparable quantities of concrete sidewalk. The City is requesting alternate bid prices for these items.

Item Number	Description	Unit	Quantity	Unit Price	Total Cost
238-2	Concrete Pavement Base, 6 inch (under sidewalk pavers)	Sft	3,200	\$ _____	= \$ _____
241-2	Brick Pavers, New (sidewalk)	Sft	3,200	\$ _____	= \$ _____

Total of Alternate Bid \$ _____

Contractor: _____

**DETAILED SPECIFICATION
FOR
ITEM #220 – HMA PAVEMENT BASE COURSE
ITEM #221 - HMA PAVEMENT LEVELING
ITEM #222 - HMA PAVEMENT WEARING
ITEM #224 – HAND PATCHING**

DESCRIPTION

This work shall consist of constructing HMA pavement base, leveling, and wearing courses, and hand patching, in accordance with Division 5 and Section 501 of the 2012 MDOT Standard Specifications, current supplemental MDOT specifications, and the City Standard Specifications, except as modified herein, and as directed by the Engineer.

MATERIALS

General

The HMA mixtures to be used for this work shall be as follows:

<u>WORK ITEM</u>	<u>THICKNESS</u>	<u>MDOT HMA MIXTURE #</u>
HMA Pavement Wearing	1.5”	5E1
HMA Pavement Leveling	2”	4E1
HMA Pavement Base Course	3”	3E1
Hand Patching (Permanent)	2”/3”	4E1/3E1
Hand Patching (Temporary)	as directed	see note

Binders for the bituminous mixes shall be PG 64-28 or as directed by the Engineer, and shall meet the requirements specified in Section 904 of the 2012 MDOT Standard Specifications, and any current supplemental MDOT specifications.

Bond coat shall be an emulsified asphalt Type SS-1h and shall meet the requirements specified in Section 904 of the 2012 MDOT Standard Specifications, and any current supplemental MDOT specifications.

The use of Marshall Mixes and Cold Patch will be acceptable for use in Hand Patching for areas identified as temporary pavement, at the approval of the Engineer.

The Aggregate Wear Index (AWI) number for this project is 260. This AWI number applies to all aggregates used in all top course mixtures. Blending aggregates to achieve this AWI requirement is permitted in accordance with current MDOT Standards, and Supplemental Specifications. Reclaimed Asphalt Pavement (RAP) in HMA Mixtures

The use of Reclaimed Asphalt Pavement (RAP) in HMA mixtures shall be in accordance with Section 501.02. A. 2 of the 2012 MDOT Standard Specifications, and the City of Ann Arbor Standard Specifications.

CONSTRUCTION METHODS

All concrete work shall be completed prior to placing HMA mixtures.

The Contractor shall have a 10-foot long straight-edge, backhoe, air-compressor and jackhammer available during all paving operations.

Prior to placing the bond coat, the Contractor shall kill all vegetation (within the area to be paved) by applying an approved weed killer ("Round-Up" by Monsanto, or equal), shall thoroughly clean all joints & cracks in the existing pavement (and any gutter to be overlaid) with compressed air and/or vacuum-type street cleaning equipment to remove all dirt and debris to a depth of at least 1-inch, and shall thoroughly clean the entire surface to be paved, with a Vac-All or similar vacuum-type street cleaning equipment.

MDOT SS-1h bond coat shall be applied at a uniform rate of 0.10 gallons/square yard, on all exposed, existing HMA and concrete surfaces which will come in contact with the new HMA material. The Contractor shall take extra care to avoid covering surfaces which are not to be paved. After September 15, SS-1h bond coat shall not be diluted by more than 25%.

The Contractor shall place HMA wedges using the base, leveling, and wearing mixtures specified herein, as directed by the Engineer, prior to placing the wearing course. Such wedging shall be measured and paid for at the respective unit price of the appropriate HMA Pavement item.

Construction of butt joints, where directed by the Engineer, shall be measured and paid for as "Machine Grading Modified."

The Contractor shall construct the pavement courses to provide the final cross-slopes (crowns) specified by the Engineer.

The Contractor shall construct feather joints, and shall feather the leveling and wearing courses at structures, in drive approaches, and at intersection joints, as directed by the Engineer. Feather joints shall vary the thickness of the asphalt from 0.0-inches to the required full paving thickness (approximately 1½-inches) over a 5-foot to 15-foot distance, or as directed by the Engineer. The Contractor shall rake all large aggregates out of the HMA mixture in feather joints, prior to compaction.

The Contractor shall provide a minimum of two rakers during the placement of all wearing and leveling courses. Further, the Contractor shall provide, when directed by the Engineer, a second "Break-Down" roller in order to achieve the specified asphalt densities.

The Contractor shall provide a minimum of 24-hours' notice to the Engineer prior to paving, and shall obtain a "Permit To Pave" from the Engineer in advance of scheduling paving.

The Contractor and Engineer shall carefully observe the paving operation for signs of faulty mixtures. Points of weakness in the surface shall be removed or corrected by the Contractor, at his/her expense, prior to paving subsequent lifts of HMA material. Such corrective action may include the removal and replacement of thin or contaminated sections of pavement, including sections that are weak or unstable. Once the Contractor or his representative is notified by the Engineer that the material being placed is out of allowable tolerances, or there is a problem with the paving operation, the Contractor shall stop the paving operation at once, and shall not be permitted to continue placing HMA material until again authorized by the Engineer. Substandard work that, in the Engineer's opinion, requires removal and replacement, shall be completed as follows:

1. Remove and replace leveling and/or wearing course areas mixed with foreign materials and defective areas.
2. Sawcut full depth of existing pavement in perpendicular and parallel directions to adjoining surfaces to ensure a quality and aesthetically pleasing repair.

3. Replacement may need to extend beyond the area of repair. Cut out such areas and fill with fresh, hot mix asphalt.
4. Compact by rolling to specified density and smoothness.
5. Sawcut or route new joint and fill with specified Hot Poured Rubber Joint Sealer product.

During the placement of leveling and wearing courses, the speed of the paving machine(s) shall not exceed 50-feet per minute.

The Contractor shall furnish and operate enough materials and equipment so as to keep the paving machine(s) moving continuously at all times. Failure to do so shall be cause for the suspension of the paving operation until the Contractor can demonstrate to the satisfaction of the Engineer, that sufficient resources have been dedicated to perform the work in accordance with the specifications.

Each layer of HMA mixture shall be compacted to between 92 to 96 percent (or as determined acceptable by the Engineer) of the theoretical maximum density, as listed on the approved Job Mix Formula.

MEASUREMENT AND PAYMENT

Measurement of these HMA paving items shall be by the ton, in place. Unused portions of material loads shall be returned to the plant and re-weighed, and the corrected weight slip shall be provided to the Engineer. All weight slips must include the type of mixture (codes are not acceptable), as well as vehicle number, gross weight, tare weight and net weight.

The bond coat is included in the cost of the HMA Pavement Item.

Corrective action shall be enforced as described at Division 5 of the 2012 MDOT Standard Specifications and will be based on the City's or DDA's testing reports.

All costs for furnishing and operating vacuum-type street cleaning equipment, backhoes, jackhammers, and air compressors shall be included in the bid prices for these items of work or in the item of work "General Conditions."

The completed work as measured for these items of work will be paid for at the Contract Unit Prices for the following Contract (Pay) Items:

<u>PAY ITEM</u>	<u>PAY UNIT</u>
All HMA Pavement Items.....	Ton



The unit prices for these items of work shall include all labor, material, and equipment costs to perform all the work specified in the Standard Specifications and as modified by this detailed Specification.

Payment Adjustment In Lieu Of Repair/Replacement

In the case that the work that is installed does not meet the specified quality of materials or installation, the DDA may opt to require the full removal and replacement of the substandard work, or, at their discretion, use the formulas listed below to reduce payment for the work.

- A. Pavement Compaction:
 1. Pavement

- a. If the daily average in place density is less than 94%, but greater than 93% of the mixture theoretical maximum density (TMD) the paving will be evaluated by the Engineer and Owner and at Owner's discretion, the unit price of that days paving will be reduced to 90% of full payment.
- b. If the daily average in place density is less than 93% but greater than 92% of the mixture TMD the paving will be evaluated by the Engineer and Owner and at Owner's discretion may either be removed or the unit price of that days paving will be reduced to 75% of full payment.
- c. If the daily average in place density is less than 92% of the mixture TMD the paving will be removed and replaced at no cost to Owner.

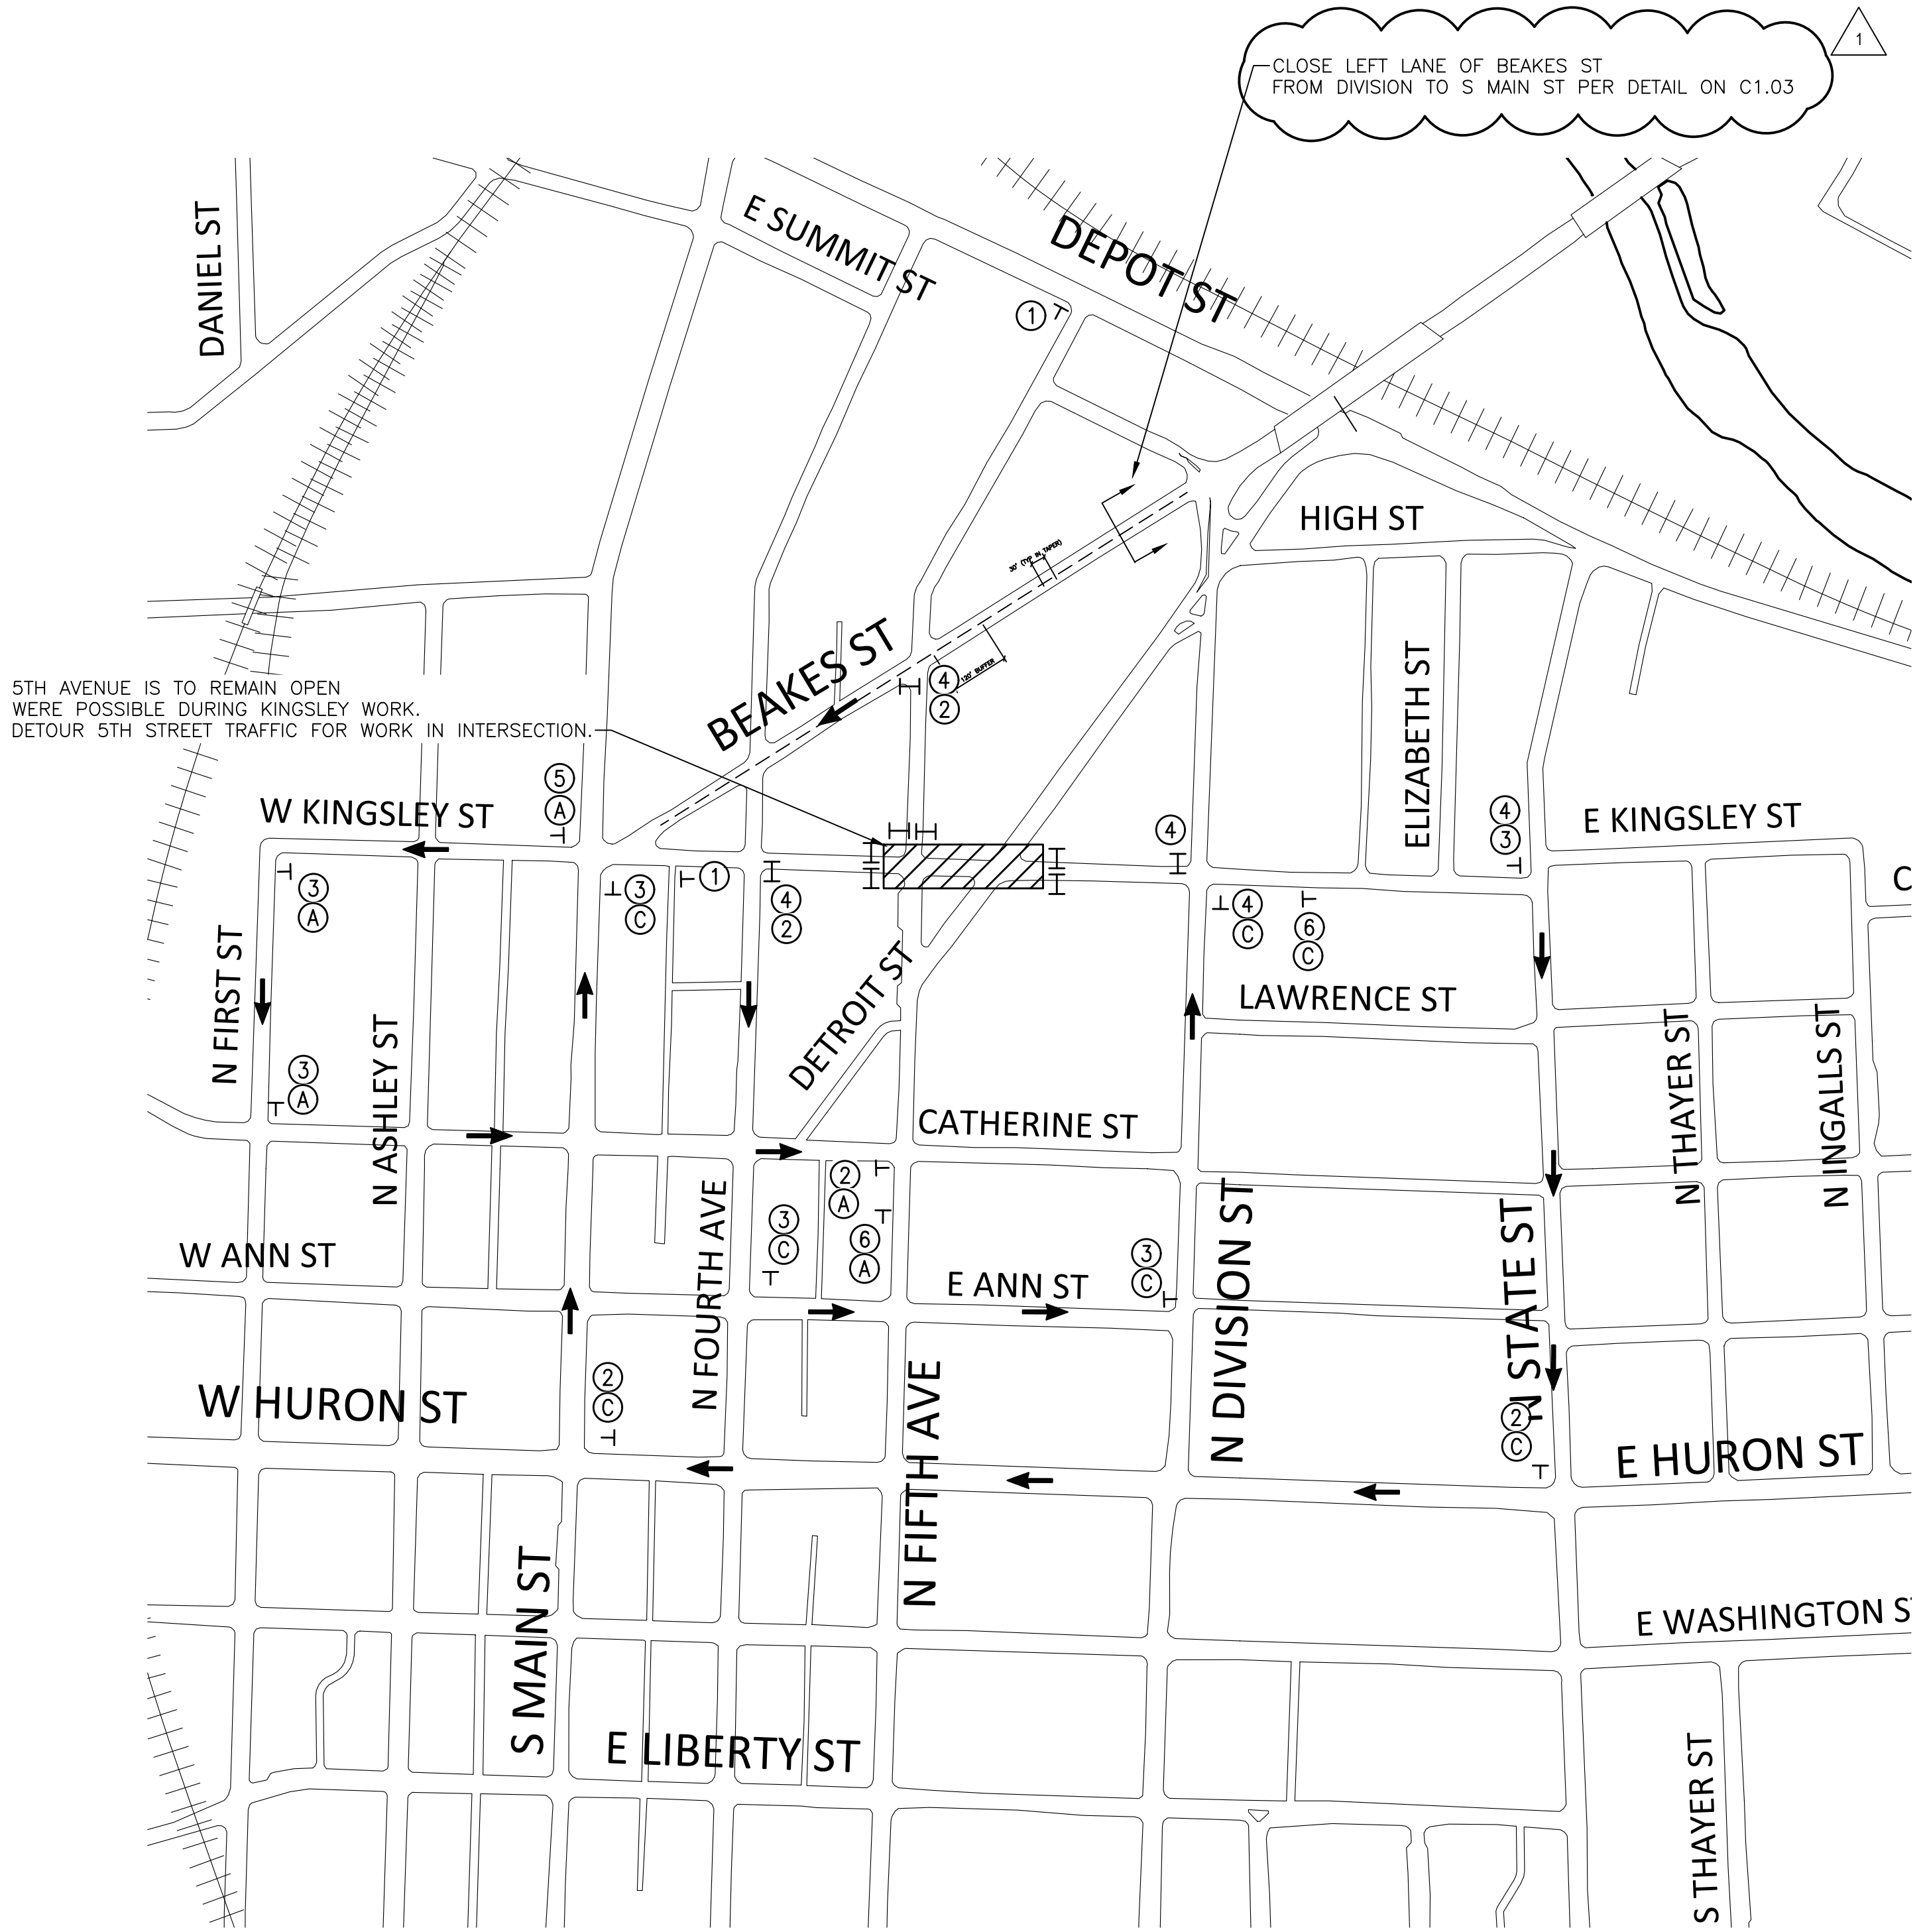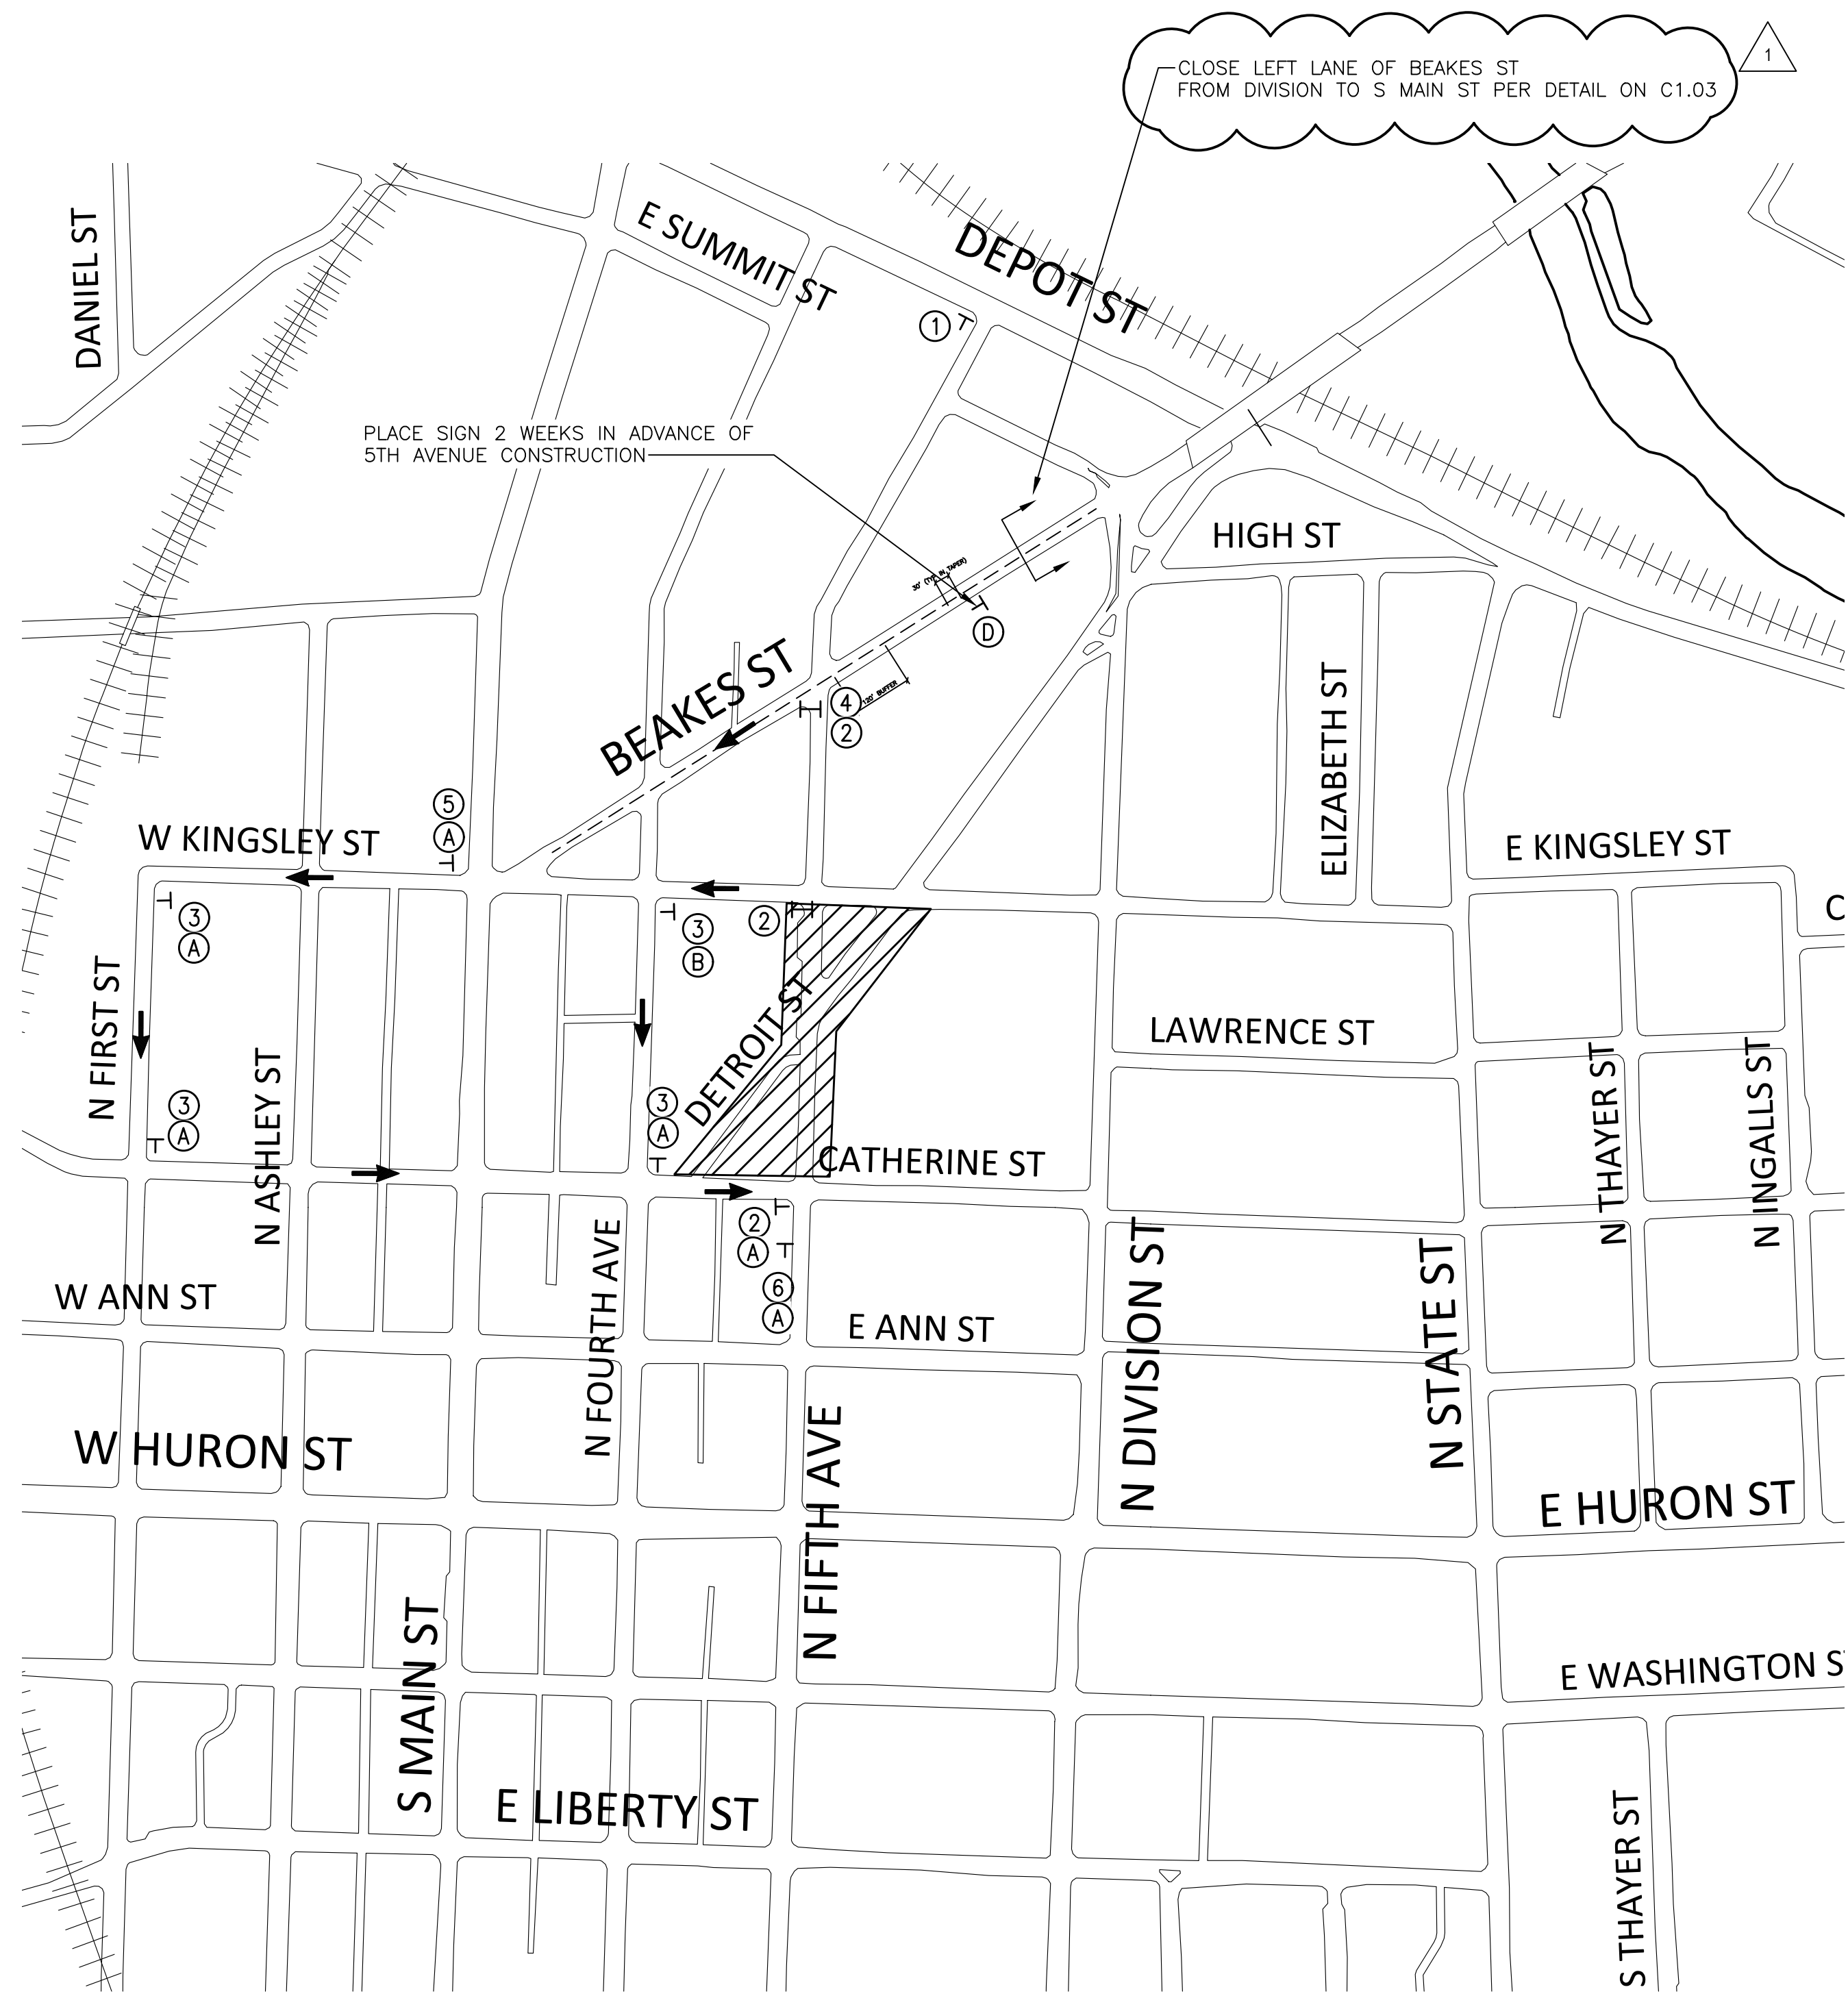

DETOUR PLAN - 5TH AVENUE CLOSURE
 SCALE: 1" = 100'
 0 50 100 200


DETOUR PLAN - KINGSLEY STREET CLOSURE
 SCALE: 1" = 100'
 0 50 100 200

- LEGEND**
- WORK ZONE
 - DIRECTION OF TRAFFIC
 - TYPE III BARRICADE
 - TEMP CONSTRUCTION SIGN
 - PORTABLE CHANGEABLE MESSAGE SIGN (PCMS)
 - PEDESTRIAN DETOUR
 - TEMPORARY CONSTRUCTION FENCING (6' TALL CHAIN LINK, MOVABLE)

- LEGEND**
- ROAD CLOSED AHEAD (W20-3)
 - DETOUR (M4-9R)
 - ROAD CLOSED TO THRU TRAFFIC (R11-4)
 - END DETOUR (M4-8c)
 - 5TH AVE (SP #1)
 - CATHERINE ST (SP #2)
 - KINGSLEY ST (SP #3)
 - 5TH AVENUE CLOSED TO THRU TRAFFIC BEGINNING (SP #4)

DOWNTOWN DEVELOPMENT AUTHORITY - CITY OF ANN ARBOR	
DETOUR PLAN	SCALE: NOT TO SCALE INCH
DRAWING NO. C1.01	SHEET NO. ___ OF ___

SEE ABOVE	BENCH MARK	SURVEY BOOK	REV. NO.	DESCRIPTION	DATE	DR. BY	CH. BY
				ADDENDUM NO 1	01-04-2018		
				BID PLANS	12-01-2017		
				95% CD	11-17-2017		

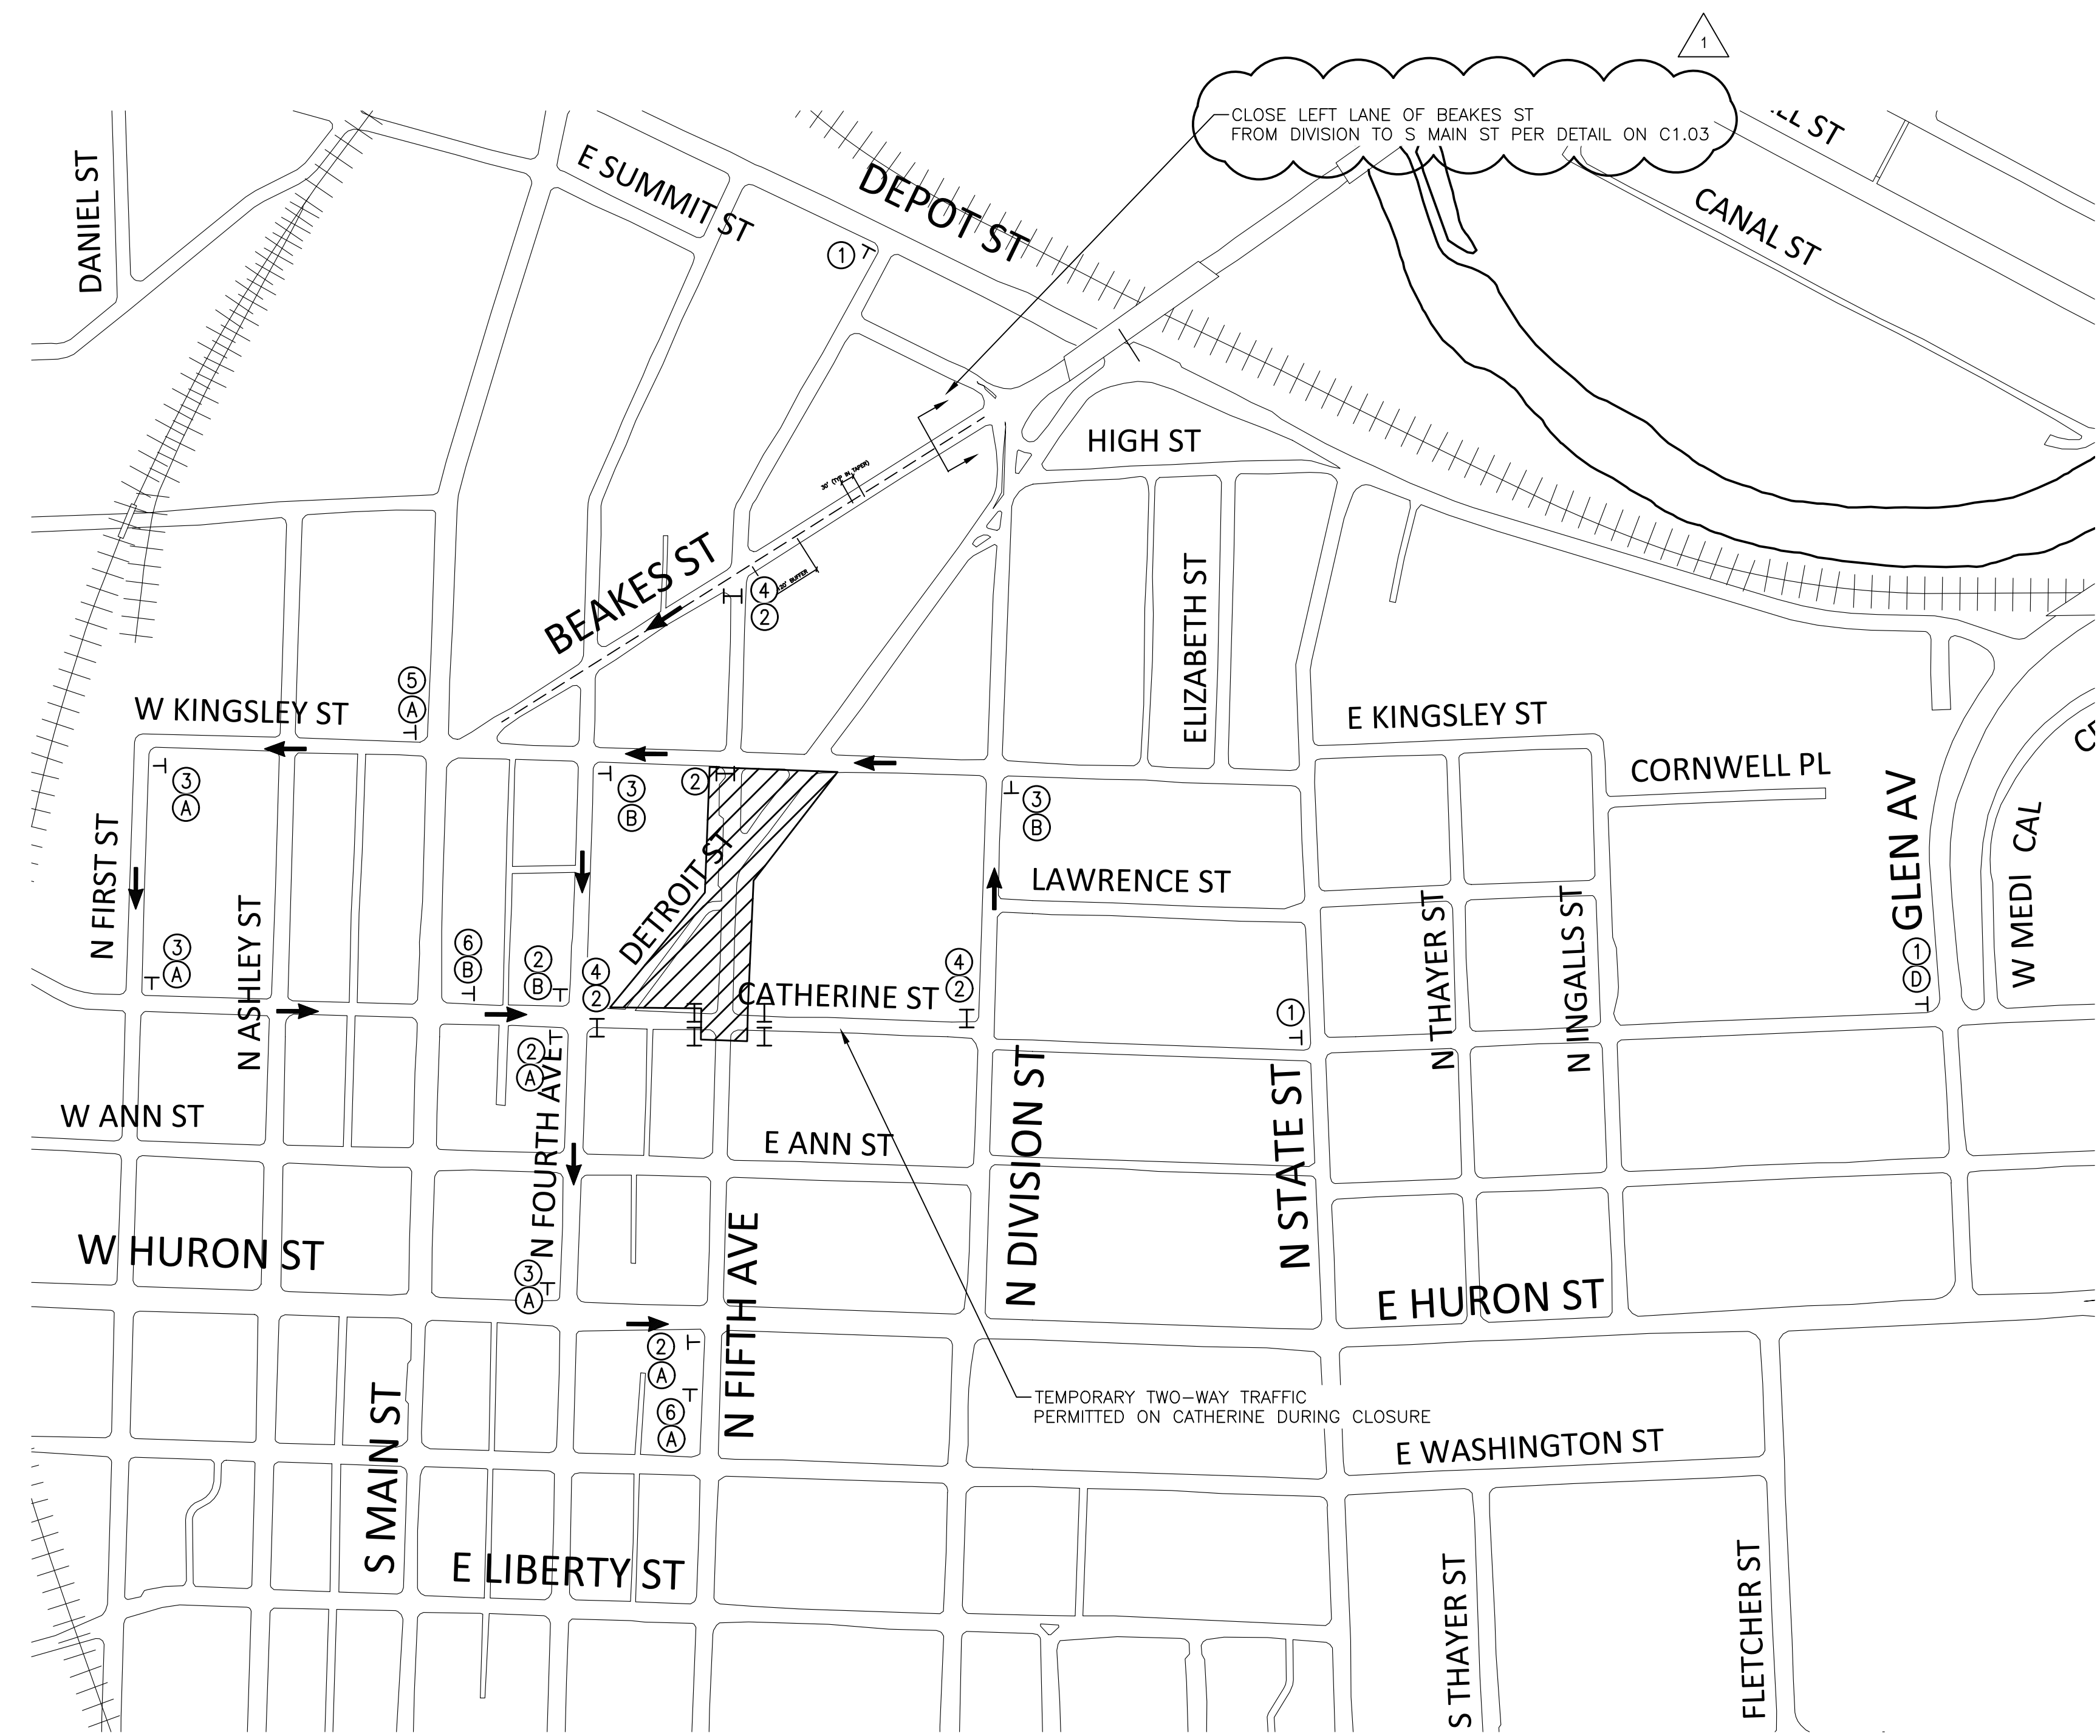

DETOUR PLAN - 5TH & CATHERINE STREETS CLOSURE
 SCALE: 1" = 100'
 NORTH

LEGEND

- WORK ZONE
- DIRECTION OF TRAFFIC
- TYPE III BARRICADE
- TEMP CONSTRUCTION SIGN
- PORTABLE CHANGEABLE MESSAGE SIGN (PCMS)
- PEDESTRIAN DETOUR
- TEMPORARY CONSTRUCTION FENCING (6' TALL CHAIN LINK, MOVABLE)


LEGEND

- ①
- ③
- ⑤
- A
- C
- ②
- ④
- ⑥
- B
- D



LEGEND

DOWNTOWN DEVELOPMENT AUTHORITY - CITY OF ANN ARBOR	
DETOUR PLAN	SCALE NOT TO SCALE
C1.02	INCH
DRAWING NO.	SHEET NO. OF


SEE ABOVE	REV. NO.	DESCRIPTION	DATE	DR. BY	CH. BY
△	ADDENDUM NO 1		01-04-2018		
	BID PLANS		12-01-2017		
	95% CD		11-17-2017		

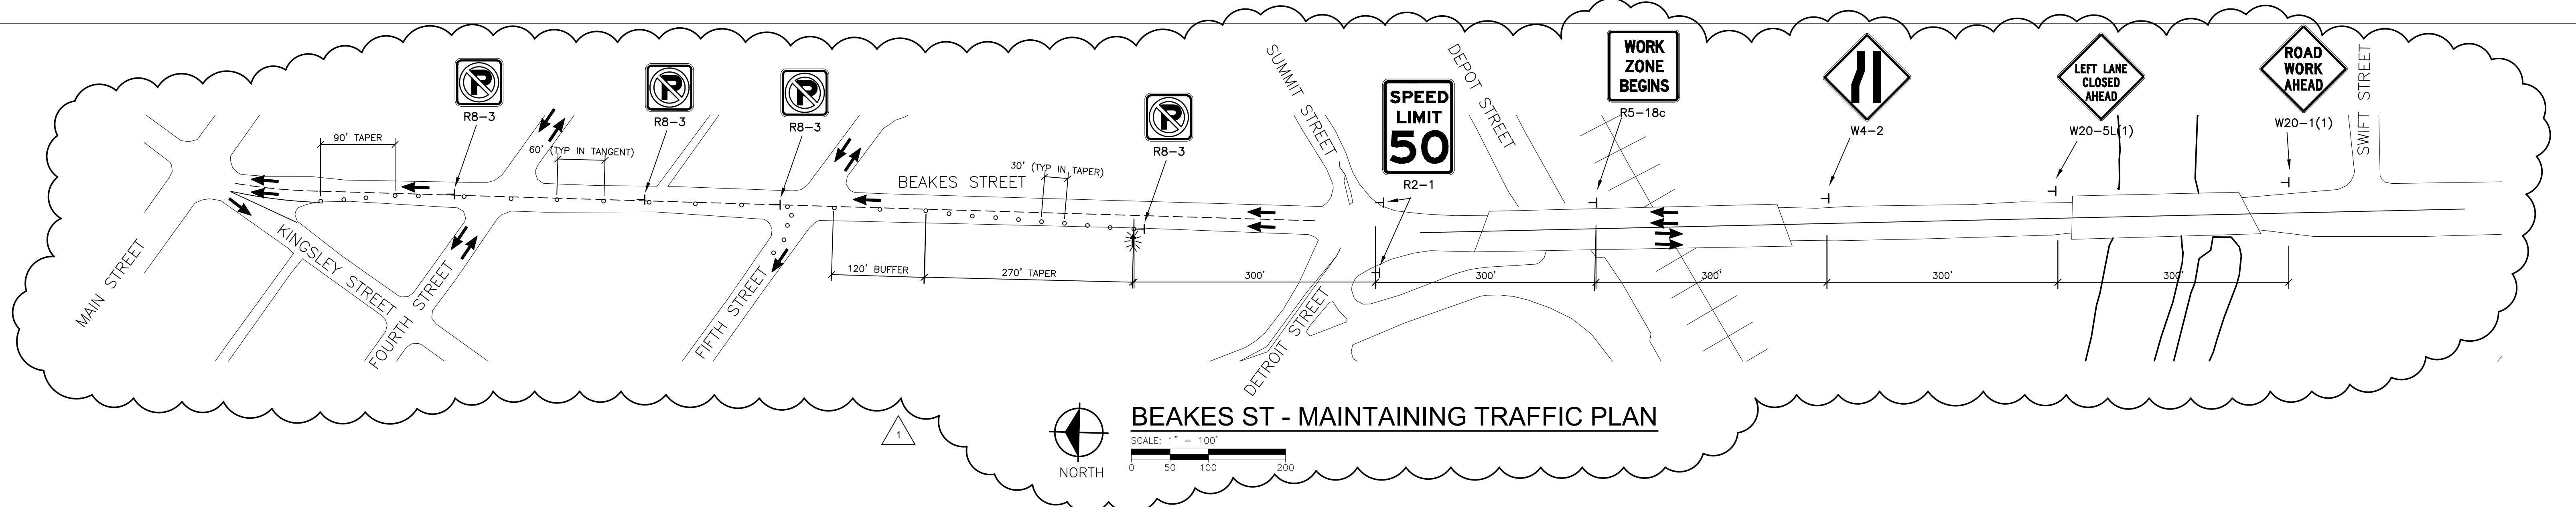

BEAKES ST - MAINTAINING TRAFFIC PLAN

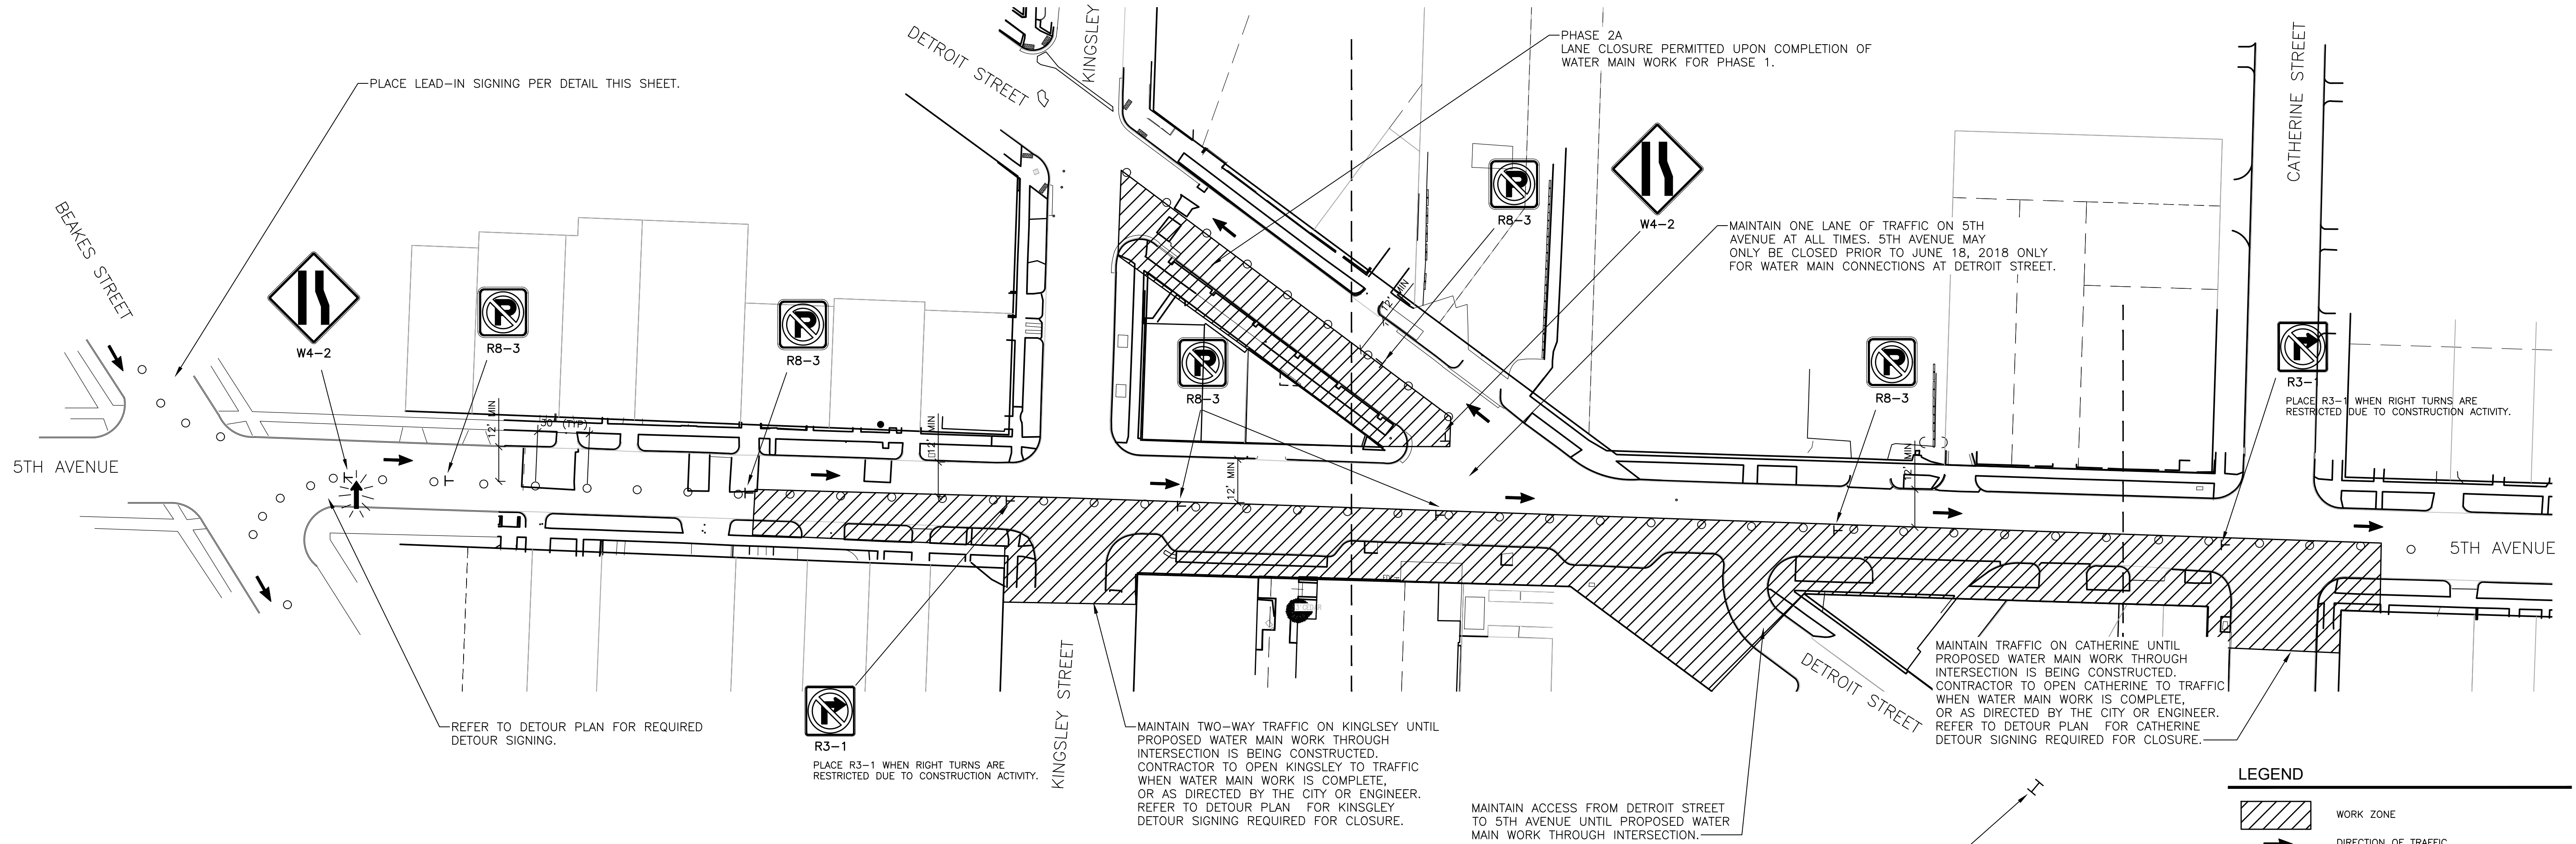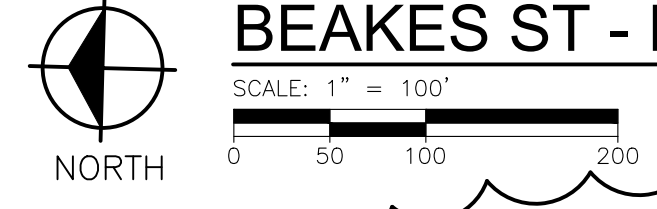

PHASE 1 & 2A - MAINTAINING TRAFFIC PLAN

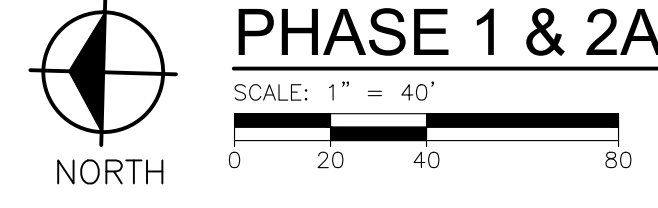

LEGEND

	WORK ZONE
	DIRECTION OF TRAFFIC
	TYPE III BARRICADE
	TEMP CONSTRUCTION SIGN
	PORTABLE CHANGEABLE MESSAGE SIGN (PCMS)
	PEDESTRIAN DETOUR
	TEMPORARY CONSTRUCTION FENCING (6' TALL CHAIN LINK, MOVABLE)
	LIGHTED ARROW, TYPE C

- NOTES**
- LOCATIONS OF THE SIGNS AND PORTABLE CHANGEABLE MESSAGE SIGNS TO BE APPROVED BY THE ENGINEER.
 - PERFORM WATER MAIN TIE-INS UTILIZING FLAG CONTROL INCLUDED IN PAYMENT FOR MINOR TRAFFIC DEVICES.

LEGEND


SEE ABOVE	SURVEY BOOK	REV. NO.	DESCRIPTION	DATE	DR. BY	CH. BY
ADDENDUM NO 1				01-04-2018		
BID PLANS				12-01-2017		
95% CD				11-17-2017		

DOWNTOWN DEVELOPMENT AUTHORITY - CITY OF ANN ARBOR

MAINTENANCE OF TRAFFIC PLAN


SCALE	INCH
NOT TO SCALE	
DRAWING NO.	C1.03
SHEET NO.	OF

APPROVED BY _____

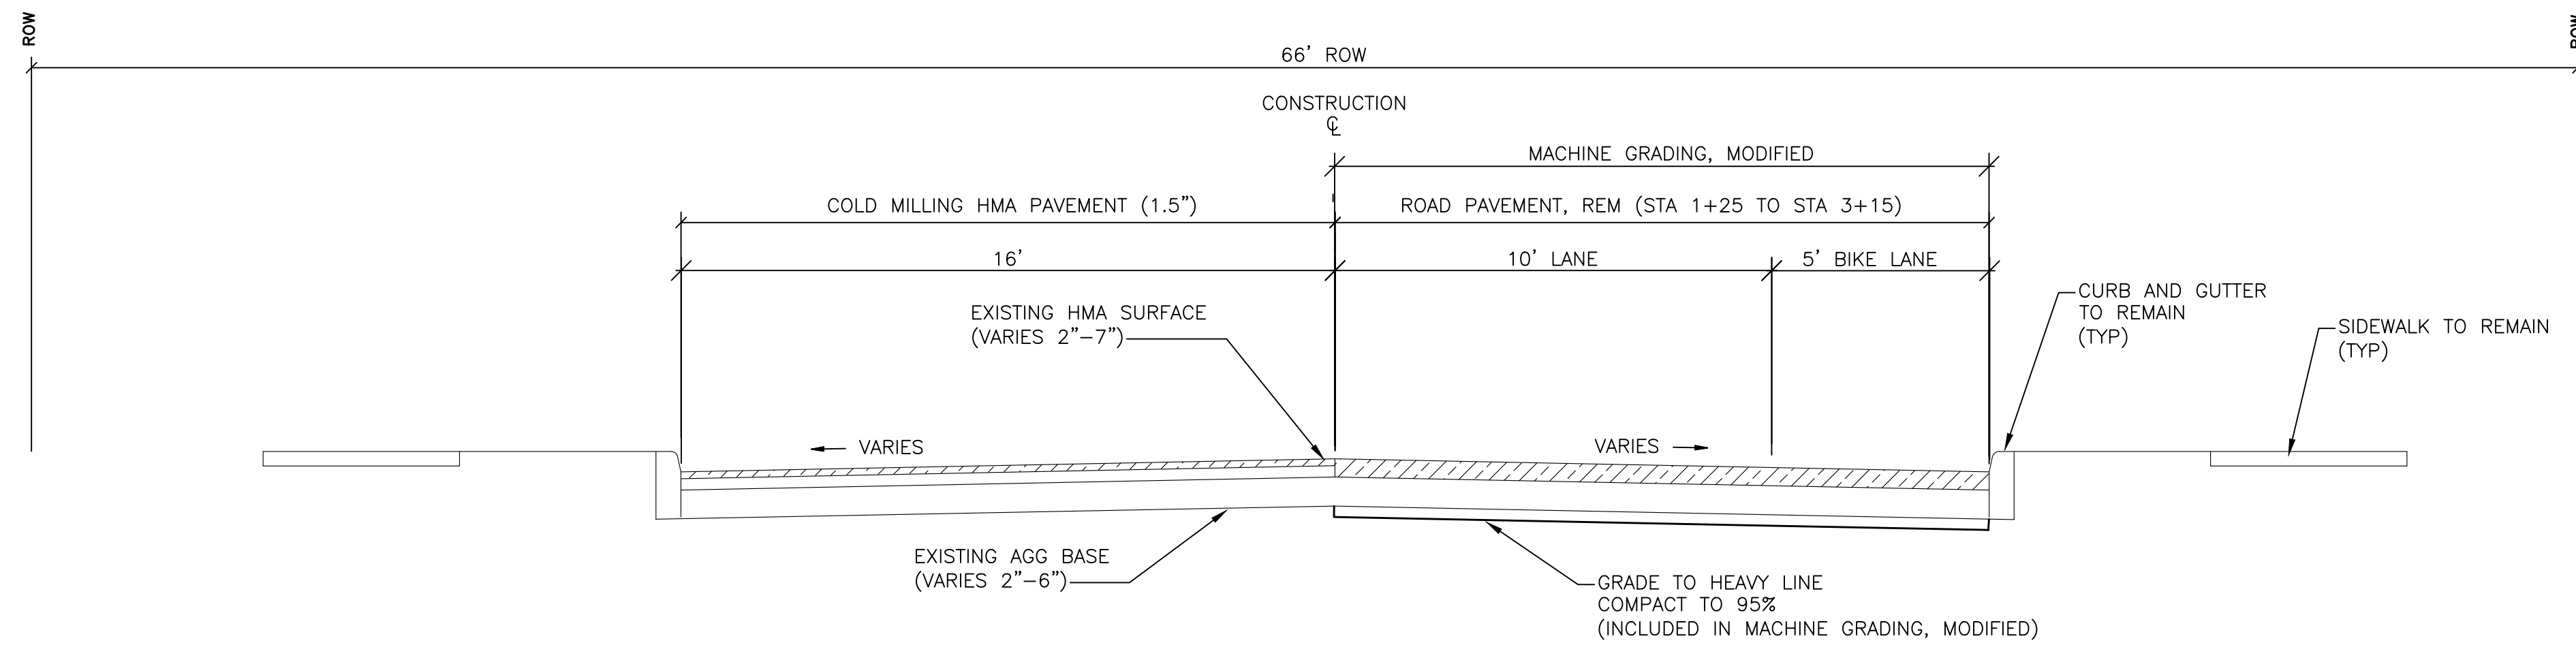

N FIFTH AVE - EXISTING CROSS SECTION

APPLY TO STATIONS 1+25 TO 3+00
NO SCALE

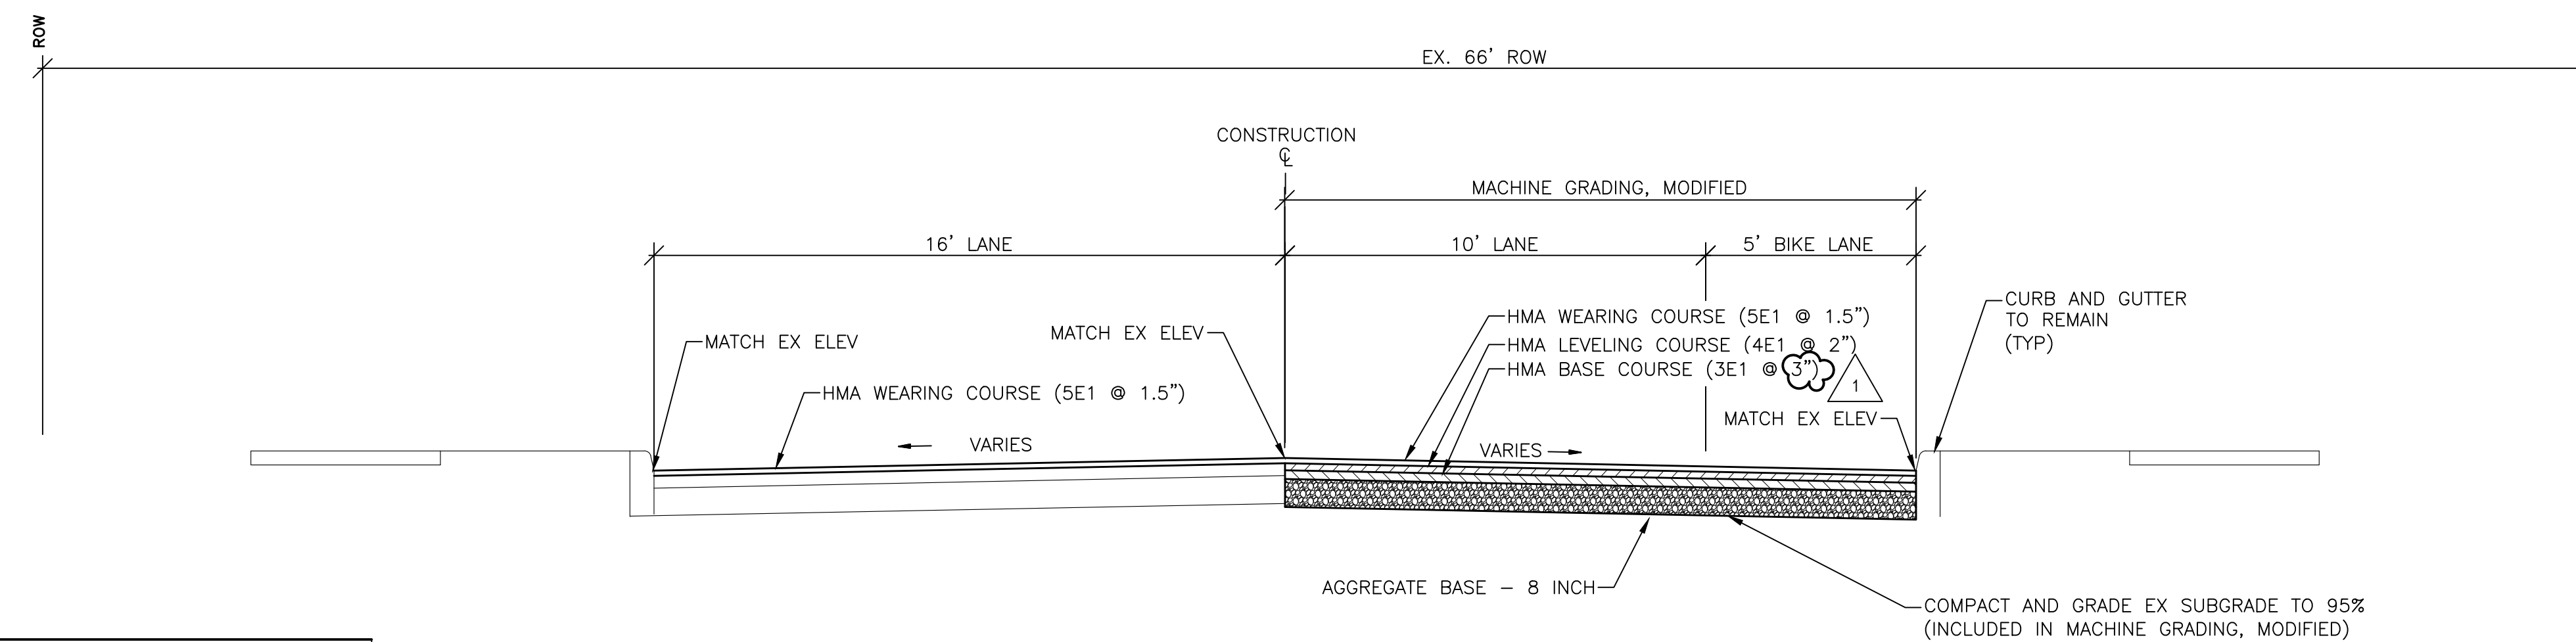


N FIFTH AVE - PROPOSED CROSS SECTION

APPLY TO STATIONS 1+25 TO 3+00
NO SCALE

HMA APPLICATION CHART			
PAY ITEM	EST RATE OF APPLICATION PER SYD	PERFORMANCE GRADE	AWI
HMA WEARING COURSE (5E1)	165 LBS	64-28	260 (TOP)
HMA LEVELING COURSE (4E1)	220 LBS	64-28	
HMA BASE COURSE (3E1)	330 LBS	64-28	
HAND PATCHING (4E1, 3E1)	550 LBS	64-28	
* BOND COAT	.05-.15 GAL		

* FOR INFORMATION ONLY

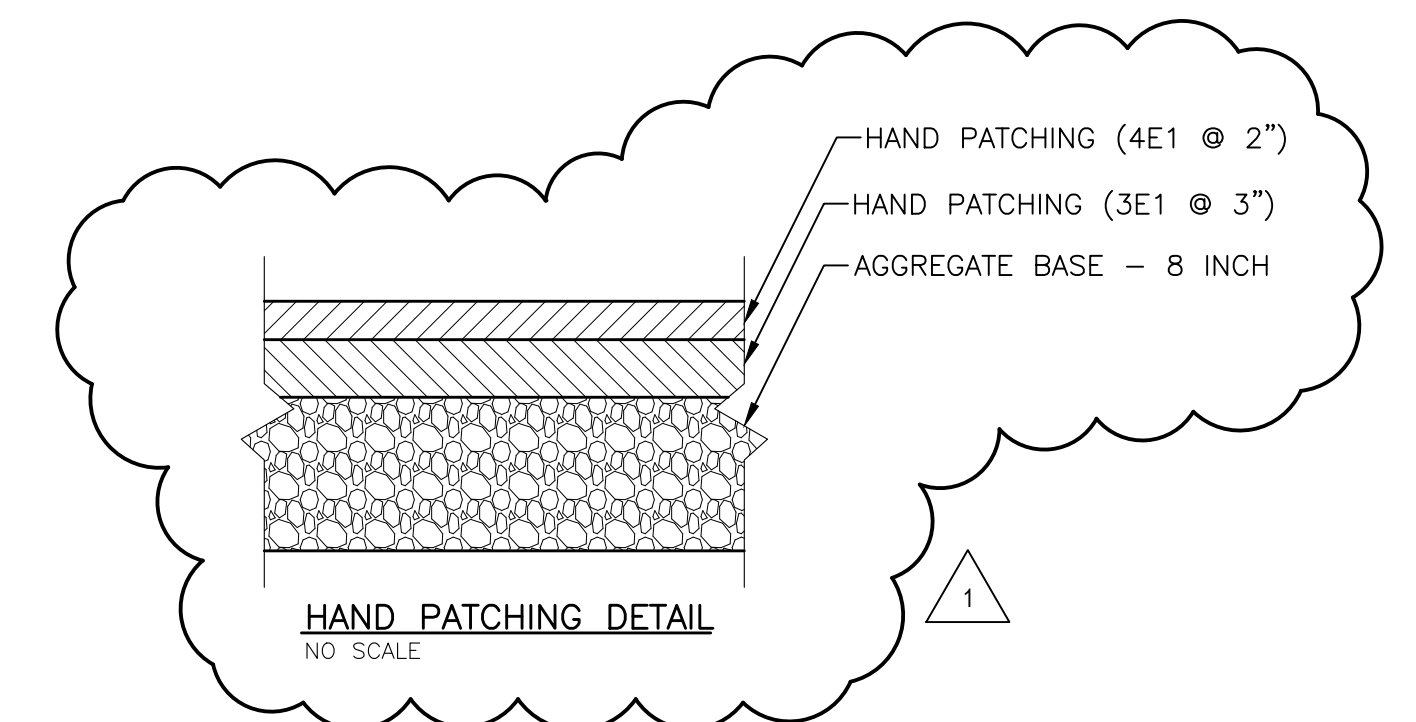

LEGEND


SEE ABOVE	SURVEY BOOK	REV. NO.	DESCRIPTION	DATE	DR. BY	CH. BY
△			ADDENDUM NO 1	01-04-2018		
			BID PLANS	12-01-2017		
			95% CD	11-17-2017		

DOWNTOWN DEVELOPMENT AUTHORITY - CITY OF ANN ARBOR

**N FIFTH AVENUE
TYPICAL SECTIONS**

SCALE NONE	INCH []
DRAWING NO. C3.00	
SHEET NO. ___ OF ___	

APPROVED BY _____

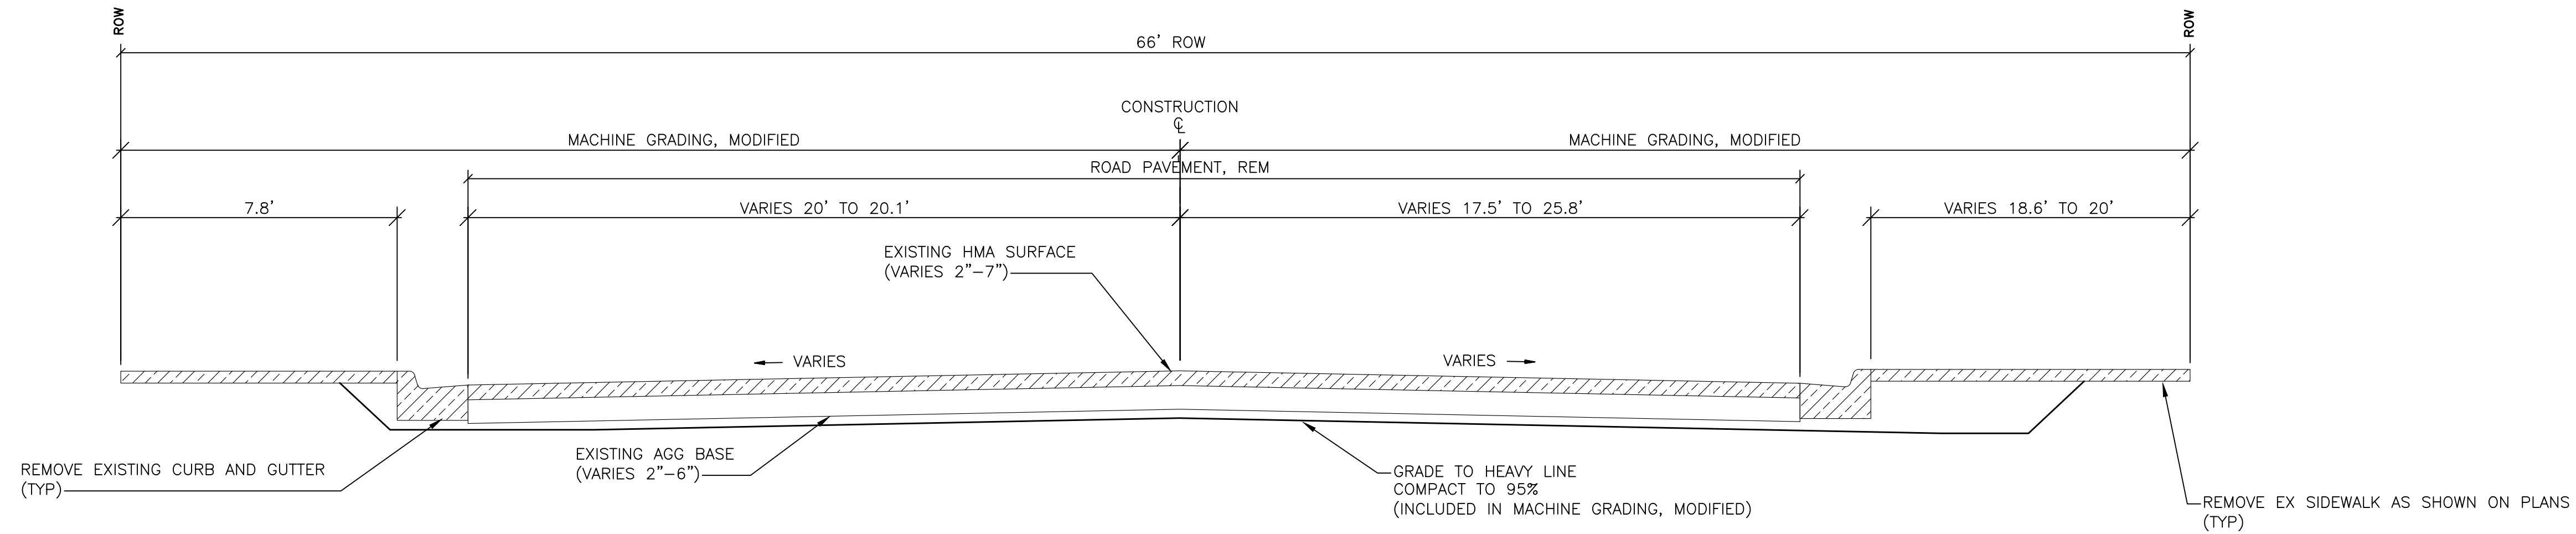


N FIFTH AVE - EXISTING CROSS SECTION

APPLY TO STATIONS 3+00 TO 4+77, 6+09 TO 8+72
NO SCALE

(1) PARKING LANE TABLE

STATION	PARKING WIDTH
3+37 TO 3+49	VARIES 0' TO 6.5'
3+49 TO 4+28	6.5'
4+28 TO 4+36	VARIES 6.5' TO 0'
7+55 TO 7+67	VARIES 0' TO 6.5'
7+67 TO 8+39	6.5'
8+39 TO 8+51	VARIES 6.5' TO 0'

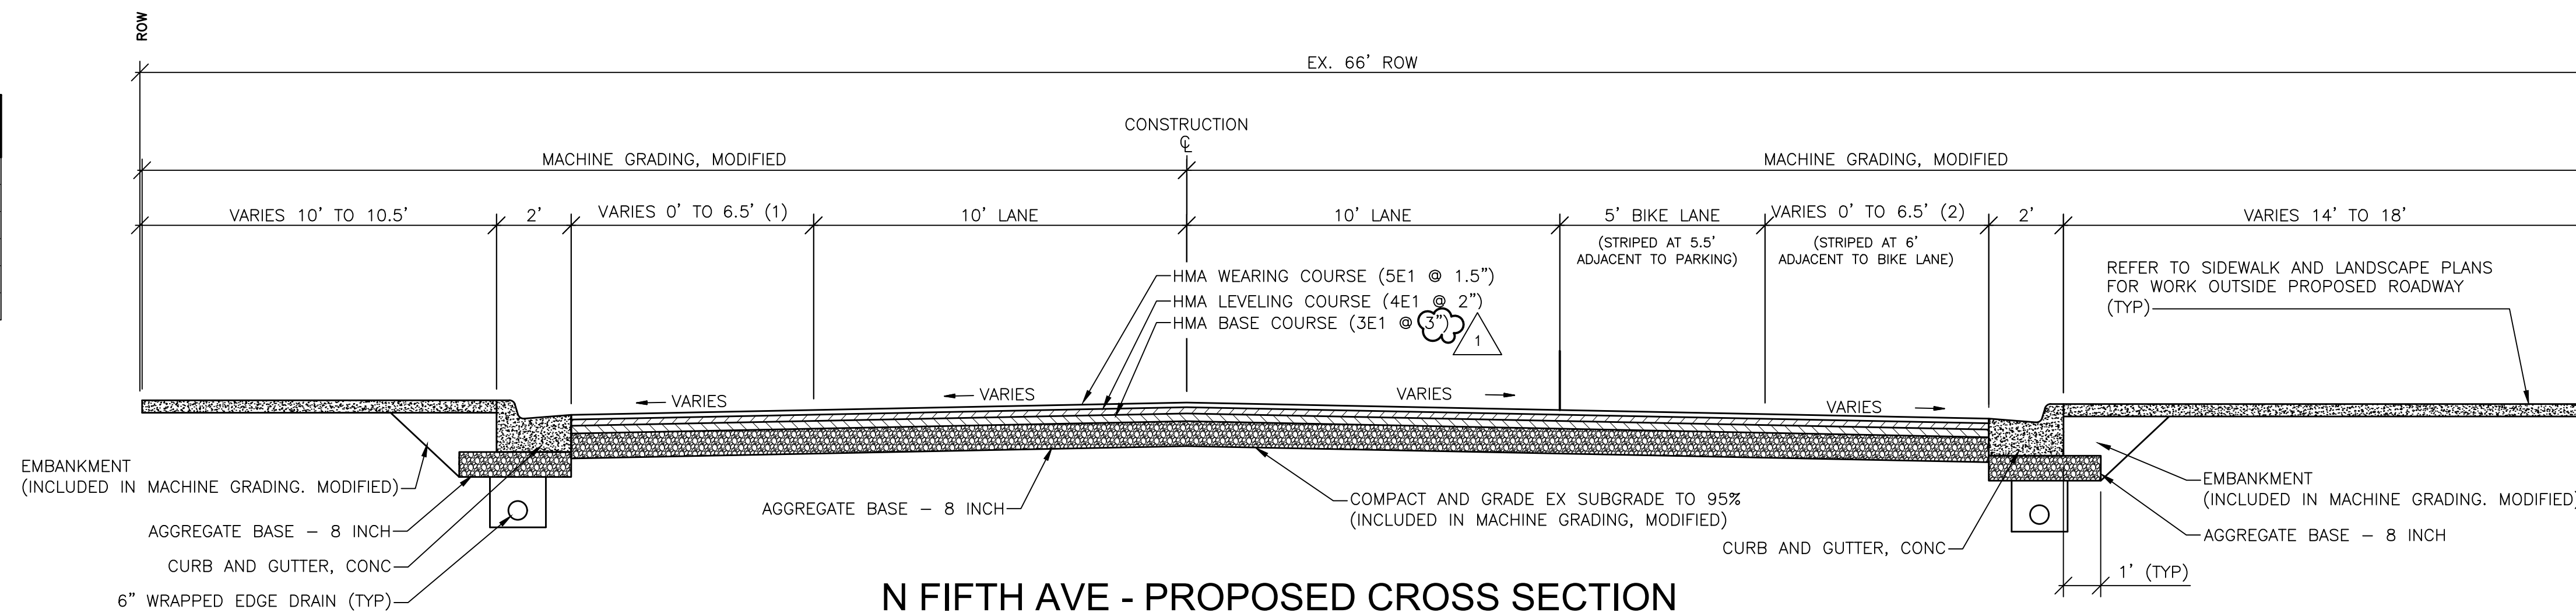

N FIFTH AVE - PROPOSED CROSS SECTION


APPLY TO STATIONS 3+38 TO 4+35, 7+06 TO 8+72
NO SCALE

(2) PARKING LANE TABLE

STATION	PARKING WIDTH
3+37 TO 3+49	VARIES 0' TO 6.5'
3+49 TO 4+28	6.5'
4+28 TO 4+36	VARIES 6.5' TO 0'
7+06 TO 7+20	VARIES 0' TO 6.5'
7+20 TO 7+36	6.5'
7+36 TO 7+50	VARIES 6.5' TO 0'

CROSS-SLOPE TABLE

STATION	LEFT SIDE CROSS-SLOPE	RIGHT SIDE CROSS-SLOPE
3+30 TO 3+80	TRANSITION FROM -2.57% TO 2%	TRANSITION FROM -3.41% TO -2%
3+80 TO 4+42	2%	-2%
6+33 TO 7+20	-2%	-2%
7+20 TO 7+70	TRANSITION FROM -2% TO 2%	-2%
7+70 TO 8+38	2%	-2%
8+38 TO 8+63	TRANSITION FROM 2% TO -2.02%	TRANSITION FROM -2% TO -5.08%

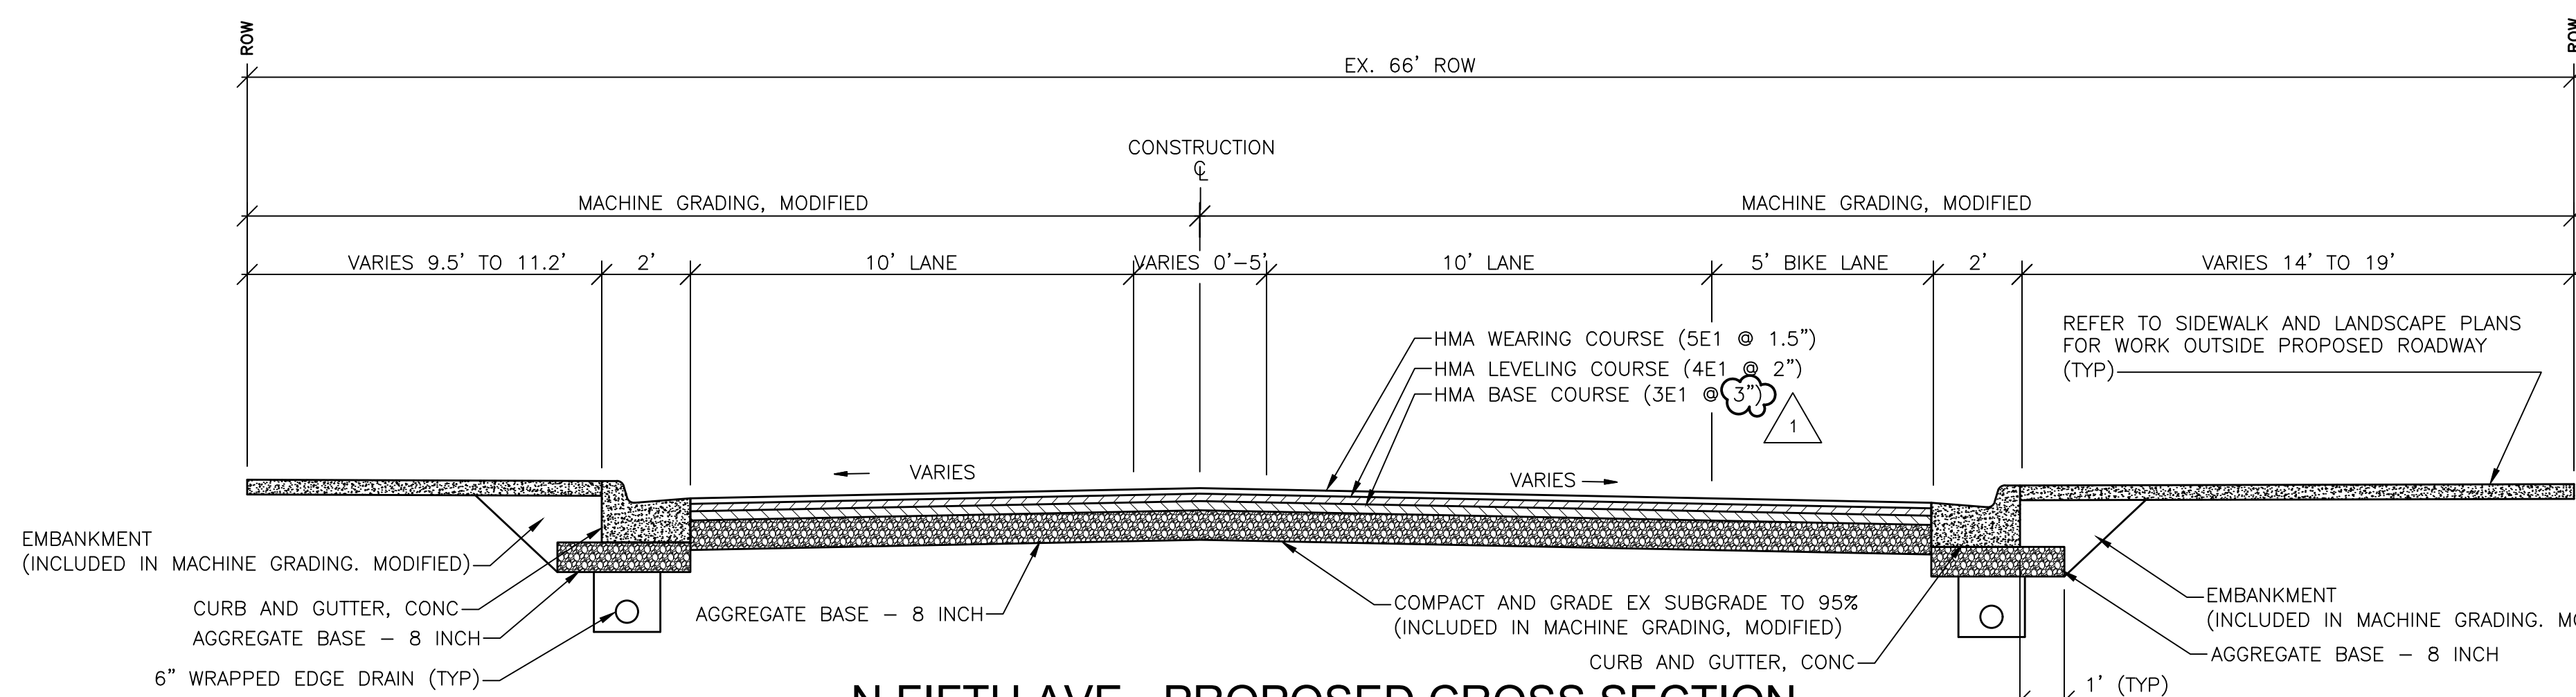

N FIFTH AVE - PROPOSED CROSS SECTION

APPLY TO STATIONS 3+00 TO 3+38, 4+35 TO 4+77, 6+09 TO 7+06
NO SCALE

LEGEND

SEE ABOVE	REV. NO.	DESCRIPTION	DATE	DR. BY	CH. BY
△		ADDENDUM NO 1	01-04-2018		
		BID PLANS	12-01-2017		
		95% CD	11-17-2017		

DOWNTOWN DEVELOPMENT AUTHORITY - CITY OF ANN ARBOR


**N FIFTH AVENUE
TYPICAL CROSS SECTIONS**

SCALE: NONE INCH

DRAWING NO. **C3.01**


SHEET NO. ___ OF ___

APPROVED BY: _____

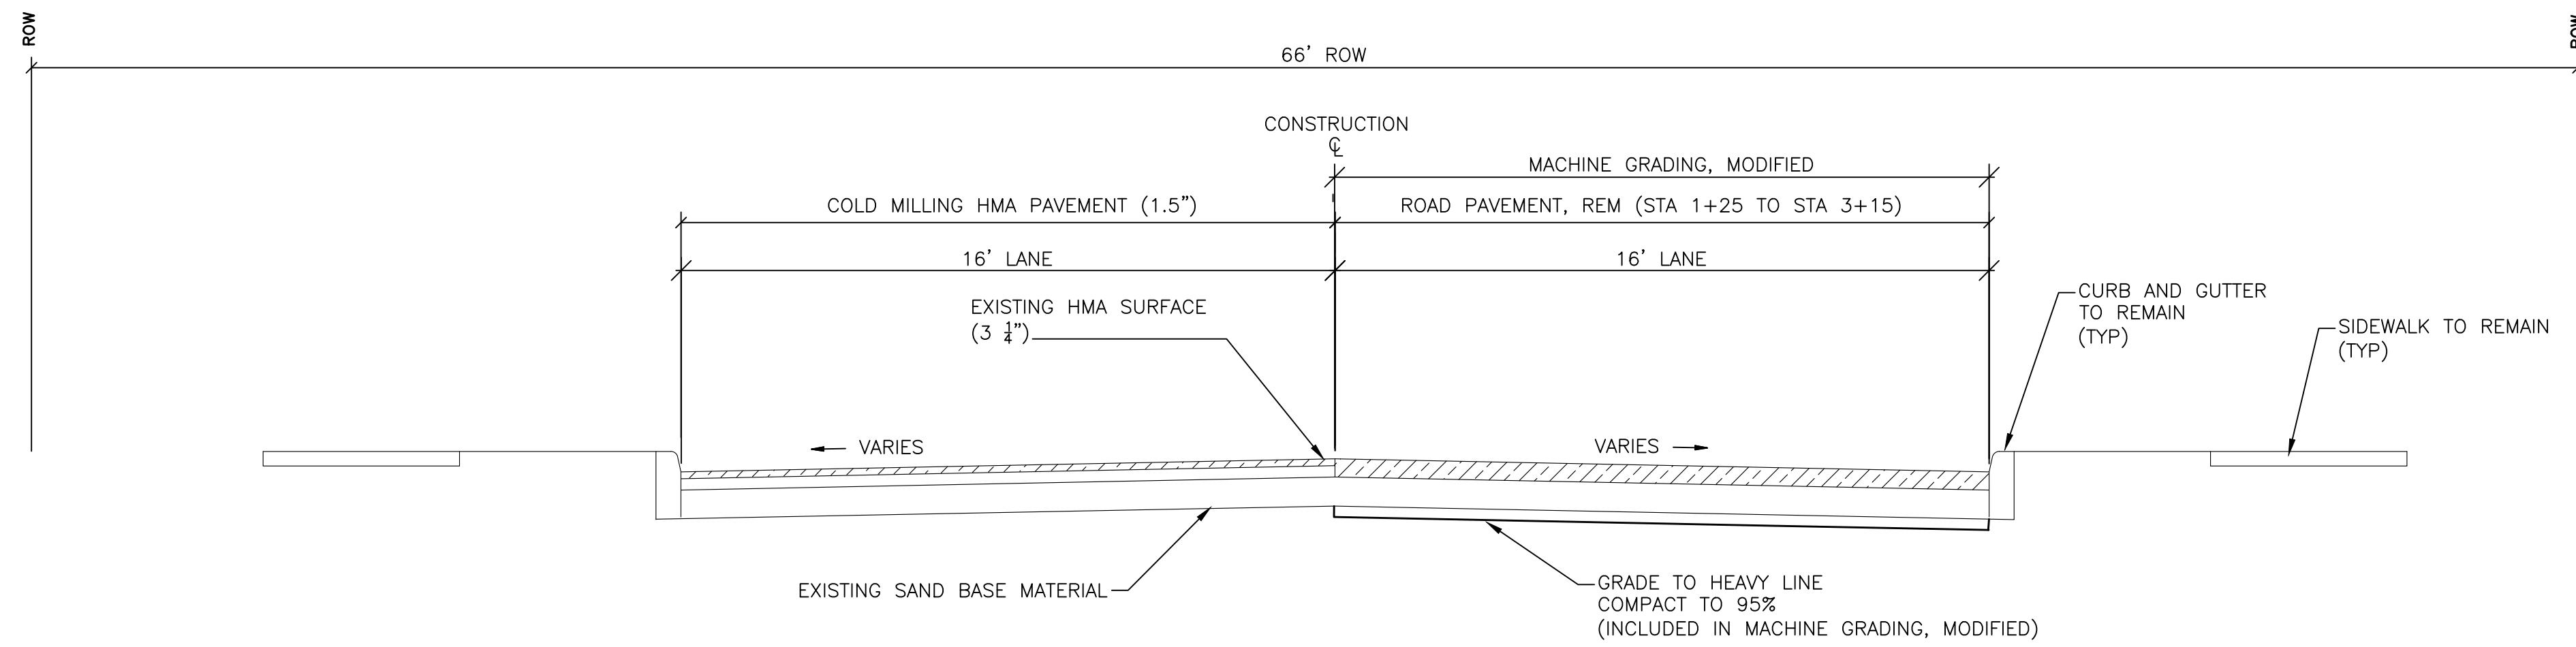

KINGSLEY STREET - EXISTING CROSS SECTION

APPLY TO STATIONS 30+23 TO 33+12
NO SCALE

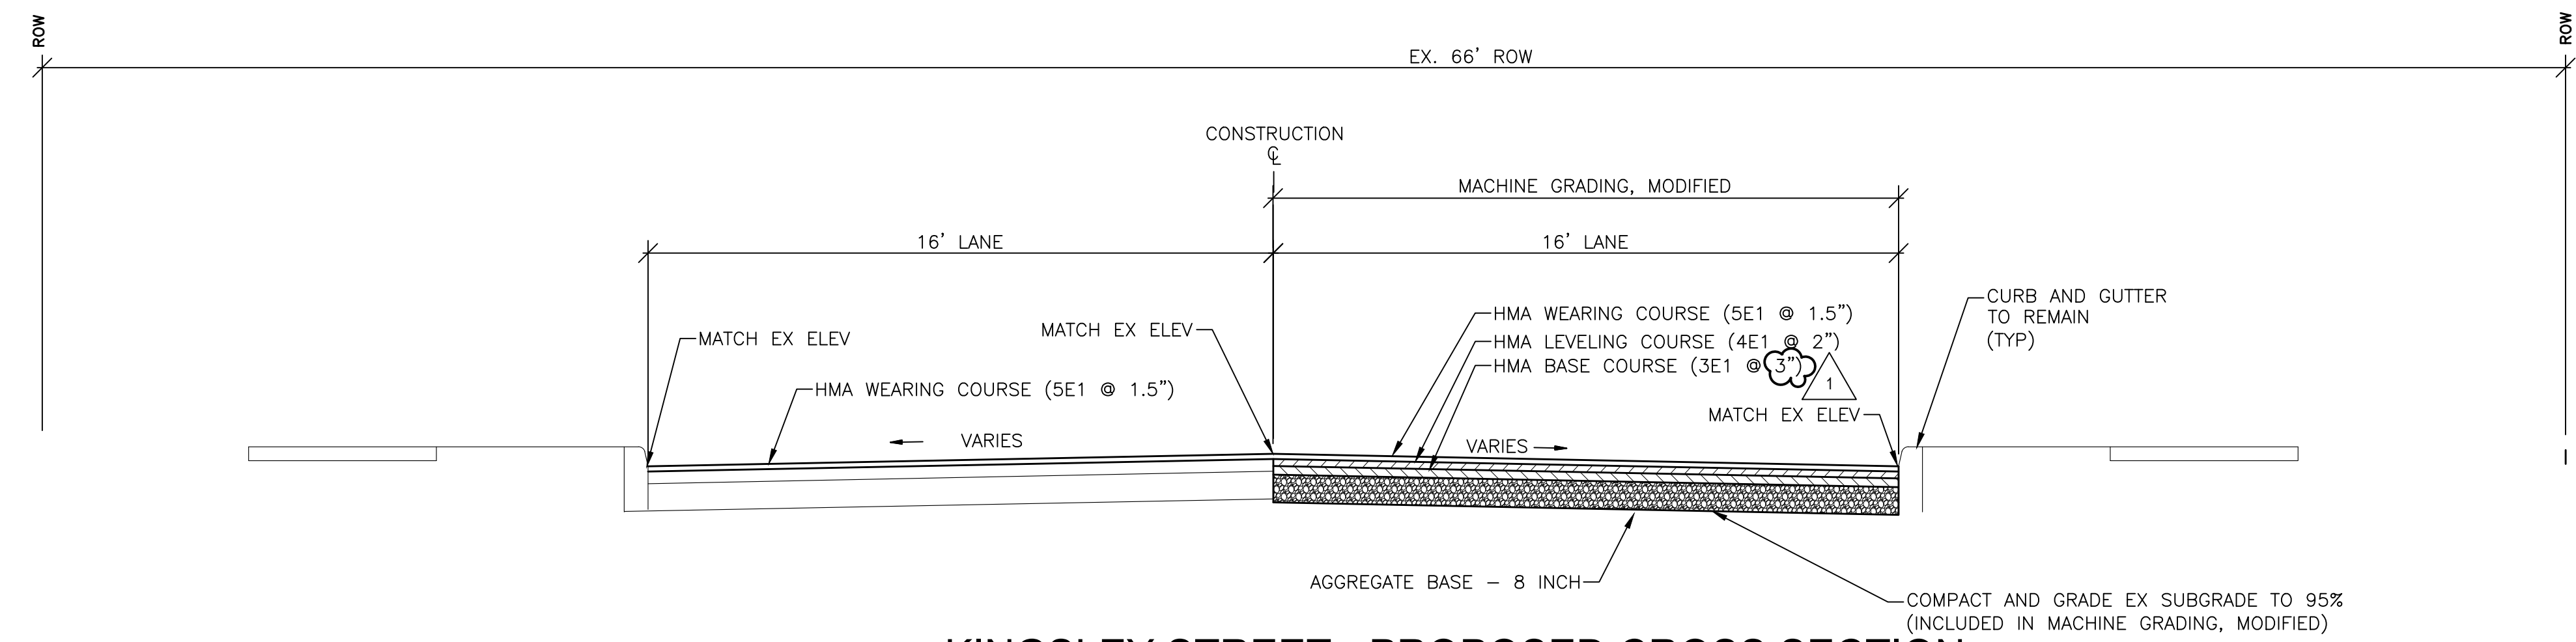

KINGSLEY STREET - PROPOSED CROSS SECTION

APPLY TO STATIONS 30+23 TO 33+12
NO SCALE

LEGEND


SEE ABOVE	SURVEY BOOK	REV. NO.	DESCRIPTION	DATE	DR. BY	CH. BY
			ADDENDUM NO 1	01-04-2018		
			BID PLANS	12-01-2017		
			95% CD	11-17-2017		

DOWNTOWN DEVELOPMENT AUTHORITY - CITY OF ANN ARBOR

**KINGSLEY STREET
TYPICAL SECTIONS**


SCALE NONE	INCH [Scale Bar]
DRAWING NO. C3.04	
SHEET NO. ___ OF ___	


APPROVED BY _____

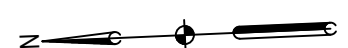

NOTES


- STATION REFERENCES FOR WATER MAIN FITTINGS AND APPURTENANCES ARE IN REFERENCE TO FIFTH AVENUE OR CATHERINE STREET BASELINES.
- ALL MATERIALS, EQUIPMENT AND CONSTRUCTION SHALL BE IN ACCORDANCE WITH THE CURRENT CITY OF ANN ARBOR STANDARD SPECIFICATIONS AND DETAILS. THE OMISSION OF ANY CURRENT STANDARD DETAIL DOES NOT RELIEVE THE CONTRACTOR FROM THIS REQUIREMENT.
- DUCTILE IRON PIPE SHALL BE THICKNESS CLASS 50 WITH POLYETHYLENE WRAP AND PUSH-ON JOINTS, UNLESS OTHERWISE NOTED.
- GATE VALVES SHALL BE RESILIENT-SEATED MECHANICAL JOINT GATE VALVE, WITH 2" SQUARE OPERATING NUT. OPENING RIGHT, COMPLETE WITH ACCESSORIES. GATE VALVE SHALL MEET AWWA SPECIFICATION C509. PLEASE QUOTE ONLY: AMERICAN FLOW CONTROL SERIES 2500 SINGLE RESILIENT WEDGE, GLOW MODEL 2538 (4" THROUGH 16") F-6112, EJM FLOWMASTER RESILIENT WEDGE VALVE, TYTON X TYTON, MUELLER SERIES 4"-12" A-2361-61 RESILIENT WEDGE - SL X SL, U.S. PIPE A-USPT-61 RESILIENT WEDGE VALVE SLXSL FOR FIELD LOK GASKETS.
- MECHANICAL JOINTS MUST MEET AWWA SPECIFICATION C111 AND SHALL INCLUDE PLAIN RUBBER MECHANICAL JOINT GASKETS. PLEASE QUOTE ONLY: AMERICAN PIPE "FAST GRIP" GASKET SYSTEM, GRIFFIN PIPE "FIELD LOK 350" GASKET SYSTEM, OR U.S. PIPE "FIELD LOK 350" GASKET SYSTEM.
- ALL HORIZONTAL BENDS, TEES AND FITTINGS SHALL INCLUDE THRUST BLOCKS. RESTRAINED JOINTS ARE REQUIRED FOR VERTICAL BENDS. (TR-FLEX RESTRAINED JOINT PIPE BY U.S. PIPE, LOK-RING JOINT PIPE BY AMERICAN DUCTILE IRON PIPE, OR APPROVED EQUAL). RESTRAINED JOINT GASKET SYSTEMS MAY ALSO BE USED (FIELD-LOK 350 BY U.S. PIPE, FAST-GRIP BY AMERICAN DUCTILE IRON PIPE, OR APPROVED EQUAL).
- CONTRACTOR TO FOLLOW CITY REQUIREMENTS FOR WATER MAIN TESTING, WATER MAIN PRESSURE/BACTERIA TESTING MATERIAL, AND FEES WILL BE PAID BY THE CONTRACTOR.
- ALL WATER MAIN TO HAVE A TYPICAL 5:5' COVER. MAINTAIN A MINIMUM OF 18" VERTICAL CLEARANCE FOR STORM AND SANITARY CROSSINGS AND A MINIMUM OF 12" VERTICAL CLEARANCE WITH ALL OTHER UTILITIES.
- UNLESS OTHERWISE NOTED, THE CONTRACTOR SHALL UTILIZE STANDARD PIPE DEFLECTIONS FOR FOLLOWING THE PROPOSED ALIGNMENT.
- NEW FIRE HYDRANTS SHALL BE EJM 5BR-250 WITH 4" STORZ QUICK CONNECT. VALVE SHALL BE EJM FLOWMASTER RESILIENT SEATED GATE VALVES.
- FIRE HYDRANT ASSEMBLIES SHALL INCLUDE ALL NECESSARY THRUST BLOCKS, BENDS, PIPE AND FITTINGS, INCLUDING ADJUSTMENT OF THE STOP BOX. FIRE HYDRANT ASSEMBLY INCLUDES 6" STOP BOX LOCATED 3' FROM HYDRANT.
- LINE STOPS SHALL BE INSTALLED WHERE EXISTING WATER MAINS CANNOT BE SUFFICIENTLY ISOLATED TO COMPLETE THE WORK.
- CONNECTIONS TO THE EXISTING WATER MAIN SHALL NOT BE MADE UNTIL THE NEW WATER MAIN HAS BEEN SUCCESSFULLY PRESSURE TESTED AND HAS PASSED BACTERIOLOGICAL TESTING. FINAL CONNECTIONS SHALL BE COORDINATED WITH THE ENGINEER. THE CONTRACTOR SHALL PERFORM ALL WATER SYSTEM SHUT DOWNS AFTER APPROPRIATE NOTIFICATION TO THOSE AFFECTED.
- ALL HYDRANTS REMOVED BY THE CONTRACTOR SHALL BE DELIVERED TO THE CITY OF ANN ARBOR FIELD OPERATIONS FACILITY LOCATED AT 4251 STONE SCHOOL ROAD, ANN ARBOR, MI 48108 BY THE CONTRACTOR AND WILL BECOME THE PROPERTY OF THE CITY OF ANN ARBOR.
- ALL WATER MAIN TRENCH BACKFILL SHALL BE MDOT CLASS II MATERIAL.
- ABANDONMENT OF WATER STRUCTURES SHALL FOLLOW CITY OF ANN ARBOR STANDARDS.
- FITTINGS OTHER THAN THOSE SPECIFICALLY LISTED AS SEPARATE PAY ITEMS, BLOW-OFF ASSEMBLIES, CONCRETE THRUST BLOCKS, SOLID SLEEVES AND MECHANICAL PLUGS, WHICH ARE REQUIRED TO COMPLETE THE WORK, SHALL BE INCLUDED IN THE PRICE OF THE WATER MAIN.

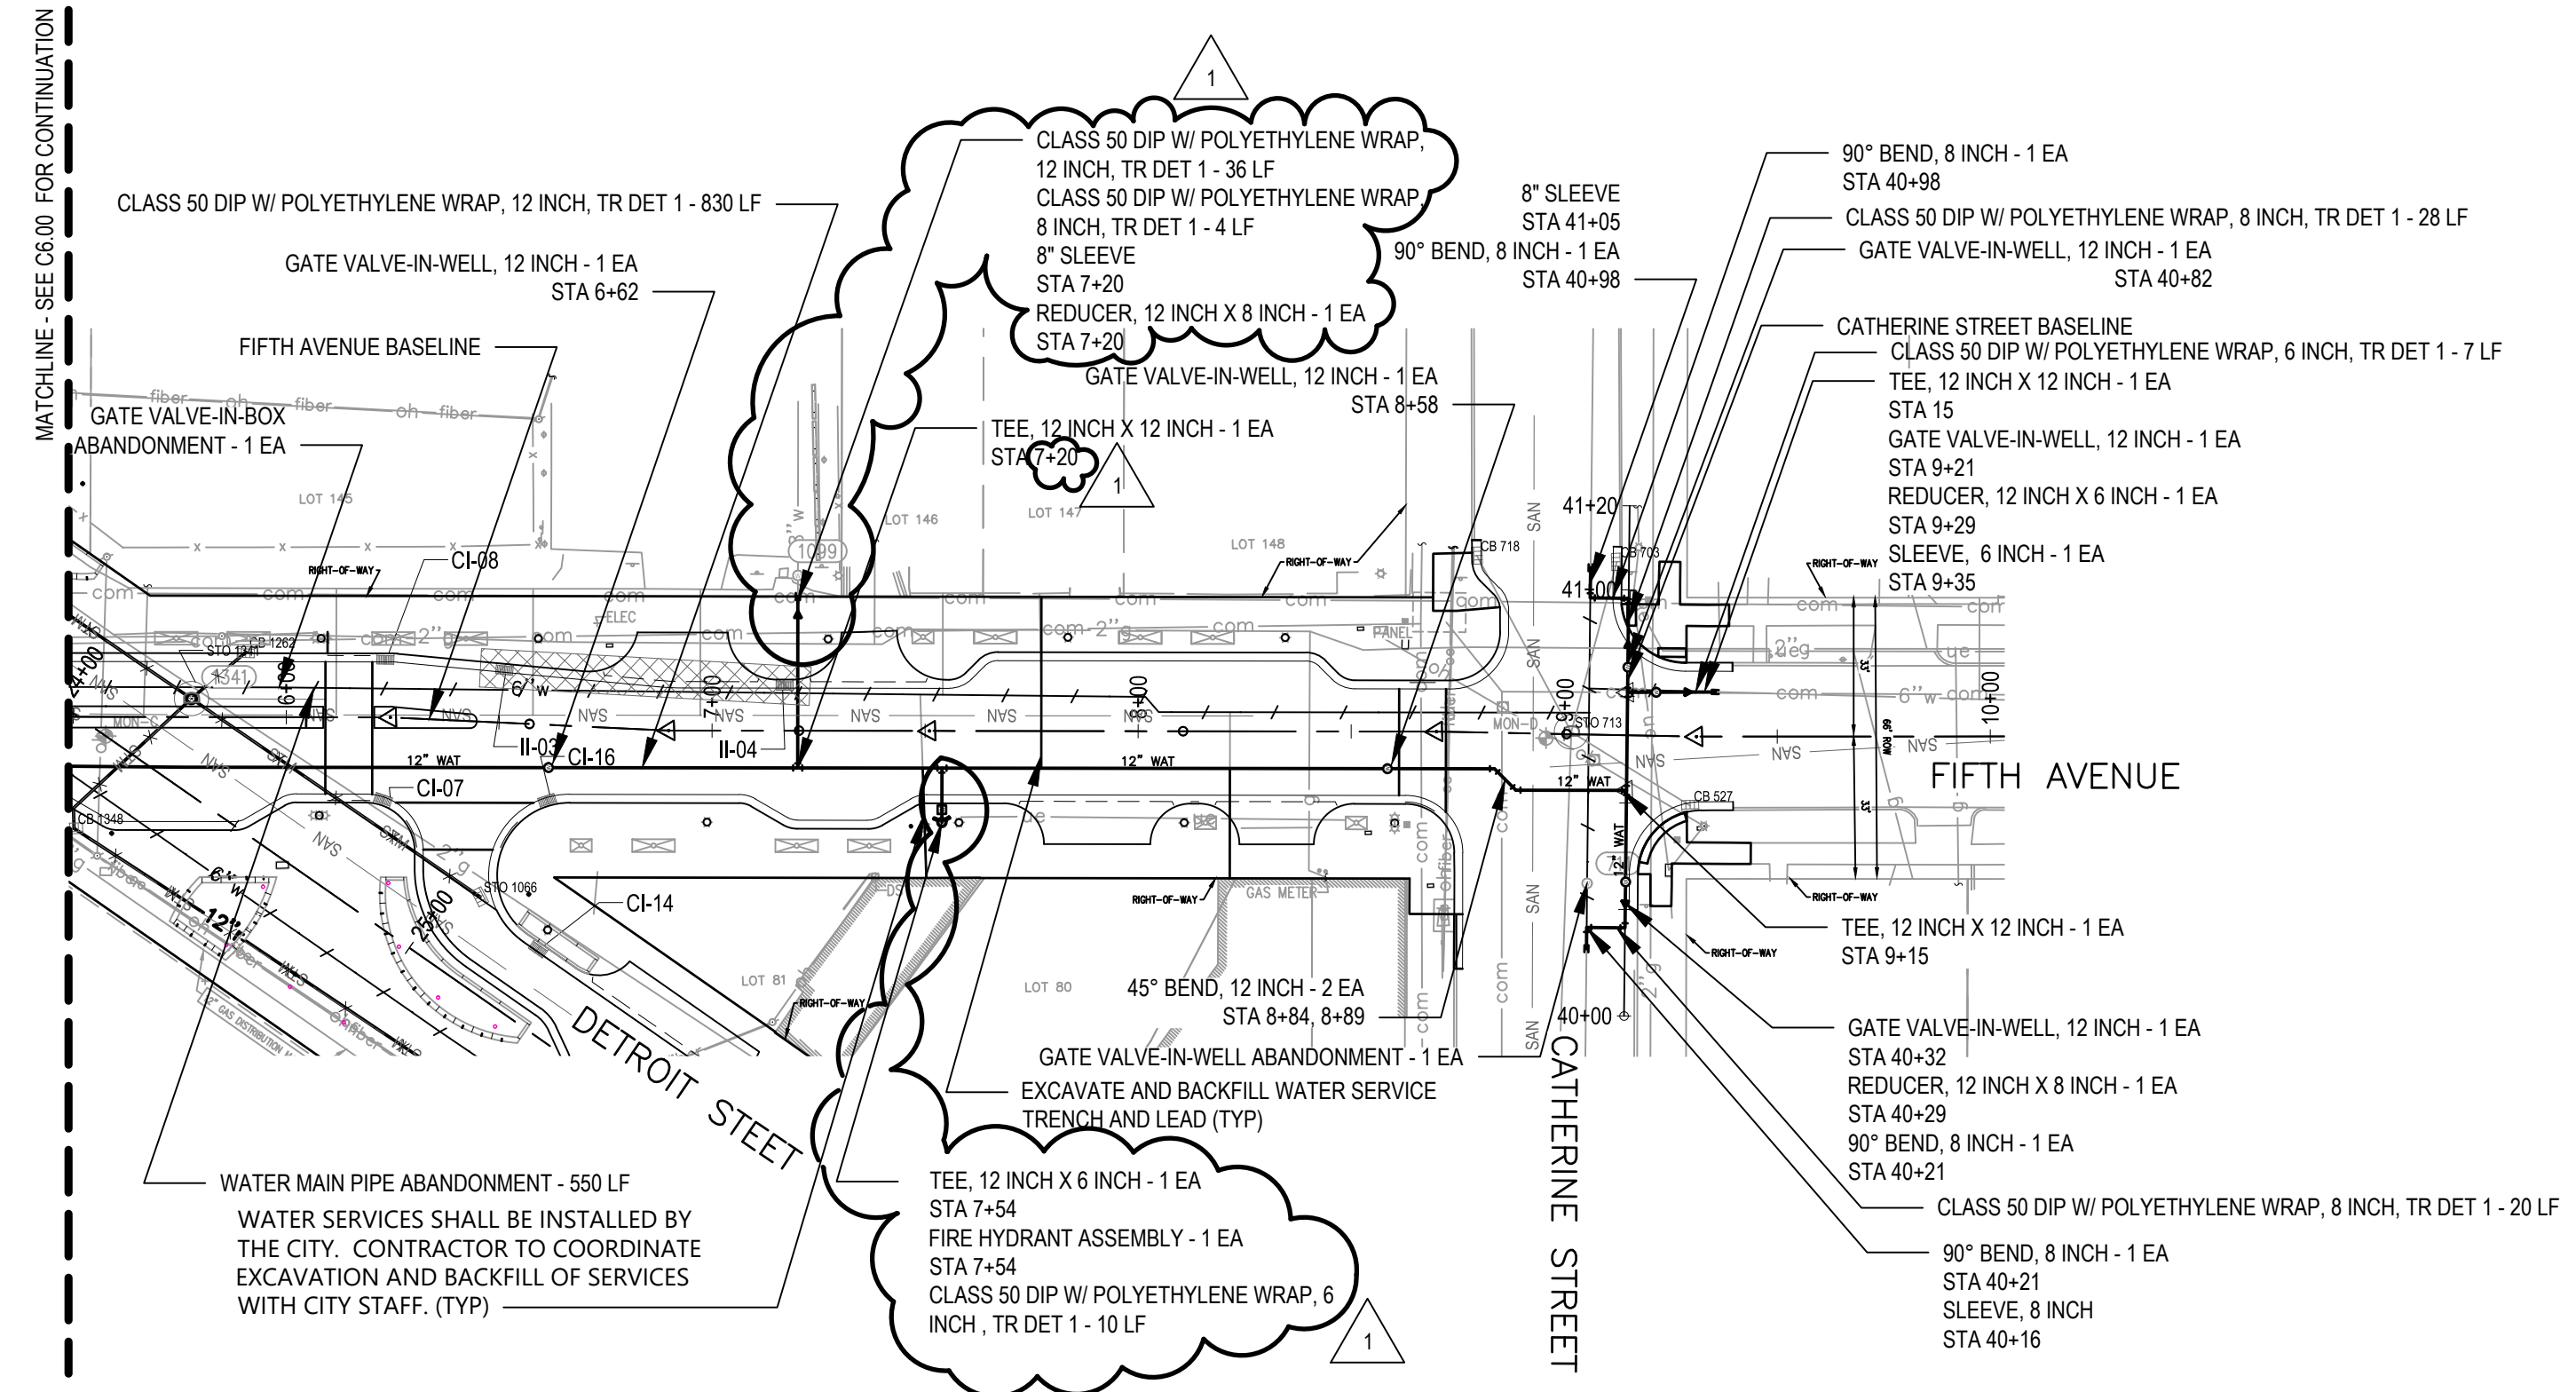

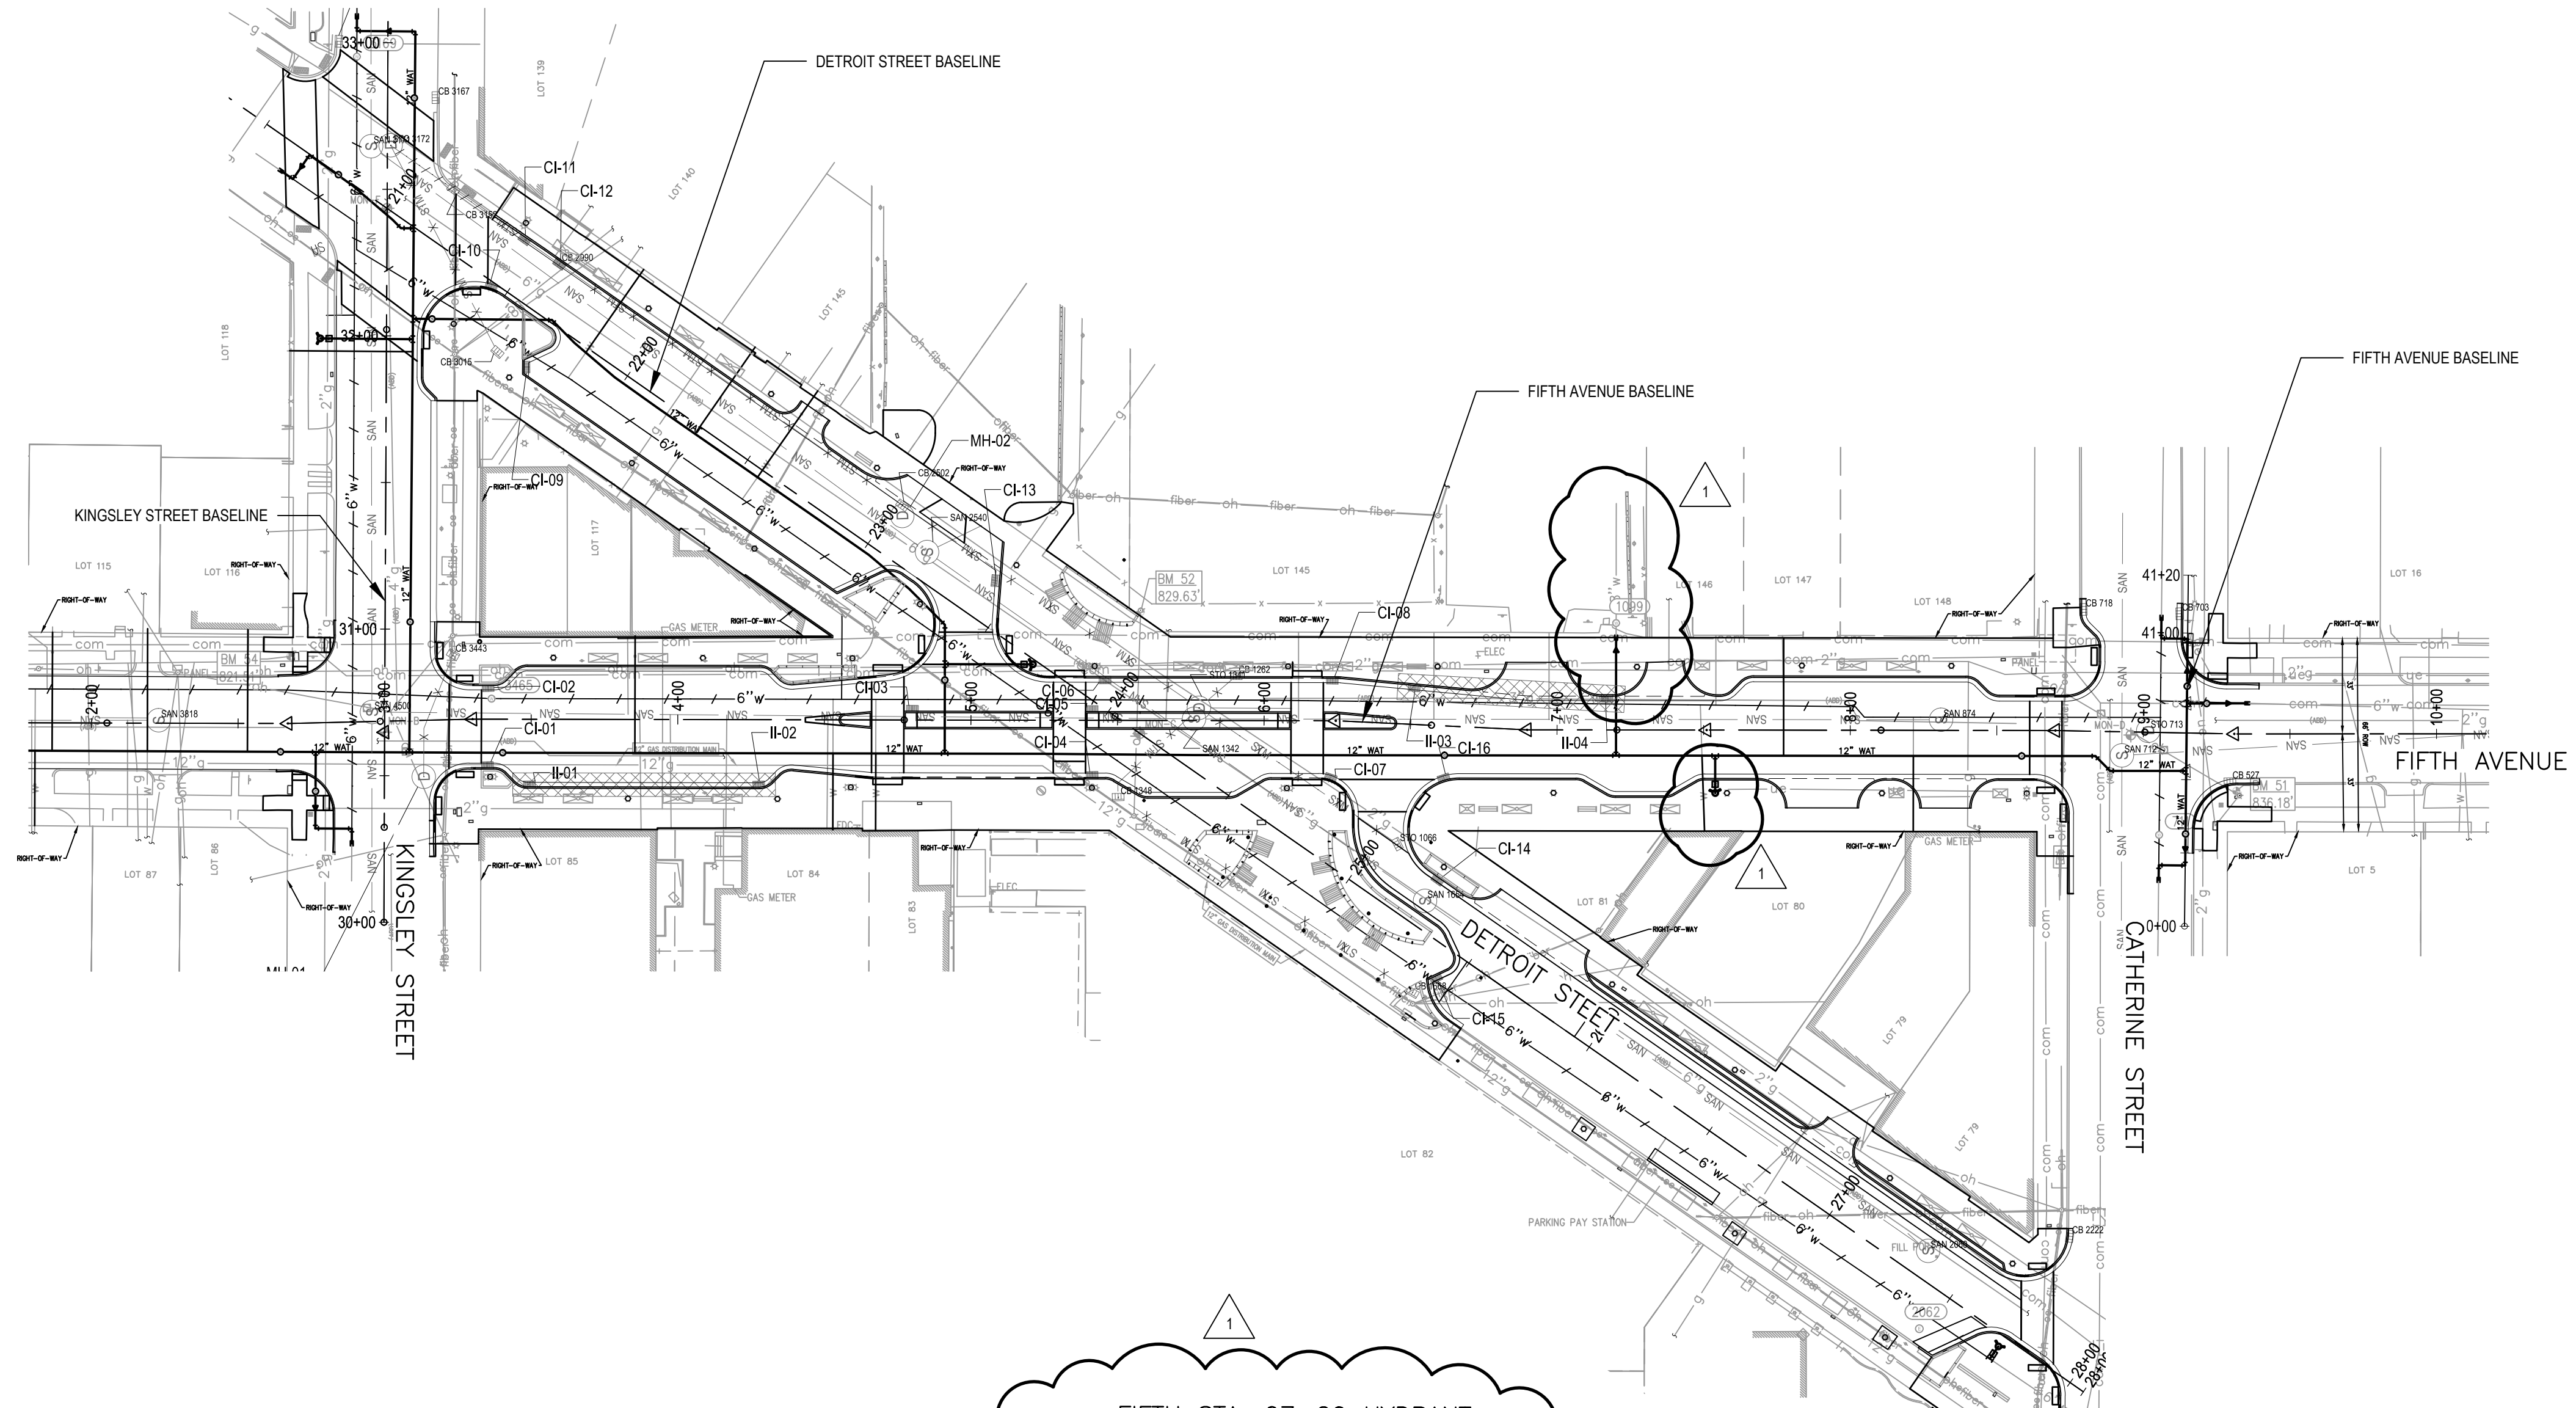


- NOTES**
- STATION REFERENCES FOR WATER MAIN FITTINGS AND APPURTENANCES ARE IN REFERENCE TO BASELINES.
 - ALL MATERIALS, EQUIPMENT AND CONSTRUCTION SHALL BE IN ACCORDANCE WITH THE CURRENT CITY OF ANN ARBOR STANDARD SPECIFICATIONS AND DETAILS. THE OMISSION OF ANY CURRENT STANDARD DETAIL DOES NOT RELIEVE THE CONTRACTOR FROM THIS REQUIREMENT.
 - DUCTILE IRON PIPE SHALL BE THICKNESS CLASS 50 WITH POLYETHYLENE WRAP AND PUSH-ON JOINTS, UNLESS OTHERWISE NOTED.
 - GATE VALVES SHALL BE RESILIANT-SEATED MECHANICAL JOINT GATE VALVE, WITH 2" SQUARE OPERATING NUT. OPENING RIGHT, COMPLETE WITH ACCESSORIES. GATE VALVE SHALL MEET AWWA SPECIFICATION C509. PLEASE QUOTE ONLY: AMERICAN FLOW CONTROL SERIES 2500 SINGLE RESILIANT WEDGE, CLOW MODEL 2638 (4" THROUGH 16") F-6112, EIW FLOWMASTER RESILIANT WEDGE VALVE, TYTON X TYTON, MUELLER SERIES 4"-12" A-2361-61 RESILIANT WEDGE SL X SL, U.S. PIPE A-USP1-61 RESILIANT WEDGE VALVE SLXSL FOR FIELD LOK GASKETS.
 - MECHANICAL JOINTS MUST MEET AWWA SPECIFICATION C111 AND SHALL INCLUDE PLAIN RUBBER MECHANICAL JOINT GASKETS. PLEASE QUOTE ONLY: AMERICAN PIPE "FAST GRIP" GASKET SYSTEM, GRIFFIN PIPE "FIELD LOK 350" GASKET SYSTEM, OR U.S. PIPE "FIELD LOK 350" GASKET SYSTEM.
 - ALL HORIZONTAL BENDS, TEES AND FITTINGS SHALL INCLUDE THRUST BLOCKS. RESTRAINED JOINTS ARE REQUIRED FOR VERTICAL BENDS. (TR-FLEX RESTRAINED JOINT PIPE BY U.S. PIPE, LOK-RING JOINT PIPE BY AMERICAN DUCTILE IRON PIPE, OR APPROVED EQUAL). RESTRAINED JOINT GASKET SYSTEMS MAY ALSO BE USED (FIELD-LOK 350 BY U.S. PIPE, FAST-GRIP BY AMERICAN DUCTILE IRON PIPE, OR APPROVED EQUAL).
 - CONTRACTOR TO FOLLOW CITY REQUIREMENTS FOR WATER MAIN TESTING. WATER MAIN PRESSURE/BACTERIA TESTING MATERIAL AND FEES WILL BE PAID BY THE CONTRACTOR.
 - ALL WATER MAIN TO HAVE A TYPICAL 5.5' COVER. MAINTAIN A MINIMUM OF 18" VERTICAL CLEARANCE FOR STORM AND SANITARY CROSSINGS AND A MINIMUM OF 12" VERTICAL CLEARANCE WITH ALL OTHER UTILITIES.
 - UNLESS OTHERWISE NOTED, THE CONTRACTOR SHALL UTILIZE STANDARD PIPE DEFLECTIONS FOR FOLLOWING THE PROPOSED ALIGNMENT.
 - NEW FIRE HYDRANTS SHALL BE EIW 5BR-250 WITH 4" STORZ QUICK CONNECT. VALVE SHALL BE EIW FLOWMASTER RESILIANT SEATED GATE VALVES.
 - FIRE HYDRANT ASSEMBLIES SHALL INCLUDE ALL NECESSARY THRUST BLOCKS, BENDS, PIPE AND FITTINGS, INCLUDING ADJUSTMENT OF THE STOP BOX. FIRE HYDRANT ASSEMBLY INCLUDES 6" STOP BOX LOCATED 3' FROM HYDRANT.
 - LINE STOPS SHALL BE INSTALLED WHERE EXISTING WATER MAINS CANNOT BE SUFFICIENTLY ISOLATED TO COMPLETE THE WORK.
 - CONNECTIONS TO THE EXISTING WATER MAIN SHALL NOT BE MADE UNTIL THE NEW WATER MAIN HAS BEEN SUCCESSFULLY PRESSURE TESTED AND HAS PASSED BACTERIOLOGICAL TESTING. FINAL CONNECTIONS SHALL BE COORDINATED WITH THE ENGINEER. THE CONTRACTOR SHALL PERFORM ALL WATER SYSTEM SHUT DOWNS AFTER APPROPRIATE NOTIFICATION TO THOSE AFFECTED.
 - ALL HYDRANTS REMOVED BY THE CONTRACTOR SHALL BE DELIVERED TO THE CITY OF ANN ARBOR FIELD OPERATIONS FACILITY LOCATED AT 4251 STONE SCHOOL ROAD, ANN ARBOR, MI 48108 BY THE CONTRACTOR AND WILL BECOME THE PROPERTY OF THE CITY OF ANN ARBOR.
 - ALL WATER MAIN TRENCH BACKFILL SHALL BE MDOT CLASS II MATERIAL.
 - ABANDONMENT OF WATER STRUCTURES SHALL FOLLOW CITY OF ANN ARBOR STANDARDS.
 - FITTINGS OTHER THAN THOSE SPECIFICALLY LISTED AS SEPARATE PAY ITEMS, BLOW-OFF ASSEMBLIES, CONCRETE THRUST BLOCKS, SOLID SLEEVES AND MECHANICAL PLUGS, WHICH ARE REQUIRED TO COMPLETE THE WORK, SHALL BE INCLUDED IN THE PRICE OF THE WATER MAIN.


KINGSLEY STA. 31+99 HYDRANT

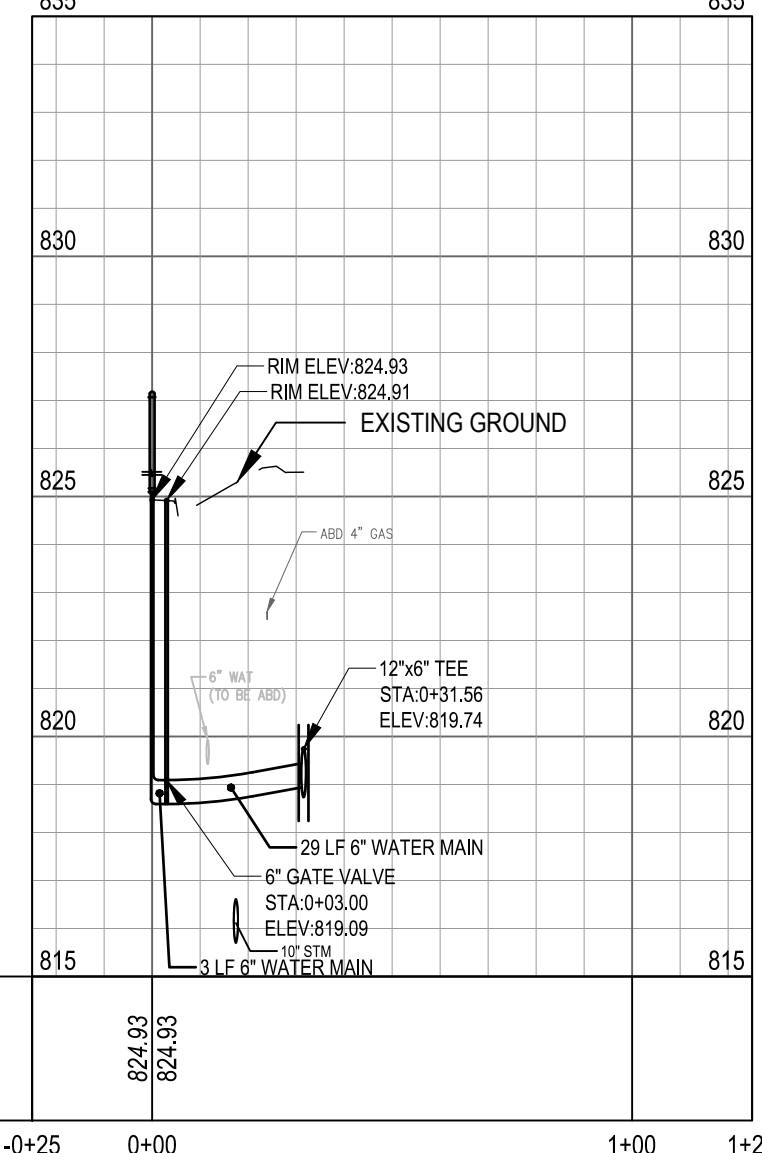


DETROIT STA. 23+45 HYDRANT

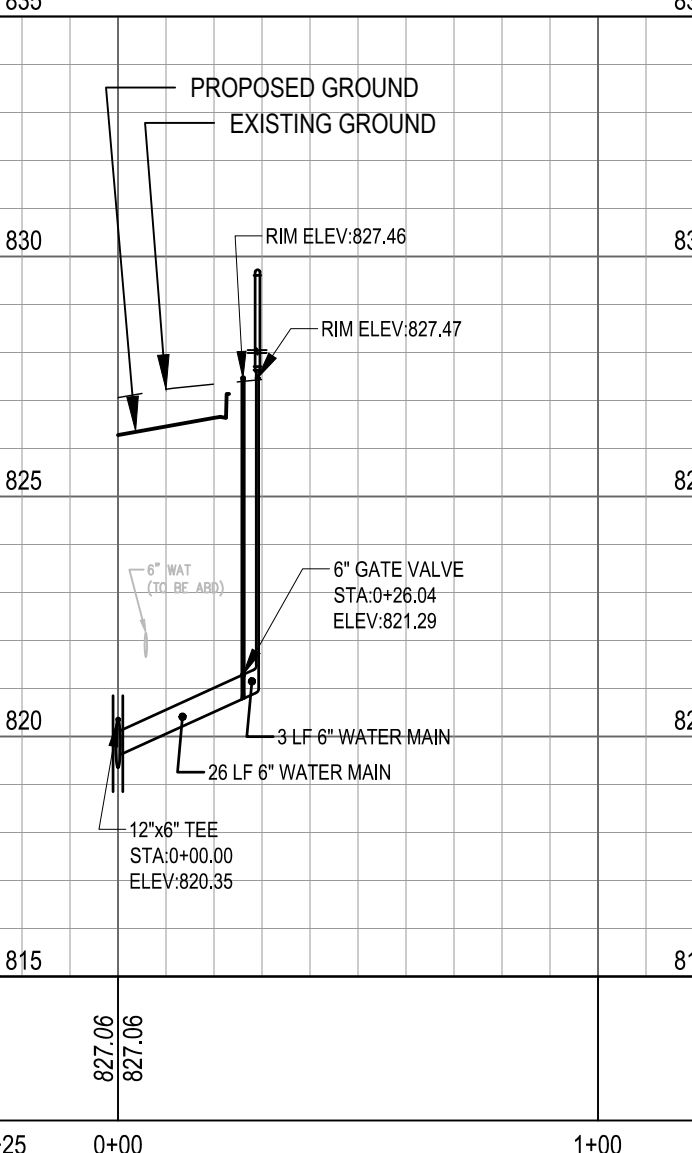


FIFTH STA. 07+20 HYDRANT LEAD REPLACEMENT

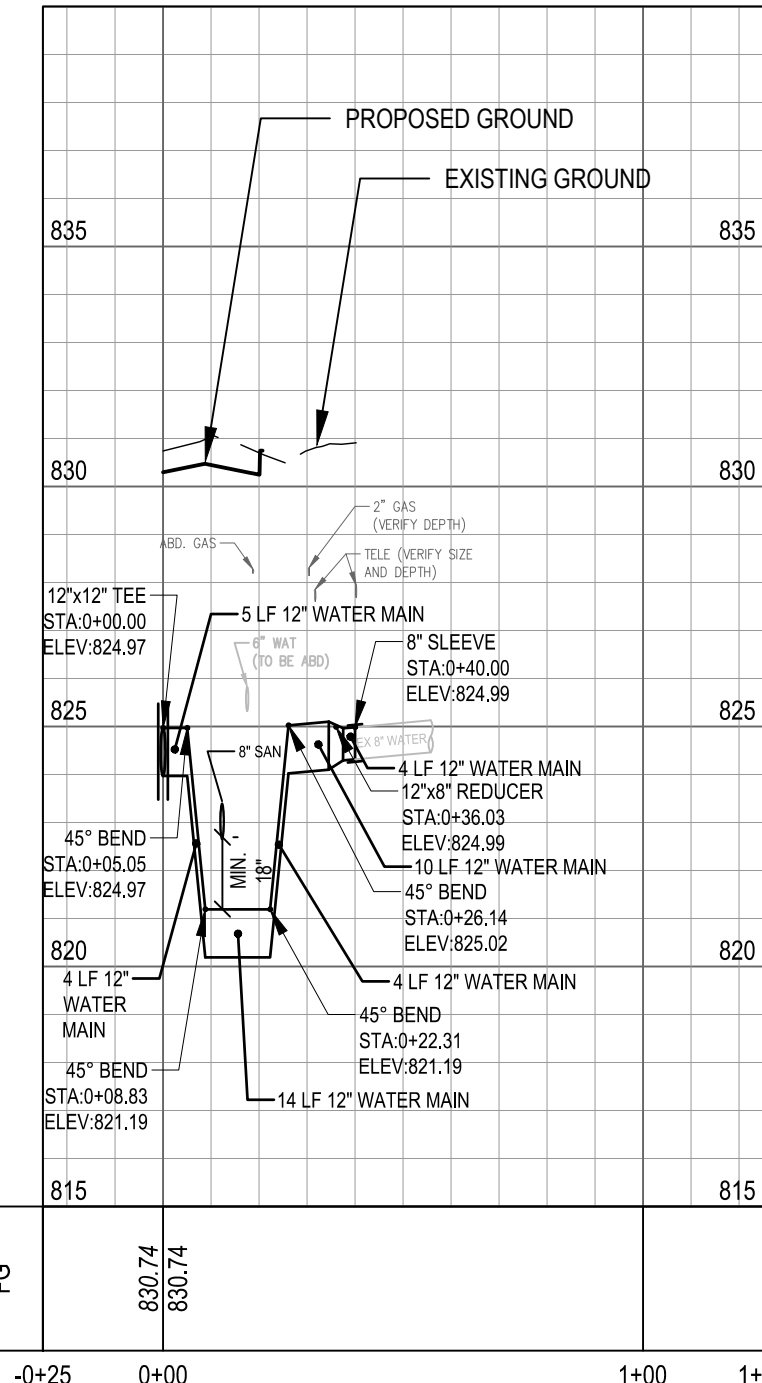

FIFTH STA. 7+54 HYDRANT

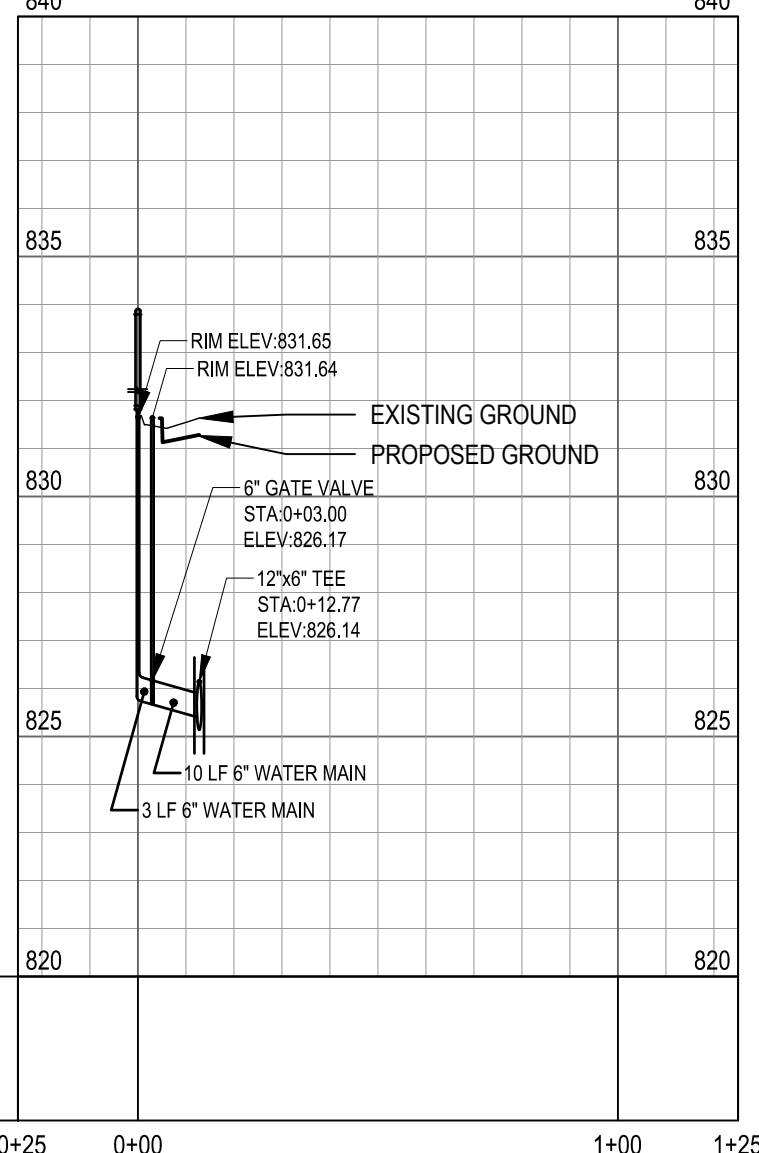

DETROIT STA. 27+73 HYDRANT

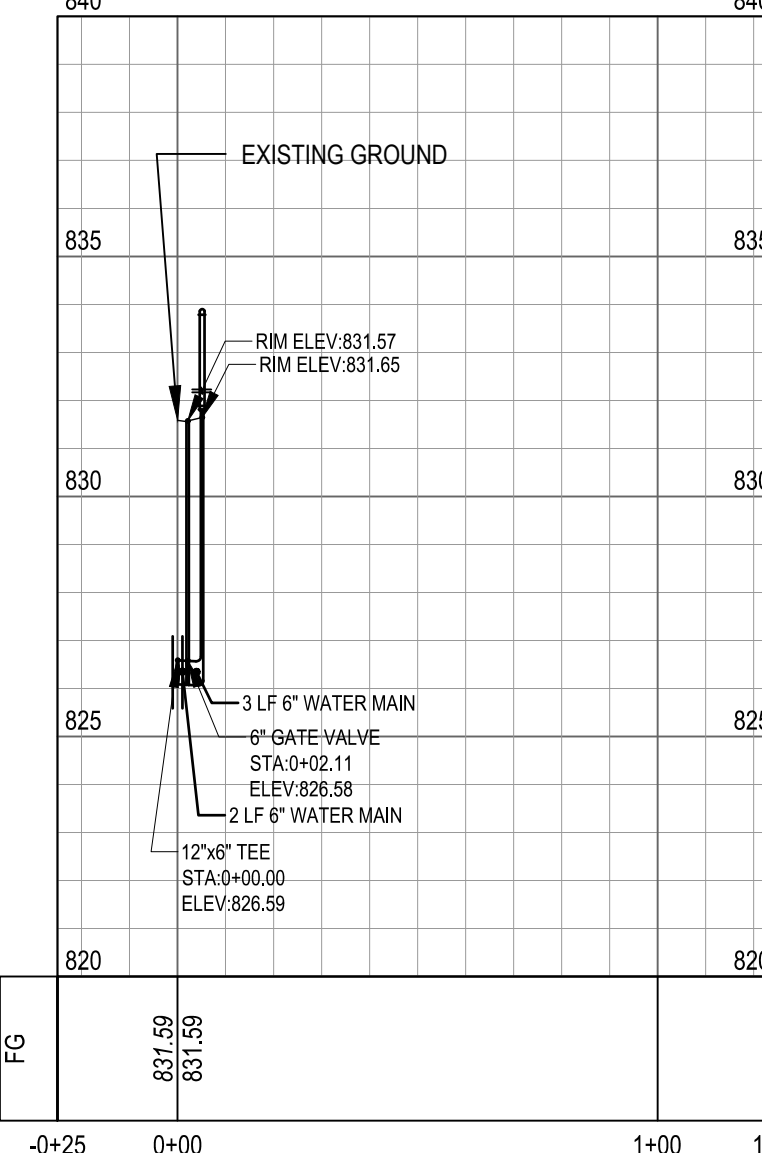

LEGEND

	EXISTING CURB INLET		EXISTING SANITARY MANHOLE		CLEANOUT
	EXISTING STORM MANHOLE		EXISTING GATE VALVE-IN-BOX		GATE VALVE-IN-WELL
	EXISTING HYDRANT		STORM PIPE		REMOVE SEWER
	EXISTING STORM		CURB INLET		ABANDON WATER LINE
	EXISTING WATER		STORM MANHOLE		WATER LINE
	EXISTING SANITARY		HYDRANT		LIMITS OF WORK
	EXISTING GAS				


SEE ABOVE	REV. NO.	DESCRIPTION	DATE	DR. BY	CH. BY
		ADDENDUM NO 1	01-04-2018		
		BID PLANS	12-01-2017		
		95% CD	11-17-2017		

DOWNTOWN DEVELOPMENT AUTHORITY - CITY OF ANN ARBOR

WATER MAIN PROFILES


SCALE	1" = 40'	INCH	0" 20" 40"
DRAWING NO.	C7.00		
SHEET NO.	OF		

APPROVED BY _____

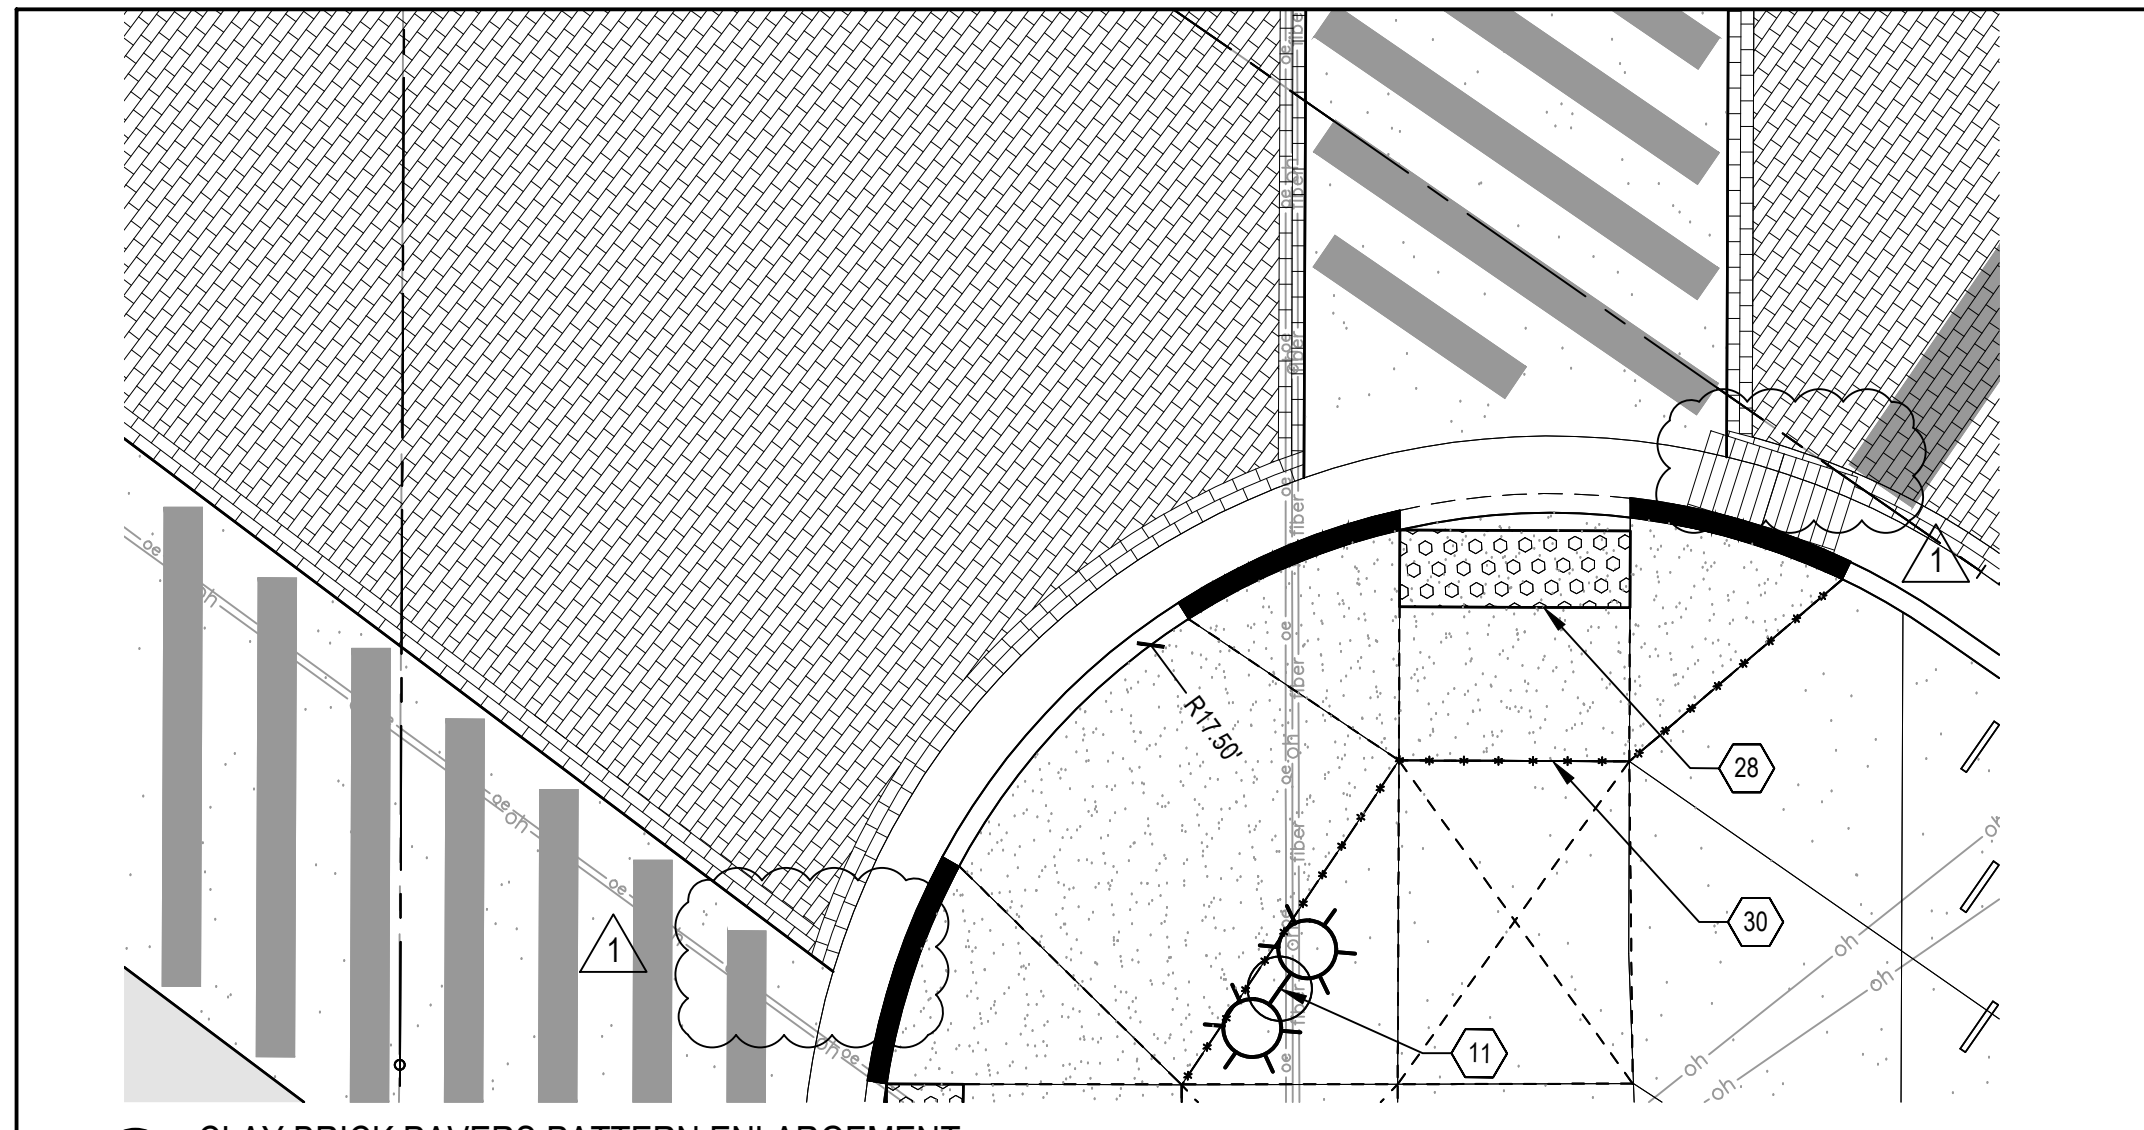

1 CLAY BRICK PAVERS PATTERN ENLARGEMENT

SCALE: 1" = 5'

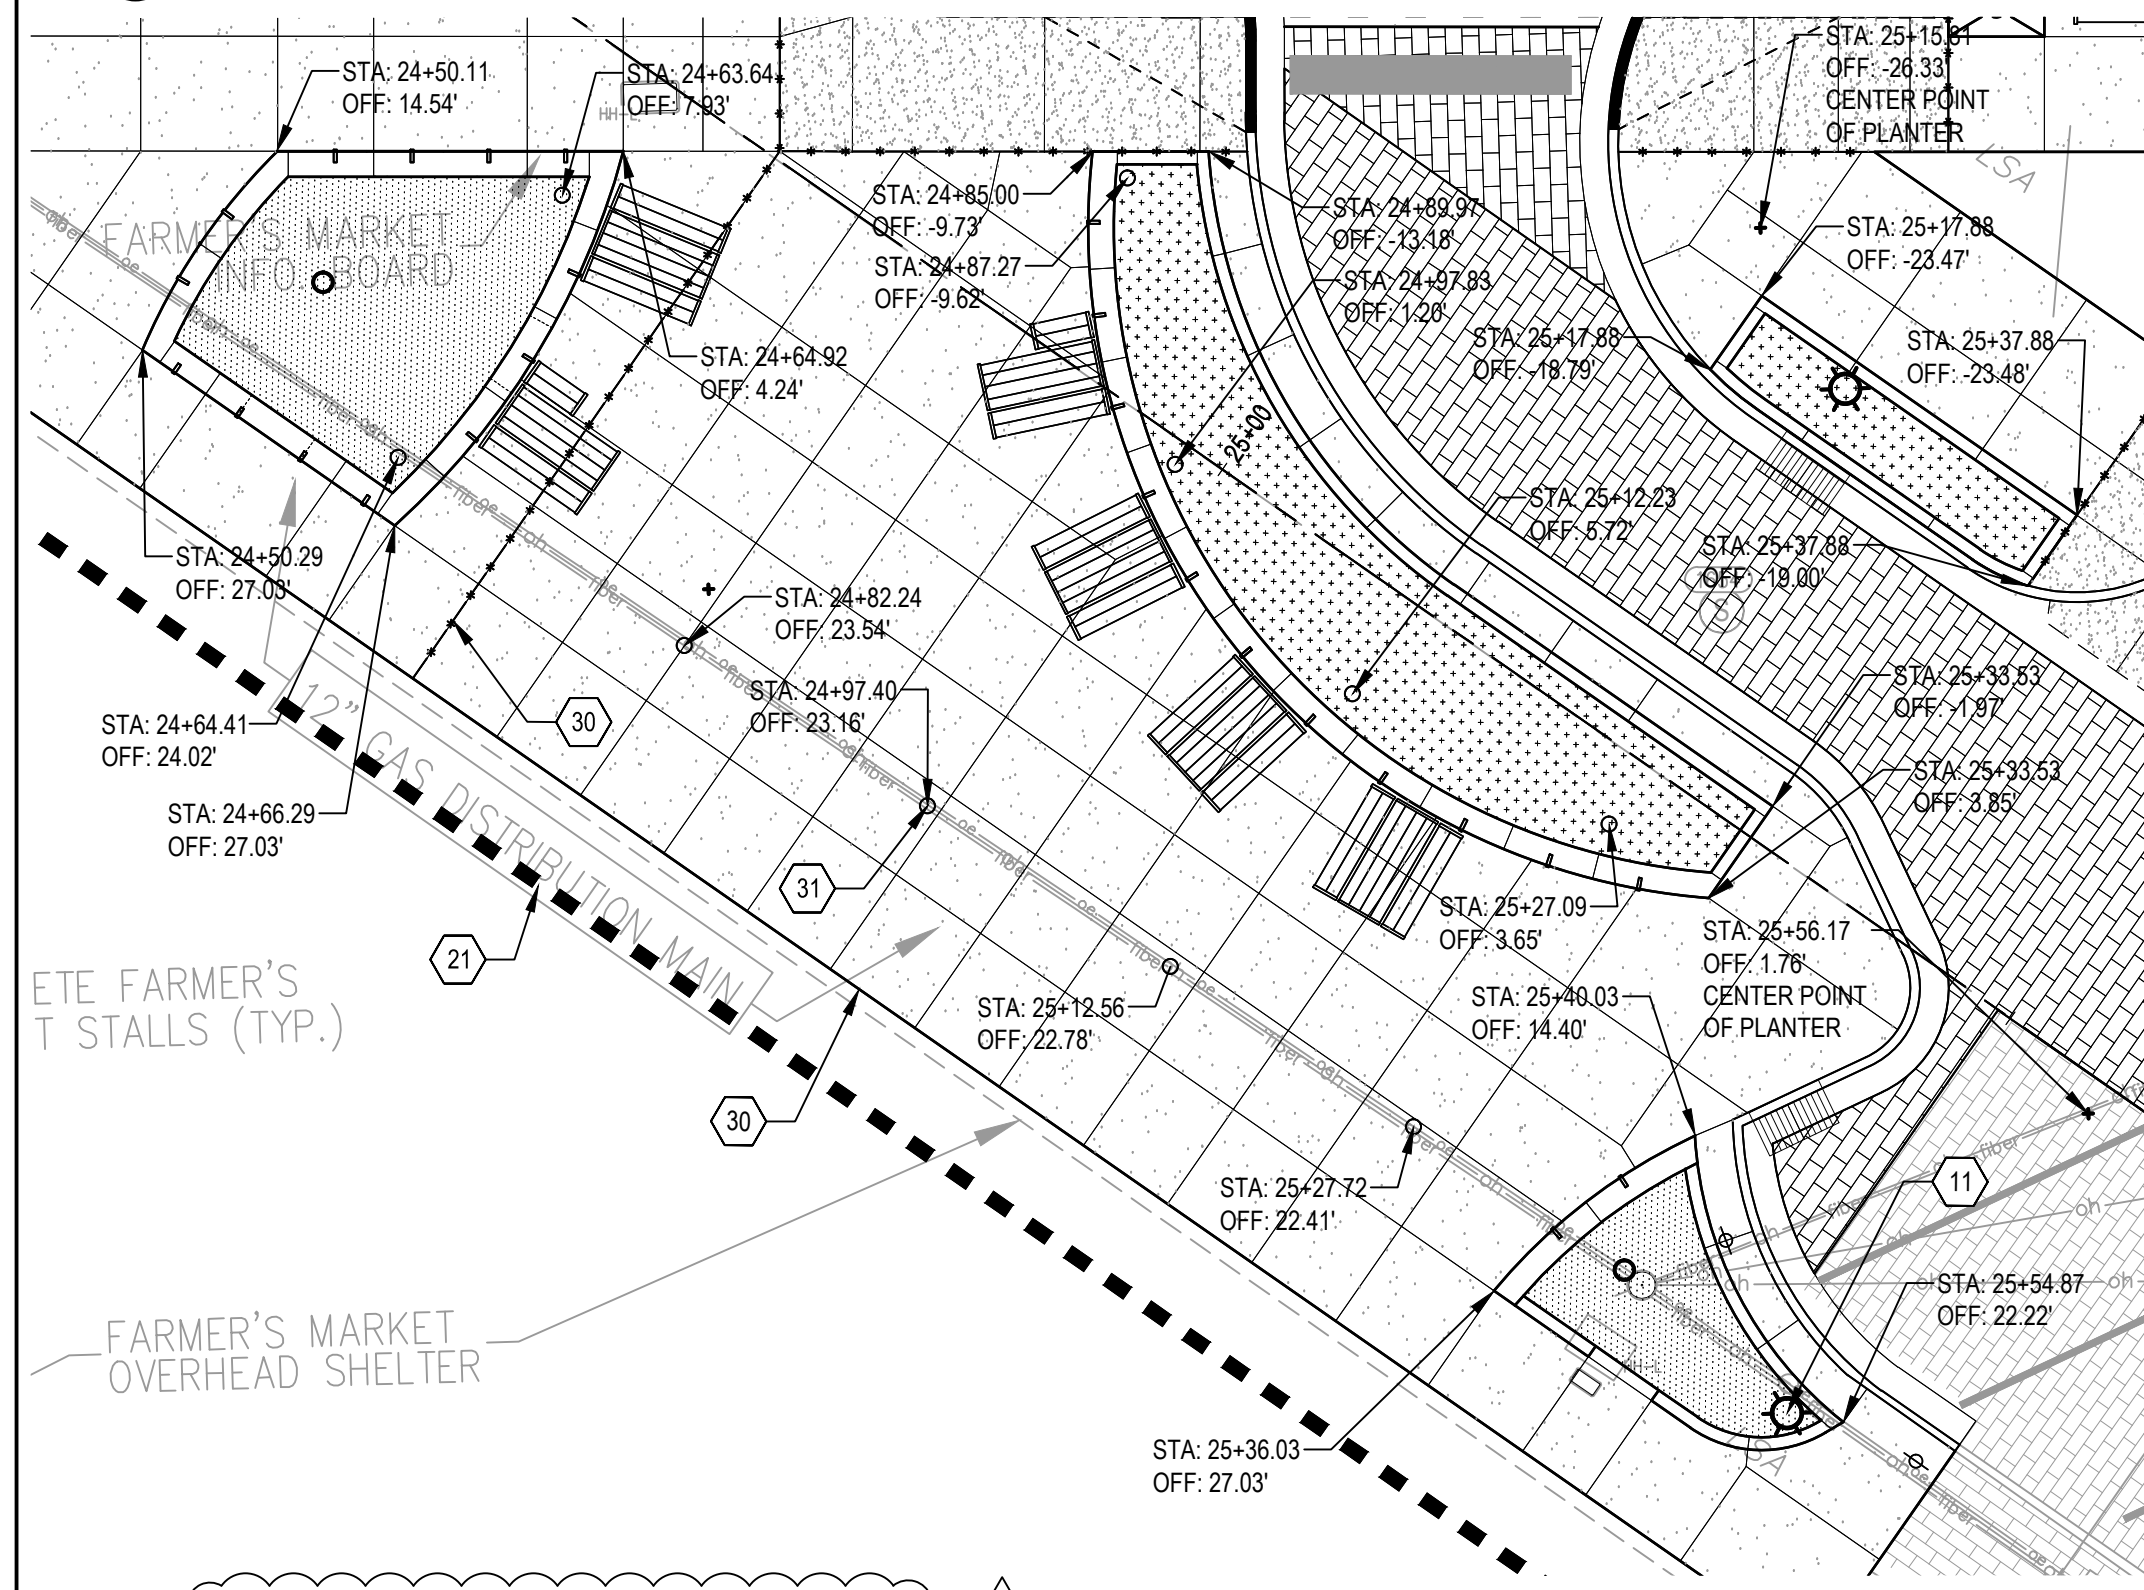

2 FARMER'S MARKET PLAZA ENLARGEMENT


SCALE: 1" = 5'

DESCRIPTIVE KEYED NOTES:

- A CLAY BRICK PAVERS SET IN RUNNING BOND PATTERN PERPENDICULAR TO THE LENGTH OF DETROIT STREET
- B USE SALVAGE STONE CURB (PREFERRED) OR 6-INCH STRAIGHT CONCRETE CURB (AS NEEDED).
- C PROJECT ALSO INCLUDED ASPHALT STREET RESURFACING AS NOTED ON PLANS.
- D REMOVE AND REPLACE CONCRETE CURB ON THIS SIDE OF THIS BLOCK. SALVAGE EXISTING SECTIONS OF STONE CURB AND REINSTALL ON THE WEST SIDE OF THIS BLOCK.
- E CLAY BRICK PAVERS SET IN RUNNING BOND PATTERN PERPENDICULAR TO THE LENGTH OF FIFTH AVENUE.
- F ALIGN EDGE OF PAVEMENT WITH NEAREST EXISTING CONCRETE JOINT. COORDINATE WITH DEMOLITION PLANS FOR SAWCUT LOCATION.
- G CONFIRM LOCATION WITH ENGINEER PRIOR INSTALLATION.
- H REPLACE DAMAGED PAVERS IN THIS AREA AS DIRECTED BY THE PROJECT ENGINEER.
- I PROJECT ALSO INCLUDED ASPHALT STREET RESURFACING OF FIFTH AVENUE FROM CATHERINE STREET TO ANN STREET.
- J EXISTING CURB TO REMAIN.
- K EXISTING BRICKS TO REMAIN.
- L EXISTING CURB ON THIS BLOCK IS POURED CONCRETE AND IN GOOD CONDITION. DAMAGED AREAS WILL BE REPLACED WITH MATCHING CURB AS DIRECTED BY PROJECT ENGINEER.
- M CONCRETE UNIT RETAINING WALL, REM, SALVAGE, AND RE-INSTALL.
- N AT EACH CURB OF WALL OPENING INTO A RAIN GARDEN, INSTALL A SMALL BED OF RIP-RAP 18" WIDE, 12" DEEP, AND THE WIDTH OF THE OPENING PLUS 6" AT EACH END.
- O PROVIDE 24" LONG BY 5" DEEP SPILLWAY NOTCH IN PLATING EDGE, TOP OF SPILLWAY TO BE FLUSH WITH SIDEWALK AND TOP OF CURB.

LEGEND

1	CLAY BRICK PAVERS, TYP.	6	CONCRETE CURB AND GUTTER, TYP.	11	STREET LIGHT, TYP.	17	BIKE HOOP, SURFACE MOUNT, TYP.	23	BIKE SHARE PARKING BY THE CITY OF ANN ARBOR, TYP.	29	RIGHT OF WAY, TYP.
2	HEAVY DUTY HMA PAVEMENT, TYP.	7	CONCRETE CURB & GUTTER - THICKENED PAN, TYP.	12	LANDSCAPE PLANTER, TYP.	18	PARKING STRIPPING, TYP.	24	URBAN TABLE AND BENCHES, TYP.	30	EXPANSION JOINT, TYP.
3	6-INCH CONCRETE, TYP.	8	CONCRETE CURB, 6-INCH STRAIGHT, TYP.	13	TREE GRATE, 3FT X 10FT, TYP.	19	RELOCATED HISTORIC MARKER, TYP.	25	URBAN BENCH, TYP.	31	FESTOON LIGHTING POLE, TYP.
4	CONCRETE CROSSWALK, 12-INCH, TYP.	9	RESET STONE CURB, TYP.	14	TREE GRATE, 3FT X 5FT, TYP.	20	RAIN GARDEN, TYP.	26	8-INCH DRIVE APPROACH TYPE L, TYP.	32	INTEGRAL CURB
5	8-INCH CONCRETE, TYP.	10	CONCRETE CURB AND GUTTER - MOUNTABLE, TYP.	15	PEDESTRIAN CROSSWALK, TYP.	21	LIMIT OF WORK, TYP.	27	8-INCH DRIVE APPROACH TYPE M, TYP.		
				16	5' BICYCLE LANE, TYP.	22	PARKING METER, TYP.	28	DETECTABLE WARNING SURFACE, TYP.		

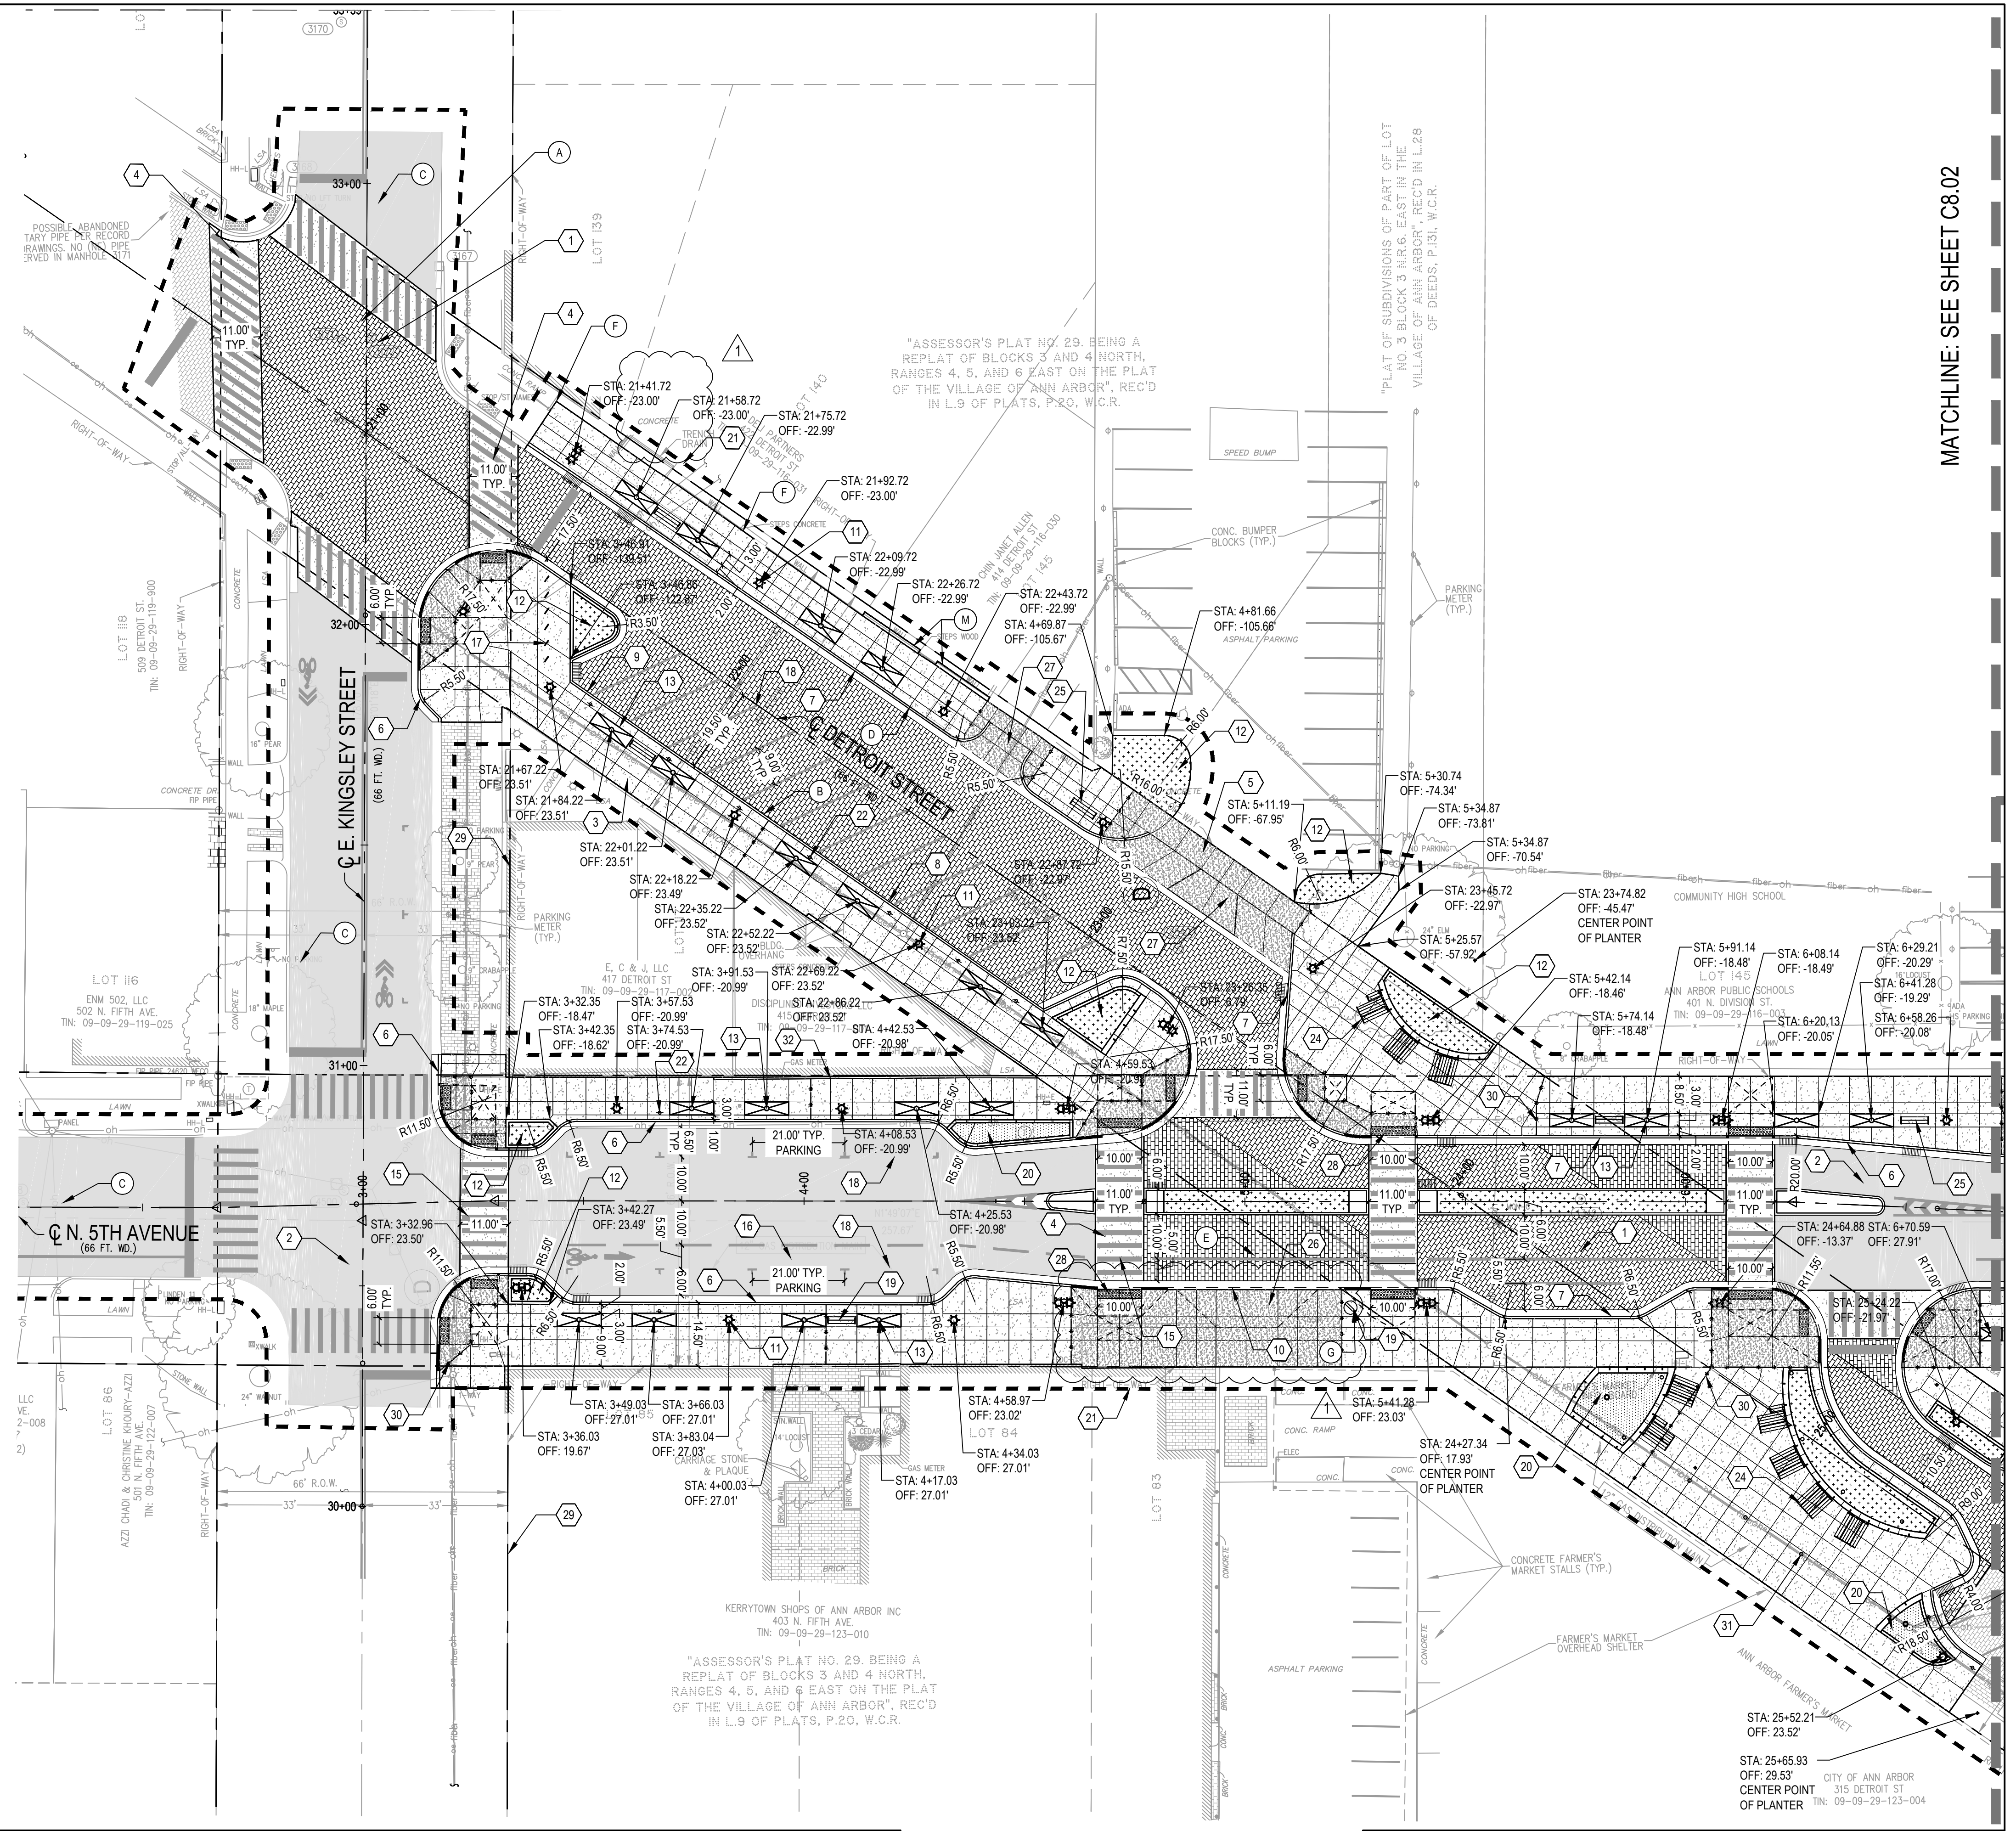

MATCHLINE: SEE SHEET C8.02

DOWNTOWN DEVELOPMENT AUTHORITY - CITY OF ANN ARBOR


STREETSCAPE LAYOUT & MATERIALS
PLAN - NORTH

SCALE	INCH
1" = 20'	
DRAWING NO.	C8.01
SHEET NO.	___ OF ___

REV. NO.	DESCRIPTION	DATE	DR. BY	CH. BY
ADDENDUM NO 1		01-04-2018		
BID PLANS		12-01-2017		
95% CD		11-17-2017		

APPROVED BY: _____

FOR INFORMATION ONLY

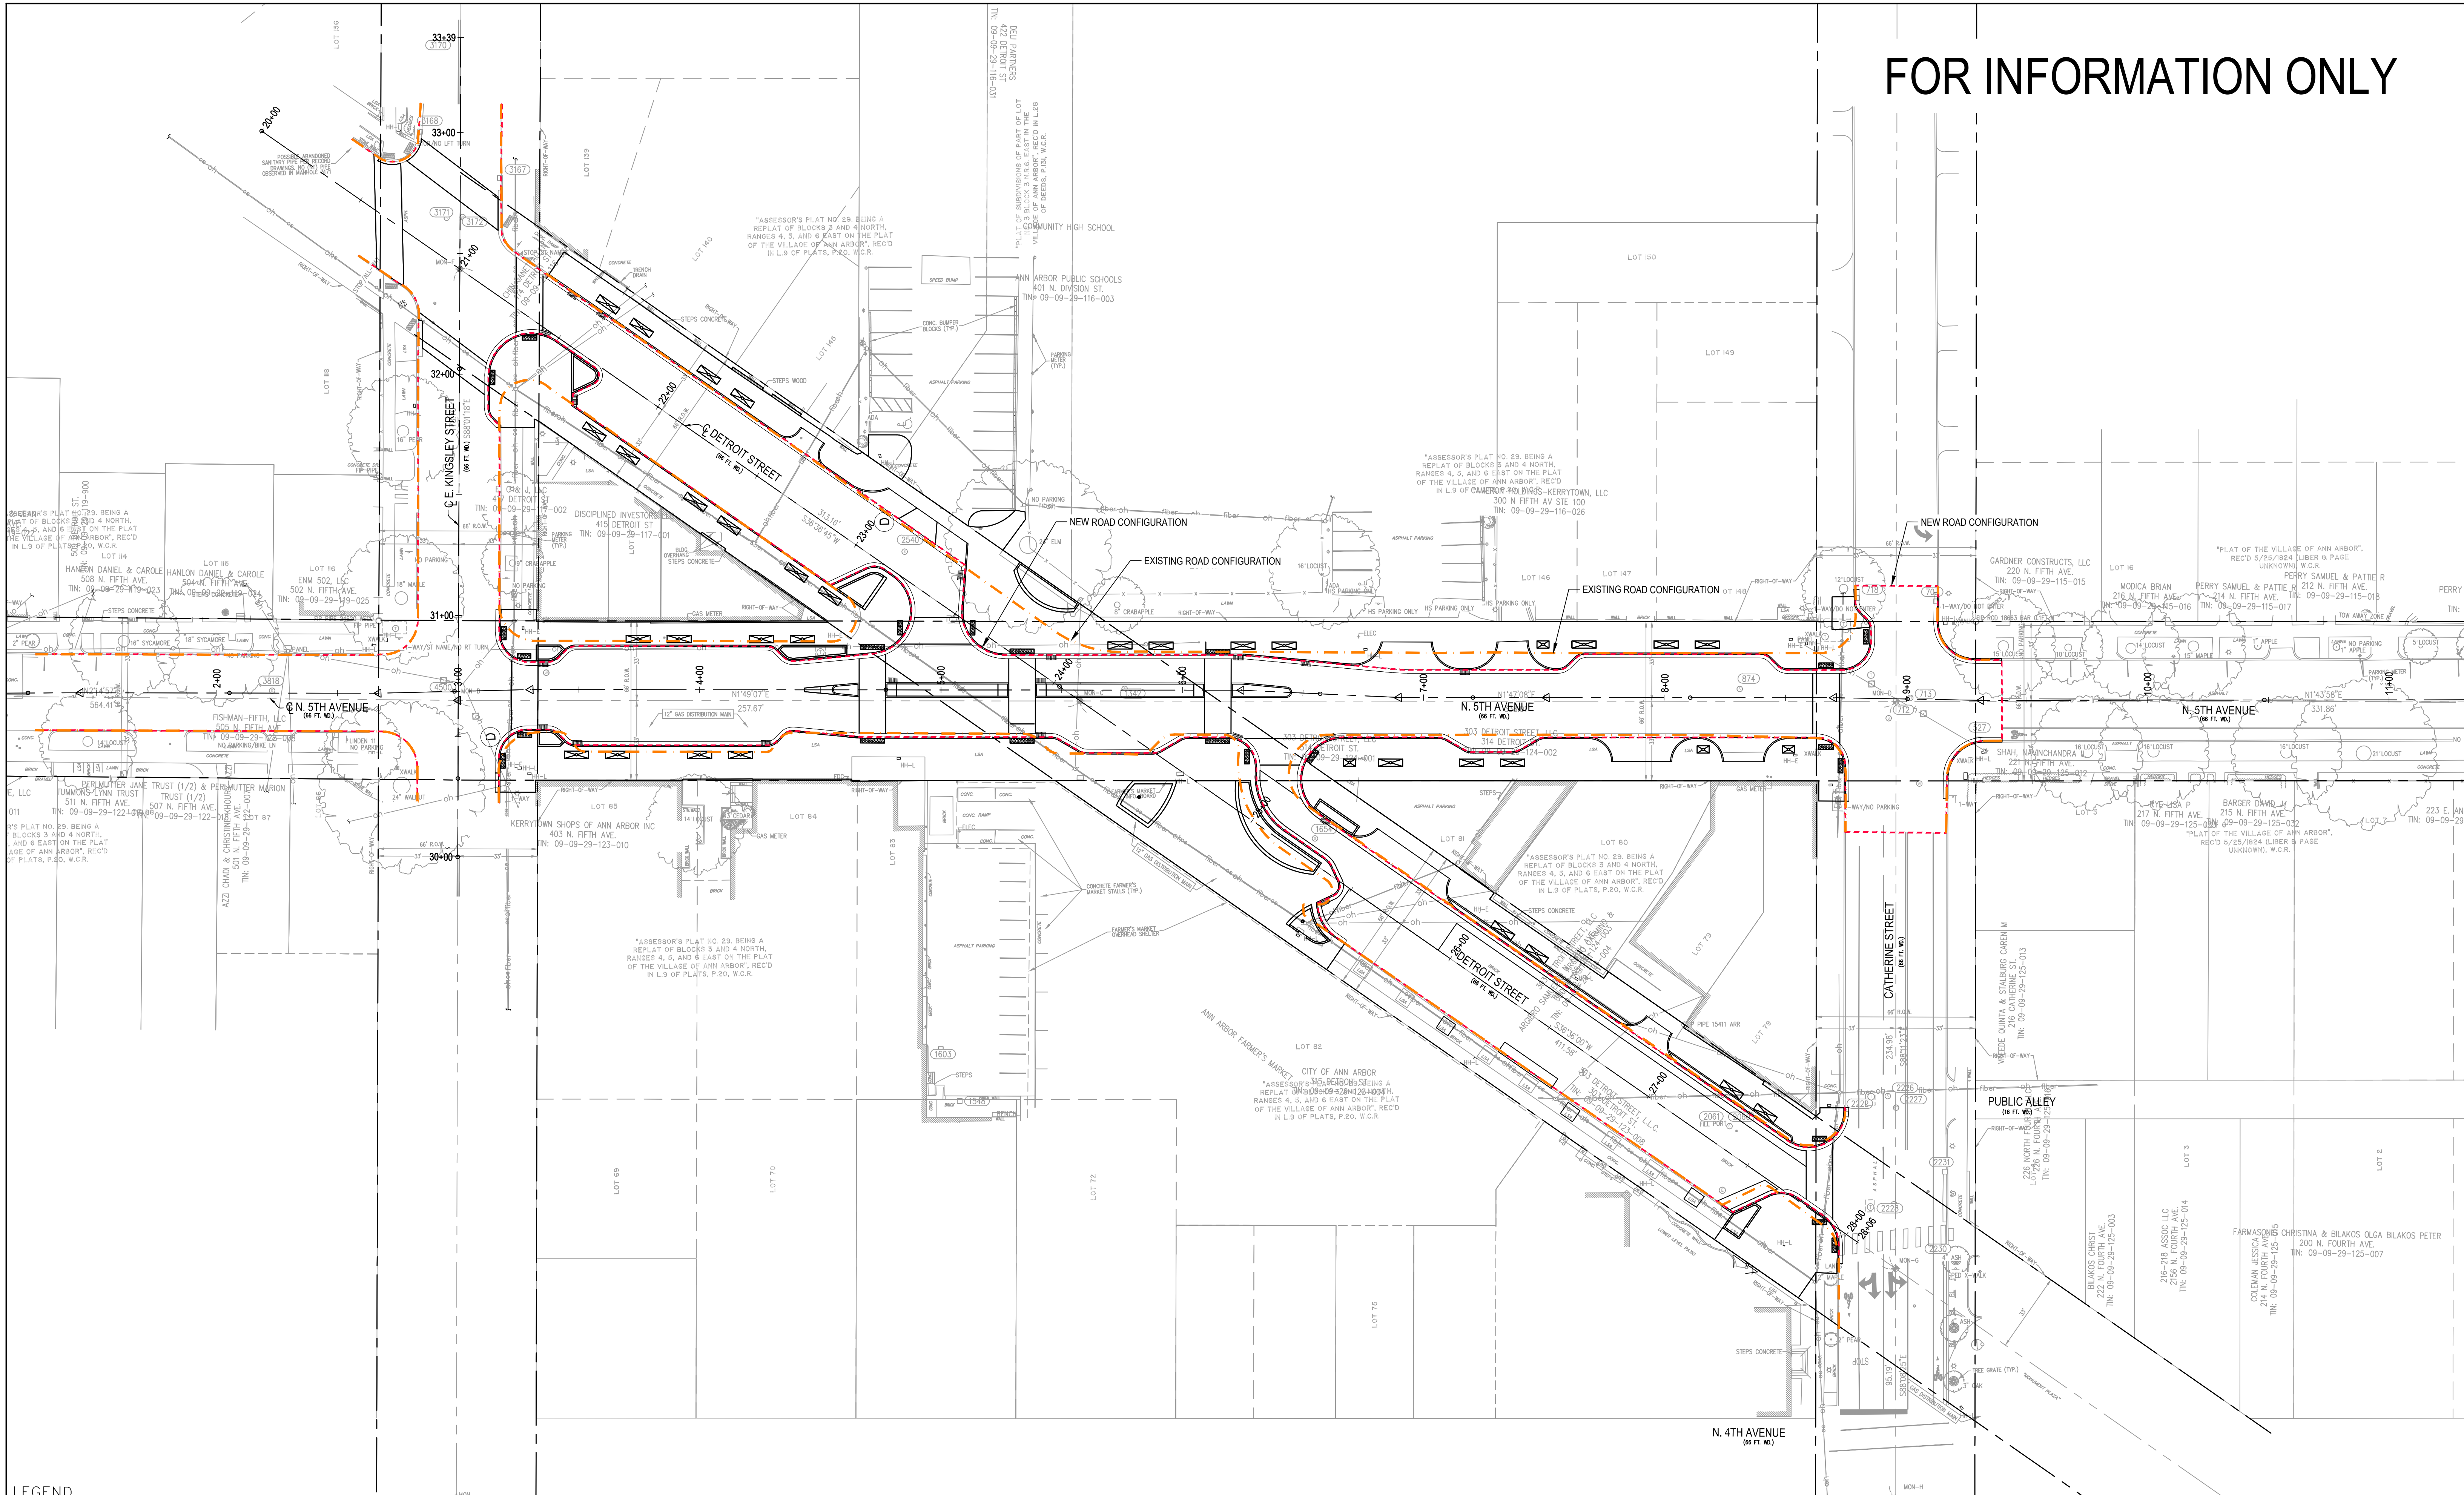

LEGEND



SEE ABOVE	BENCH MARK	SURVEY BOOK	REV. NO.	DESCRIPTION	DATE	DR. BY	CH. BY
				ADDENDUM NO 1	01-04-2018		

DOWNTOWN DEVELOPMENT AUTHORITY - CITY OF ANN ARBOR

COMPARISON BETWEEN EXISTING AND PROPOSED ROAD CONFIGURATIONS

SCALE	INCH
1" = 30'	
DRAWING NO.	
SHEET NO.	OF