


CITY OF ANN ARBOR, MICHIGAN WTP LIME RESIDUAL REMOVAL CONTRACT NO.2 - DREDGING AND HAULING

710 AVIS DRIVE, SUITE 100
ANN ARBOR, MI 48108
Tel. 734.665.6000 Fax. 734.213.3003

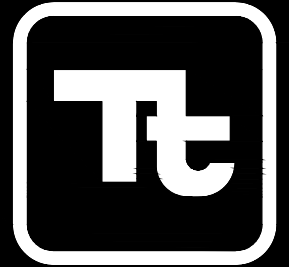

TETRA TECH

www.tetrattech.com

PROJECT LOCATION:

919 SUNSET RD
ANN ARBOR, MI 48103

CLIENT INFORMATION:

CITY OF ANN ARBOR
WATER TREATMENT SERVICES UNIT

Tt PROJECT No.:
200-31537-17002


CLIENT PROJECT No.:
CONTRACT NO. 2 OF 3 - ITB #: 4561, FILE #: 19004

PROJECT DESCRIPTION / NOTES:

DREDGING, DEWATERING, HAULING AND DISPOSAL OF LIME RESIDUALS FROM LAGOON.


ISSUED:

VICINITY MAP:

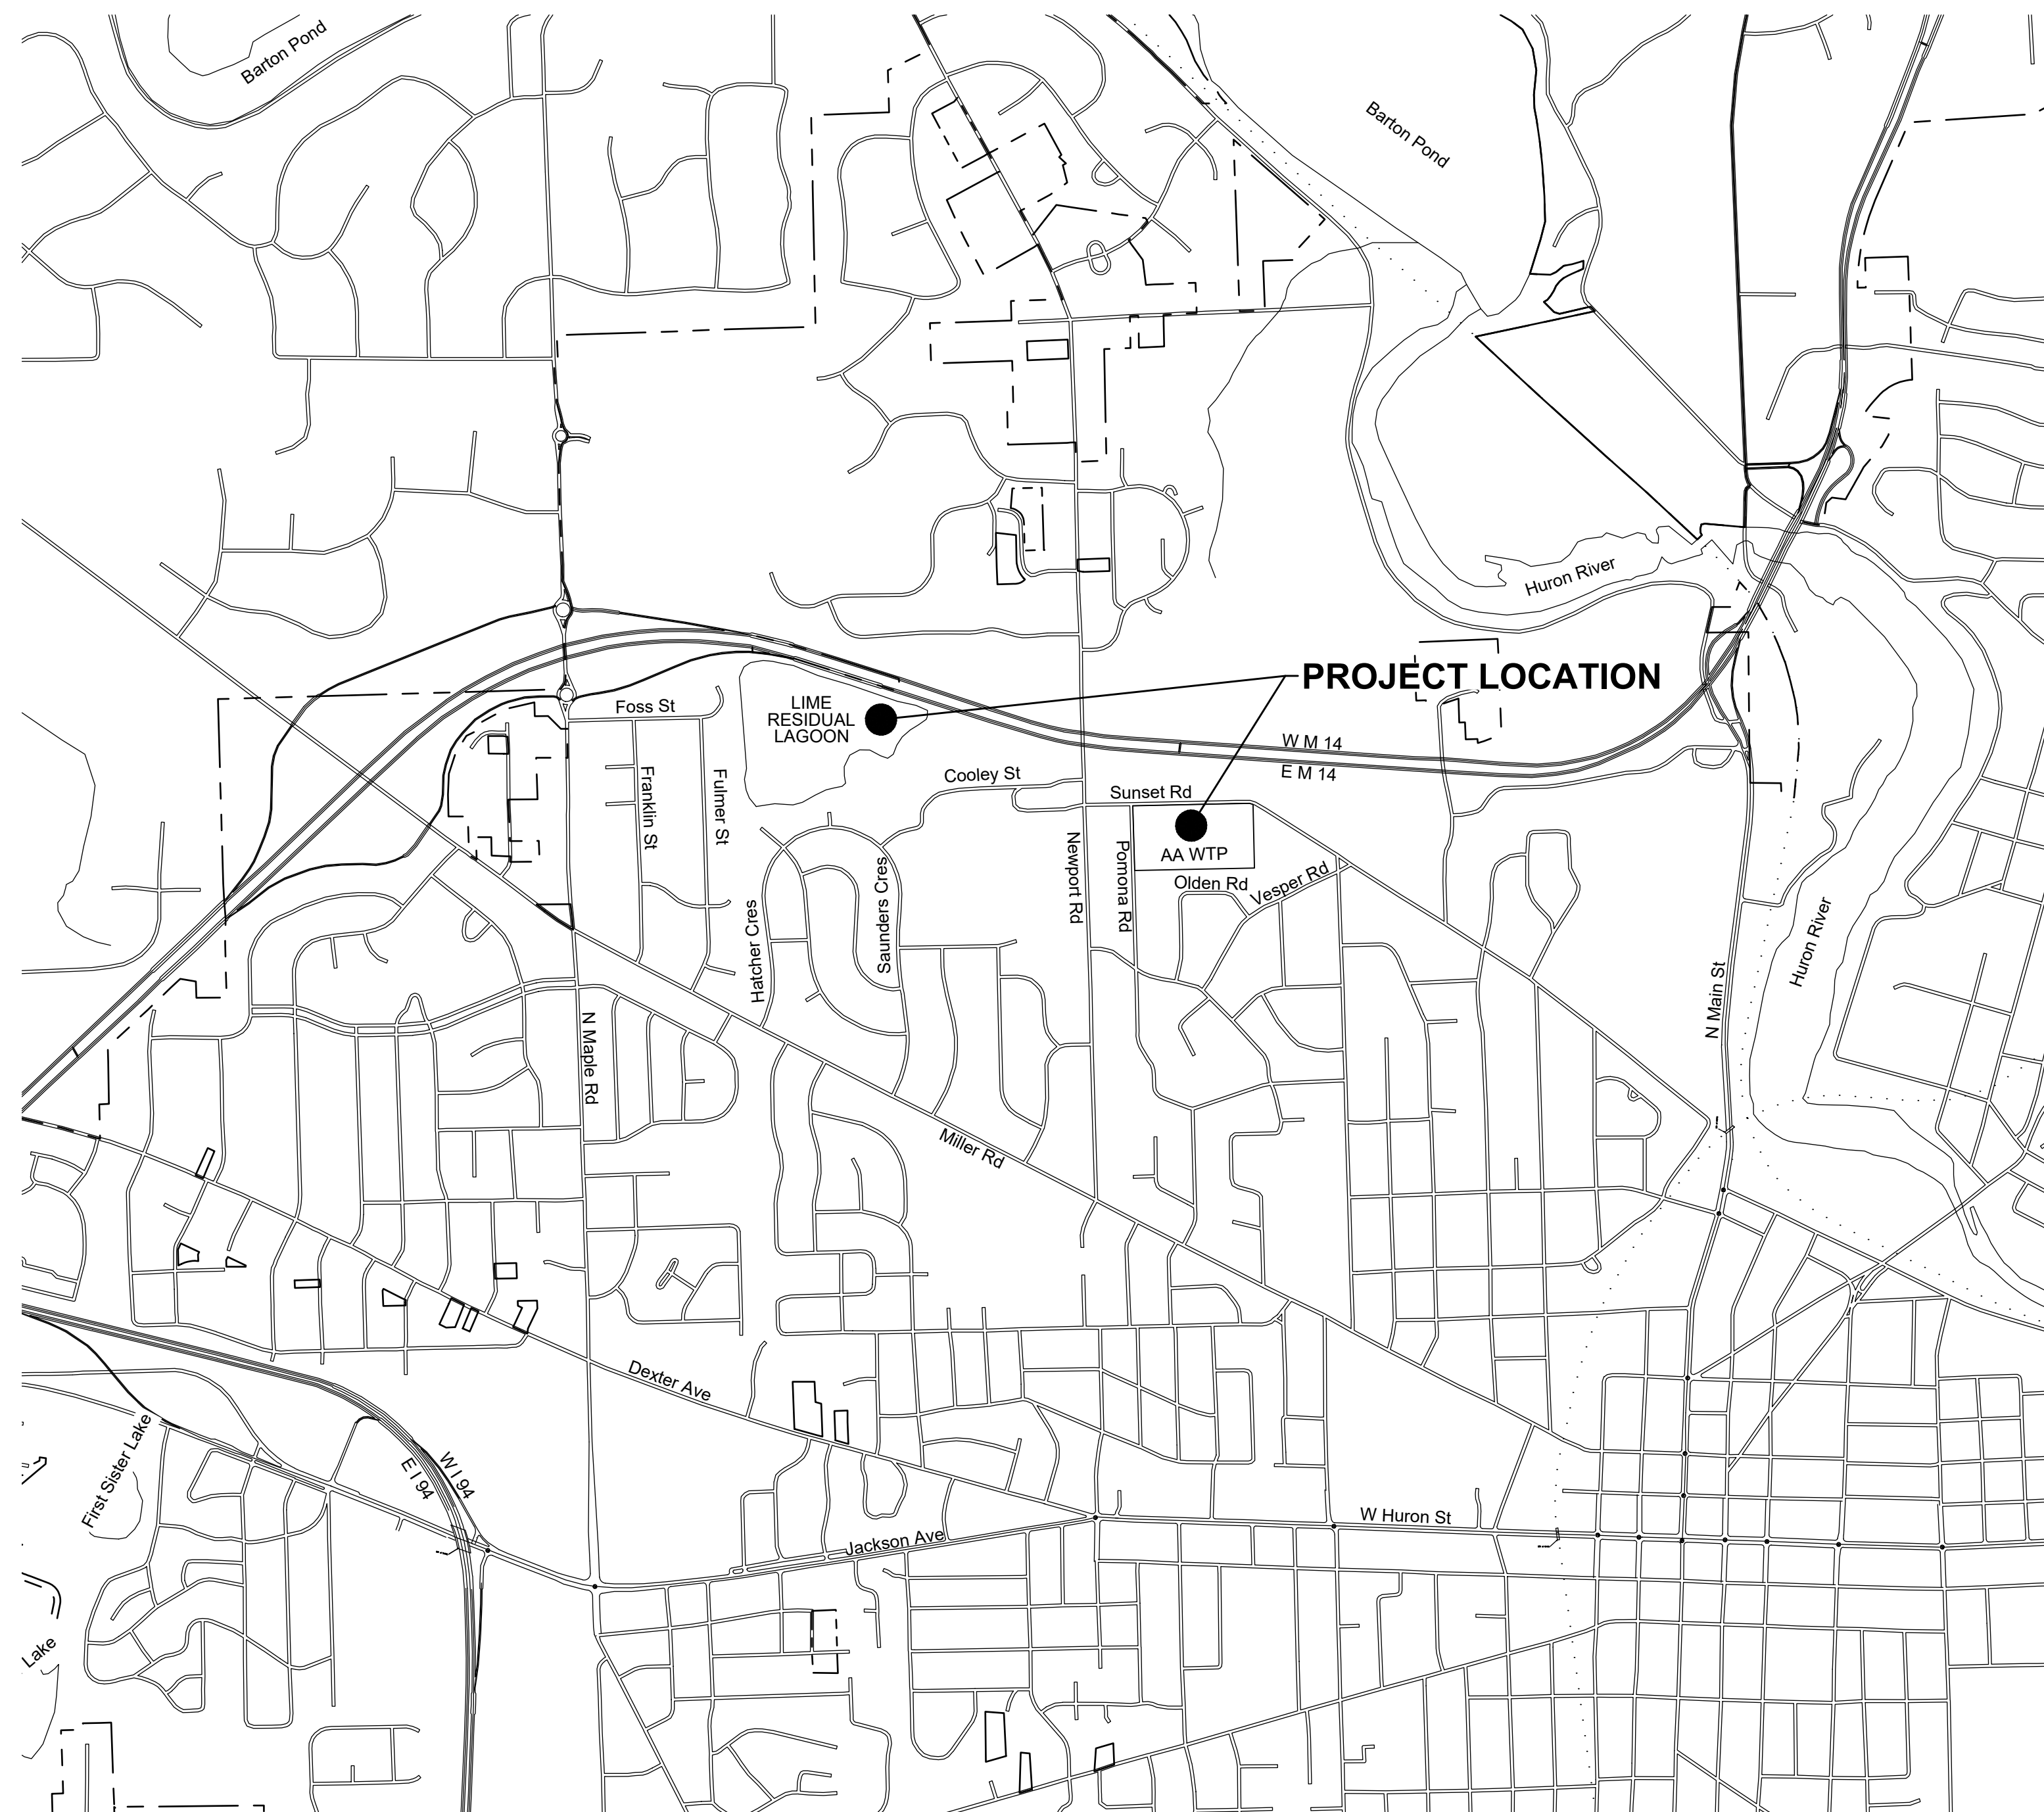


SHEET INDEX	
NUMBER	TITLE
C-000	COVER SHEET
C-021	LEGEND, OVERALL SITE PLAN & NOTES
C-121	LIME RESIDUAL LAGOON EXISTING SITE PLAN
C-122	WATER TREATMENT PLANT SITE PLAN
C-123	SESC & STANDARD DETAILS
C-124	8 IN FM PLAN & PROFILE - FOR INFO ONLY
C-125	8 IN FM PLAN & PROFILE - FOR INFO ONLY


LOCATION MAP
SCALE: 1" = 1000'

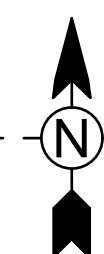

Please allow for 3 full working days before you dig - call the MISS DIG System at 811 or 800-482-7171.

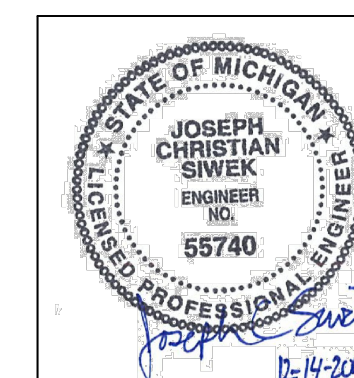

ANN ARBOR, MICHIGAN

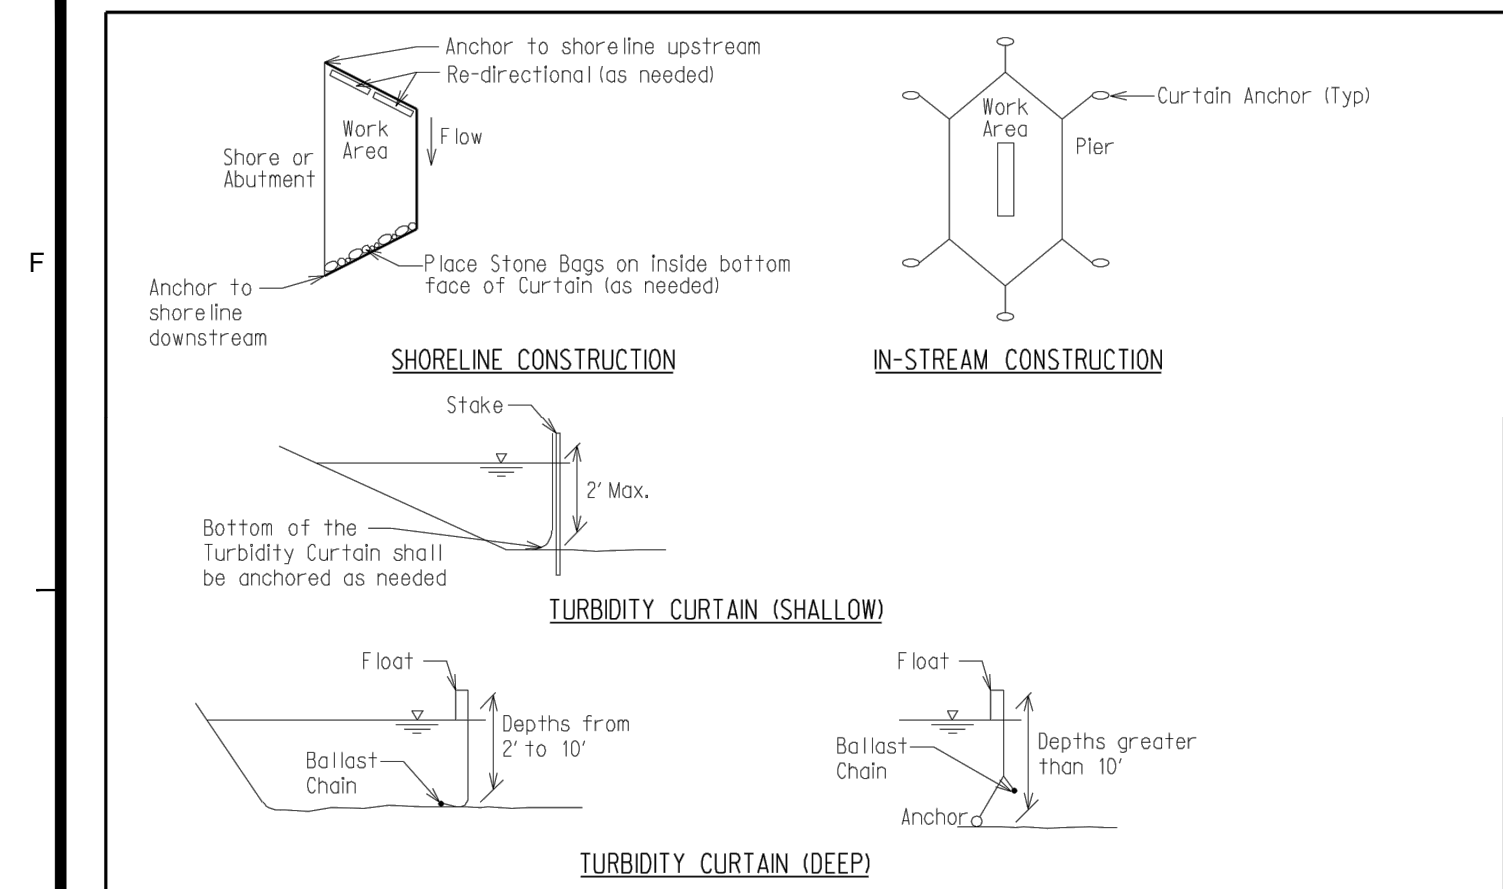

Use:
A Turbidity Curtain is used when slack water area is necessary to isolate construction activities from the watercourse. The Turbidity Curtain system shall be designed to handle site specific drainage or flow patterns. When water is less than 2 feet deep and has low flow, Turbidity Curtain (Shallow) may be used. Curtain shall be securely fastened to stakes. Water greater than 2 feet deep or where high flow exists requires the use of Turbidity Curtain (Deep).

Installation and Maintenance:
The Turbidity Curtain shall be installed at the location shown on the plans and according to the special provision. The Turbidity Curtain shall be placed parallel to the direction of flow and anchored upstream, downstream, and to the stream bed to maximize protection to the watercourse. The Contractor shall maintain the Turbidity Curtain until the construction activity within the watercourse is complete or as approved by the Engineer. Retained sediment shall be removed to the maximum extent practicable prior to removing the curtain.

Optional Measures:
The Turbidity Curtain may include a re-directional barrier on the upstream end of the work area.


Related SESC Measures:
E & S-18 Dewatering with Filter Bag
E & S-24 Sand and Stone Bags
E & S-34 Cofferdam

Measurement and Payment:
Turbidity Curtain requires inclusion of the appropriate special provision in the contract documents. Payment includes furnishing and installing sufficient anchors, tie-downs, or other mechanisms to ensure proper position and performance of the Turbidity Curtain. Optional work shown, when installed and maintained as directed by the Engineer, will be paid using the associated contract item listed here.

MICHIGAN DEPARTMENT OF TRANSPORTATION
BUREAU OF HIGHWAY DEVELOPMENT SESC DETAIL FOR

Turbidity Curtain

MDOT
09-30-2005
PLAN DATE
E&S-1-A
SHEET
1 OF 1

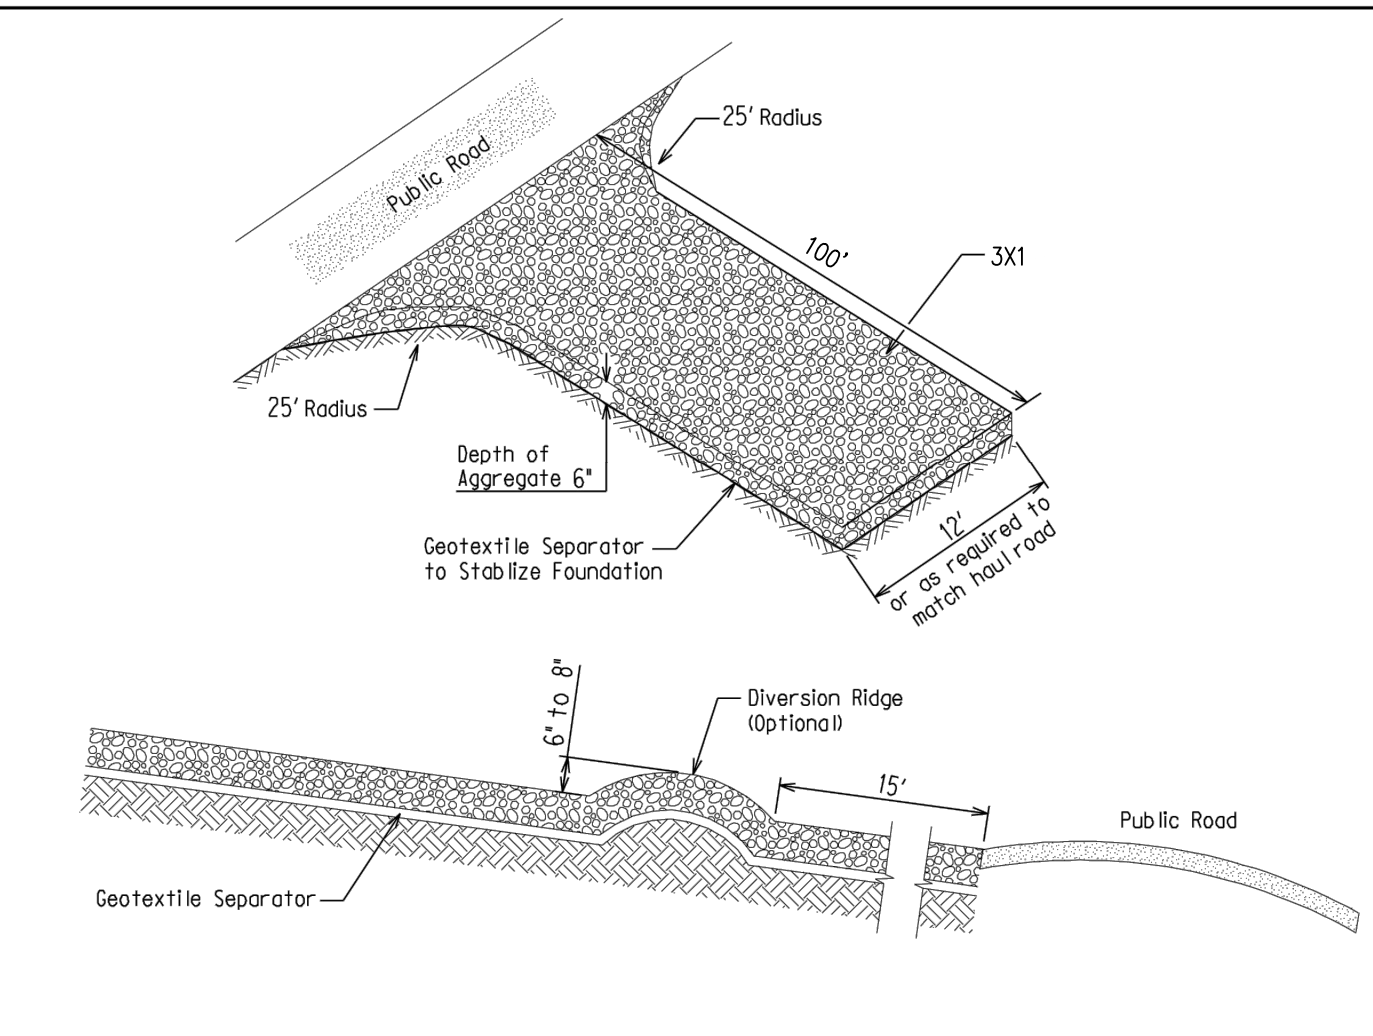

Use:
Providing a stable Gravel Access Approach, minimizes the tracking of loose materials from the construction site onto public roadways. Coarser aggregate is more effective in reducing tracking. Any materials tracked onto public roadways shall be removed as specified in the Standard Specifications for Construction, or as directed by the Engineer.

Installation and Maintenance:
Installation and maintenance of Gravel Access Approach is effective in reducing sediment loading to inlet protection devices. The Gravel Access Approach should be located in accordance with the plans or as directed by the Engineer. All vegetation and other objectionable material shall be removed from the foundation area. Geotextile Separator must be placed beneath the aggregate to stabilize the foundation. Replace or replenish aggregate if it is no longer preventing tracking.

Optional Measures:
A Gravel Access with Diversion Ridge is recommended where access grade exceeds 2%. This will also aid in dislodging soil or debris from tires.



Related SESC Measures:

Measurement and Payment:
Optional work shown, when installed and maintained as directed by the Engineer, will be included in the item Gravel Access Approach.

MICHIGAN DEPARTMENT OF TRANSPORTATION
BUREAU OF HIGHWAY DEVELOPMENT SESC DETAIL FOR

Gravel Access Approach




MDOT
04-07-2006
PLAN DATE
E&S-14-A
SHEET
1 OF 1

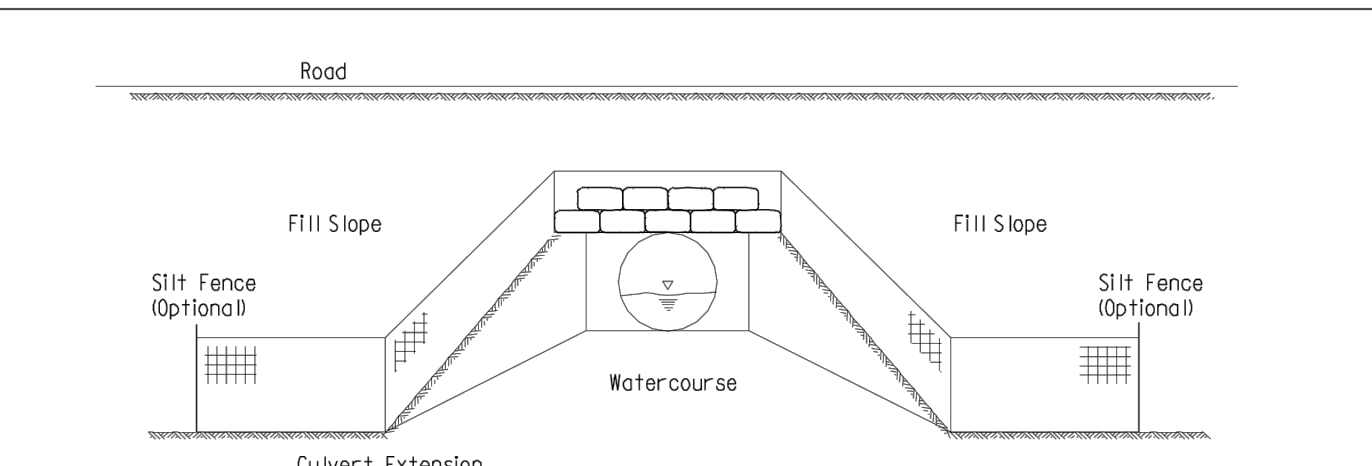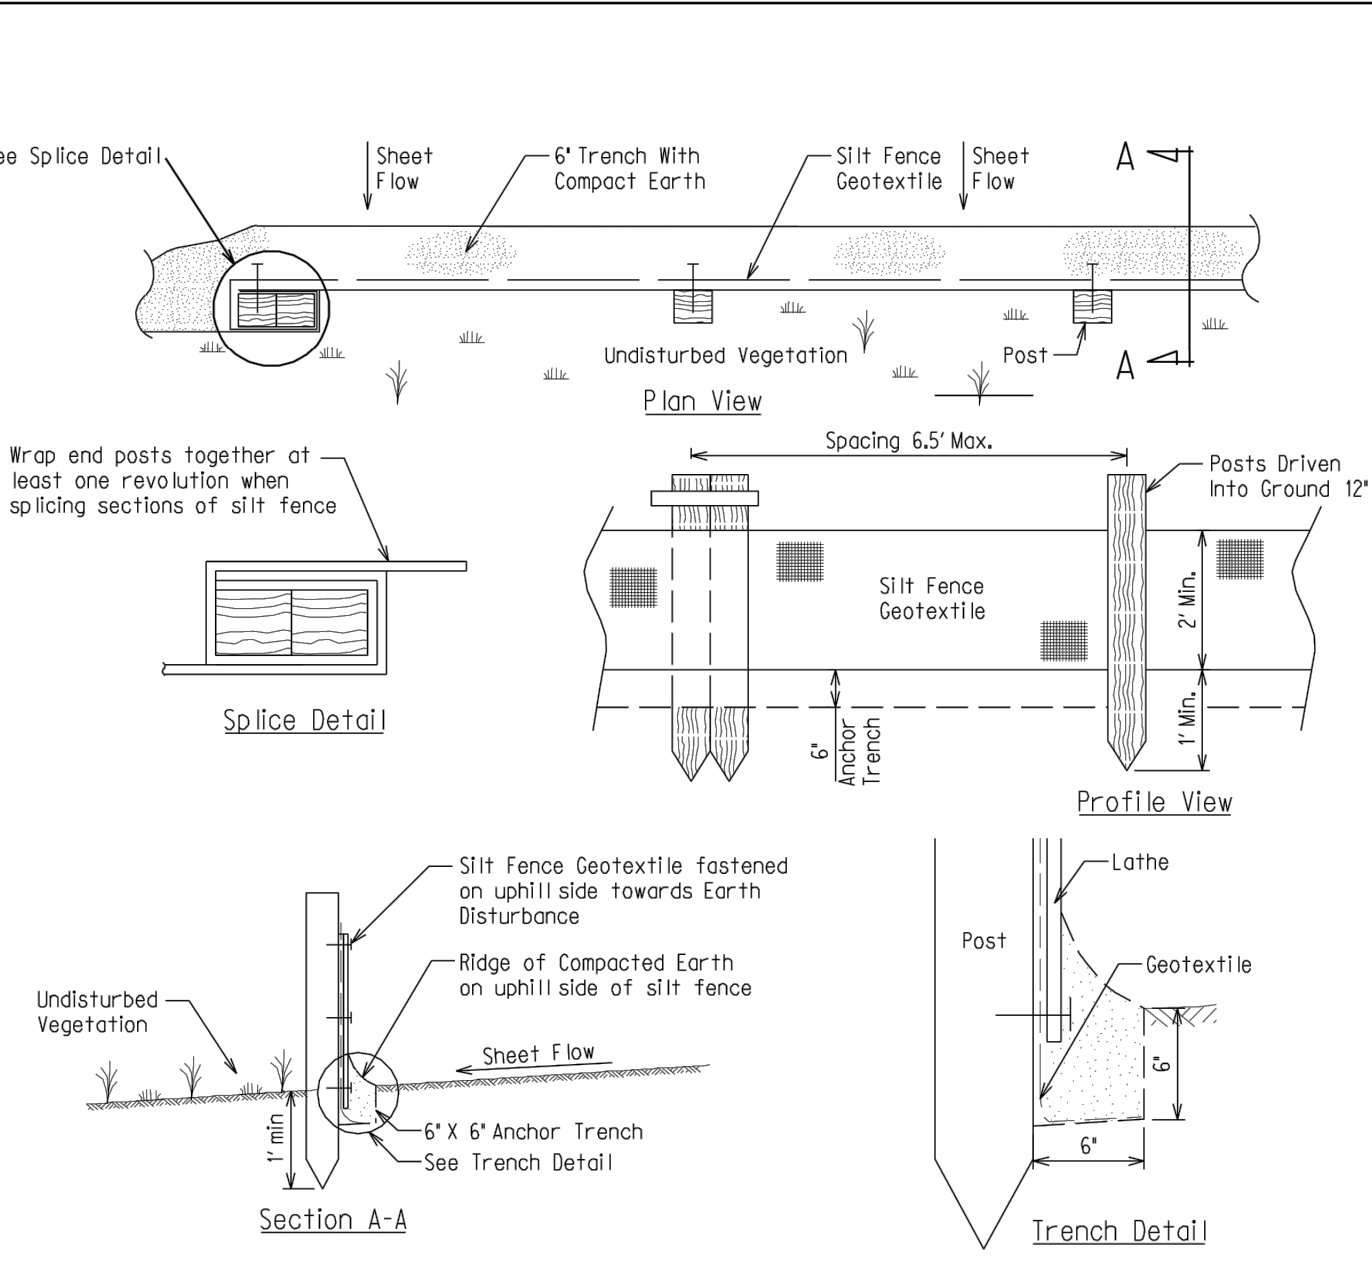

MICHIGAN DEPARTMENT OF TRANSPORTATION
BUREAU OF HIGHWAY DEVELOPMENT SESC DETAIL FOR

Silt Fence


MDOT
09-30-2005
PLAN DATE
E&S-26-A
SHEET
1 OF 2

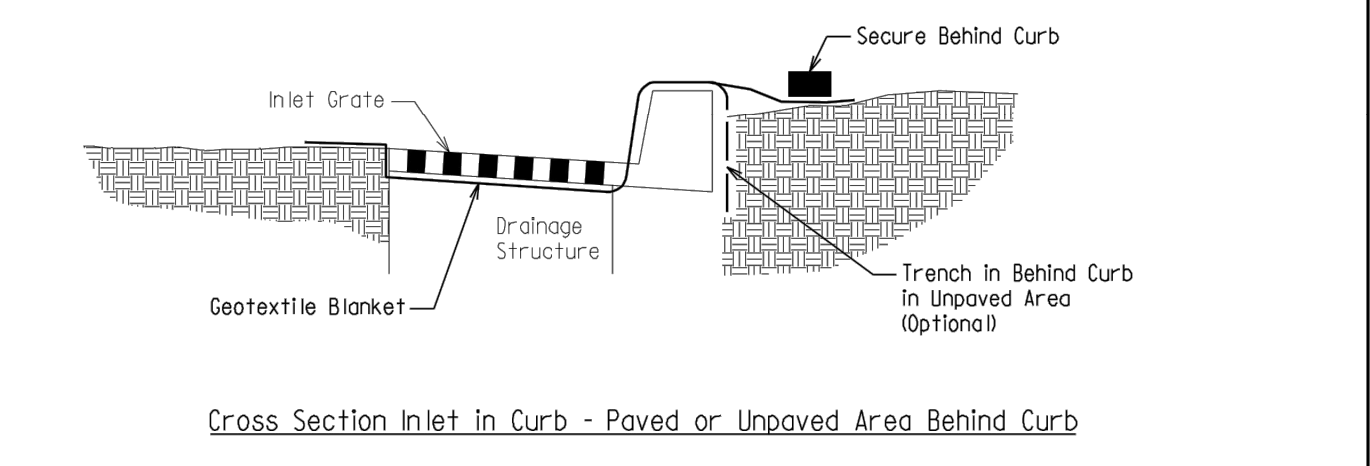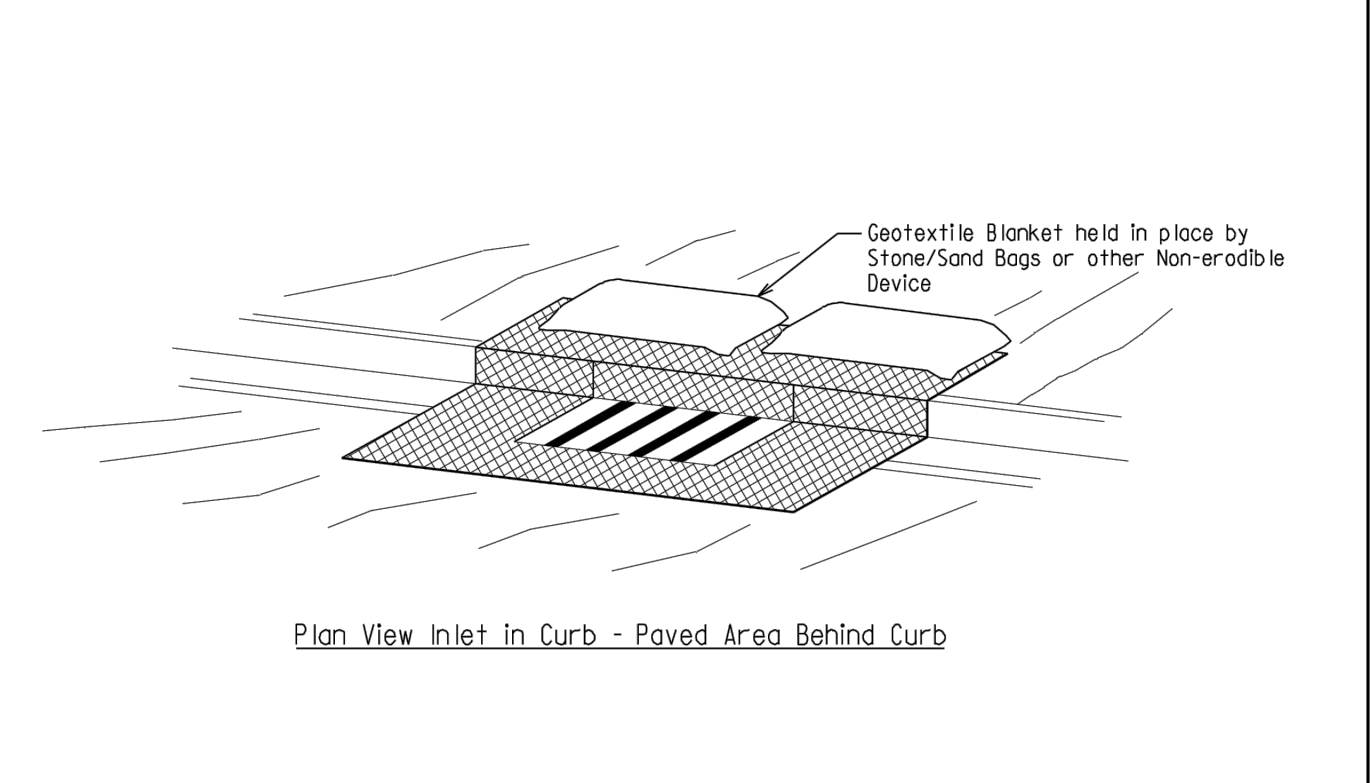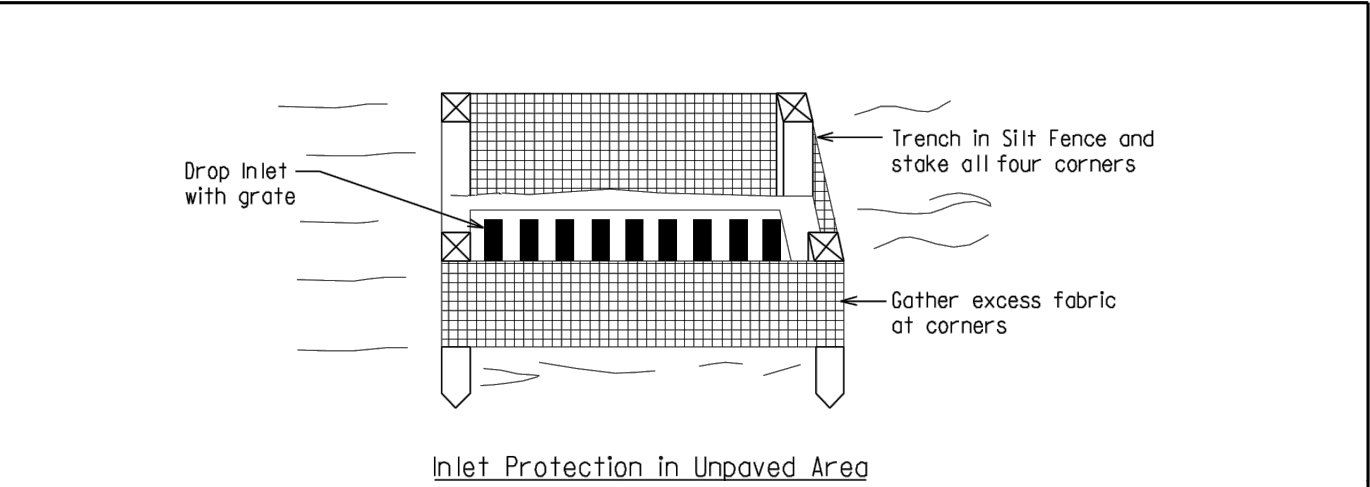

MICHIGAN DEPARTMENT OF TRANSPORTATION
BUREAU OF HIGHWAY DEVELOPMENT SESC DETAIL FOR


Inlet Protection Fabric Drop

MDOT
04-07-2006
PLAN DATE
E&S-29-A
SHEET
1 OF 2

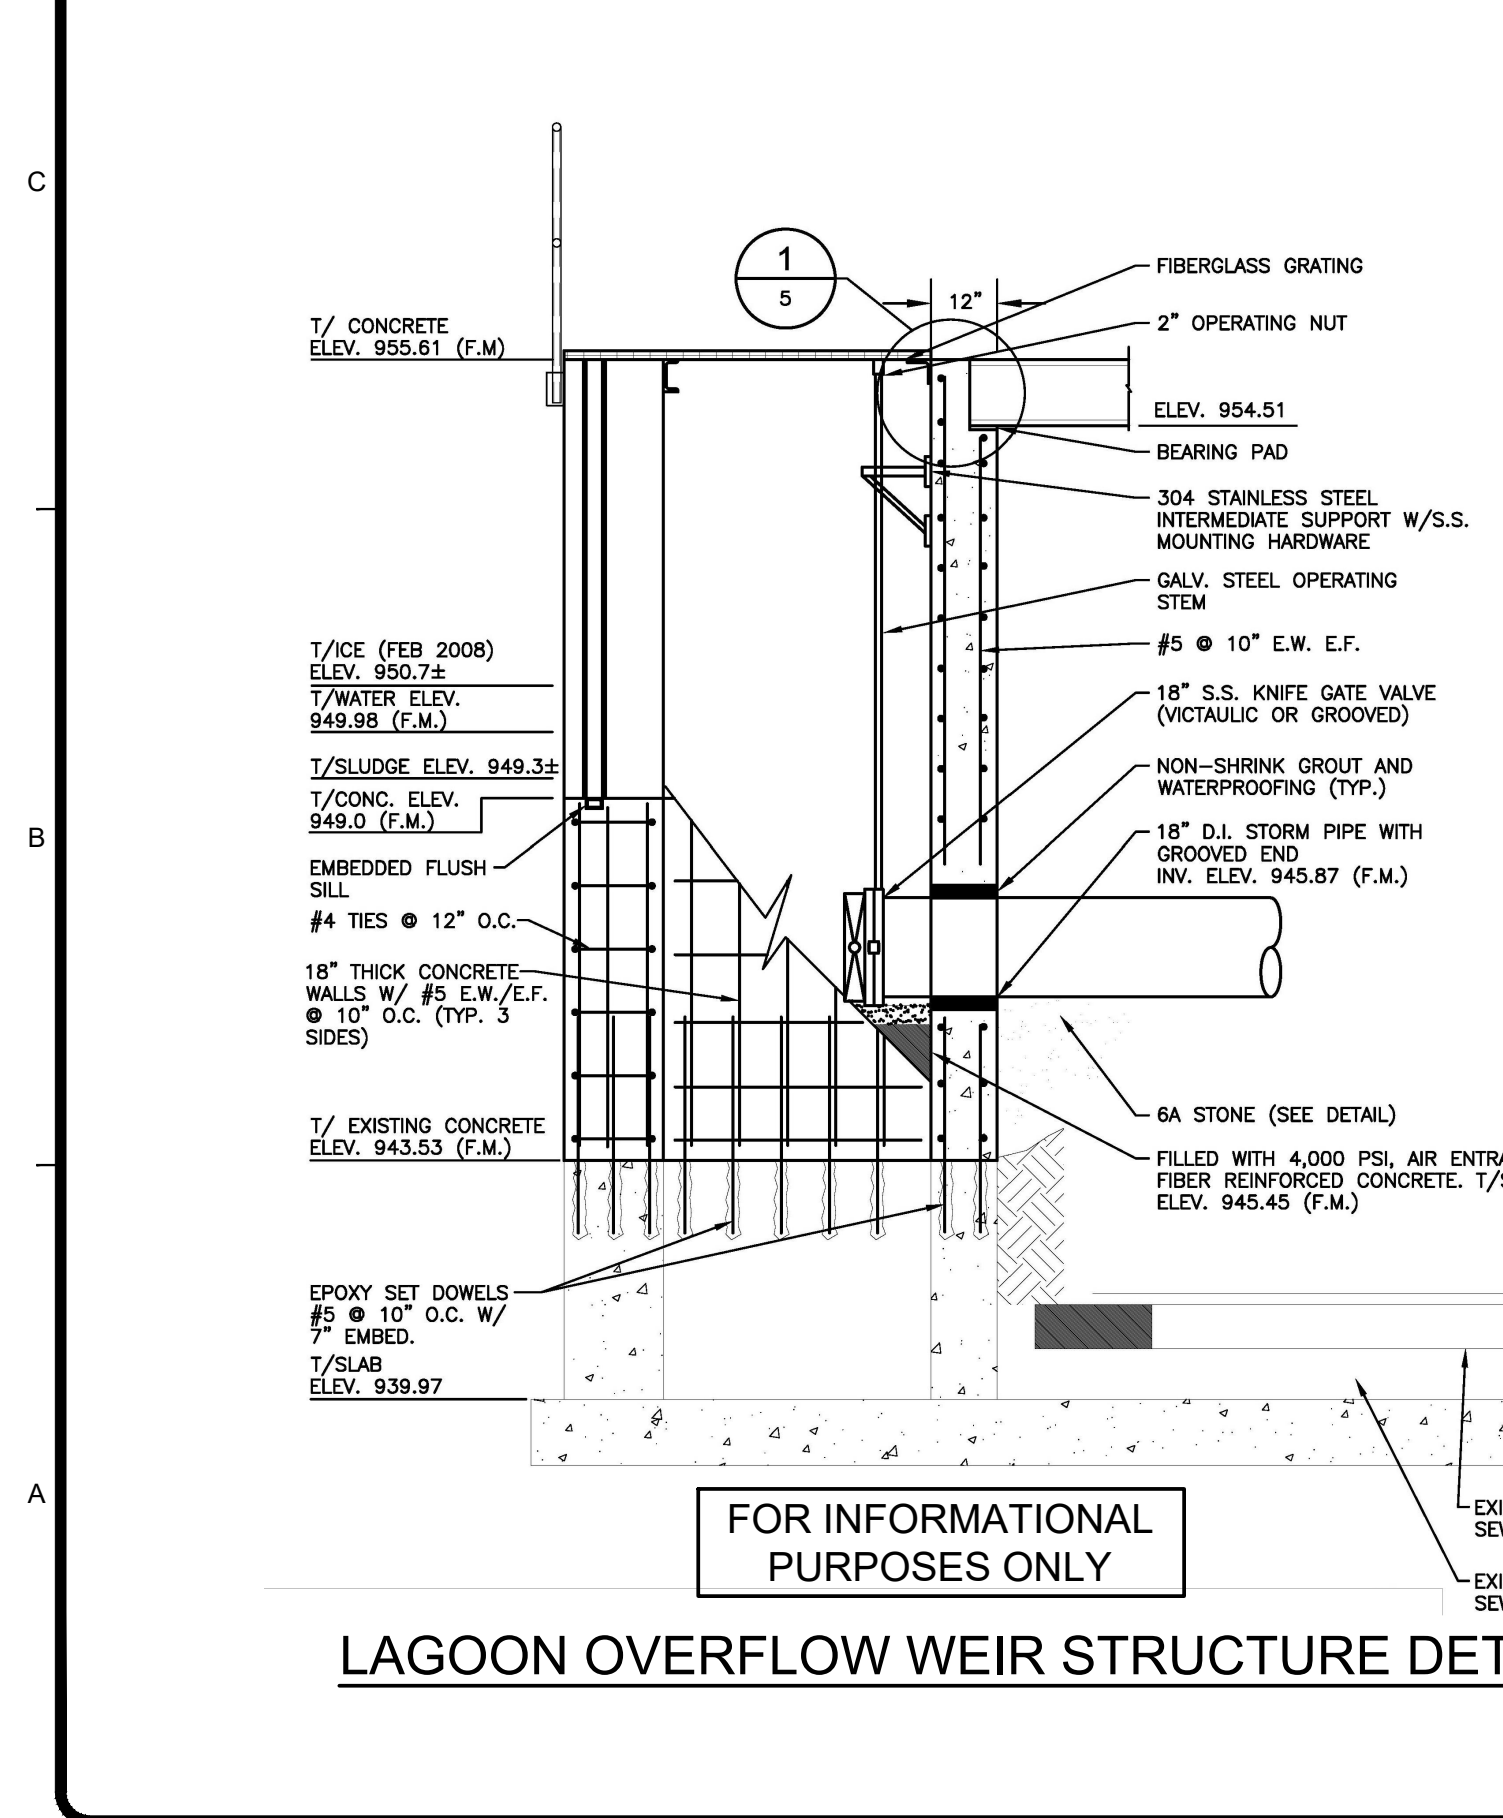

LAGOON OVERFLOW WEIR STRUCTURE DETAIL

MDOT
09-30-2005
PLAN DATE
E&S-1-A
SHEET
1 OF 1

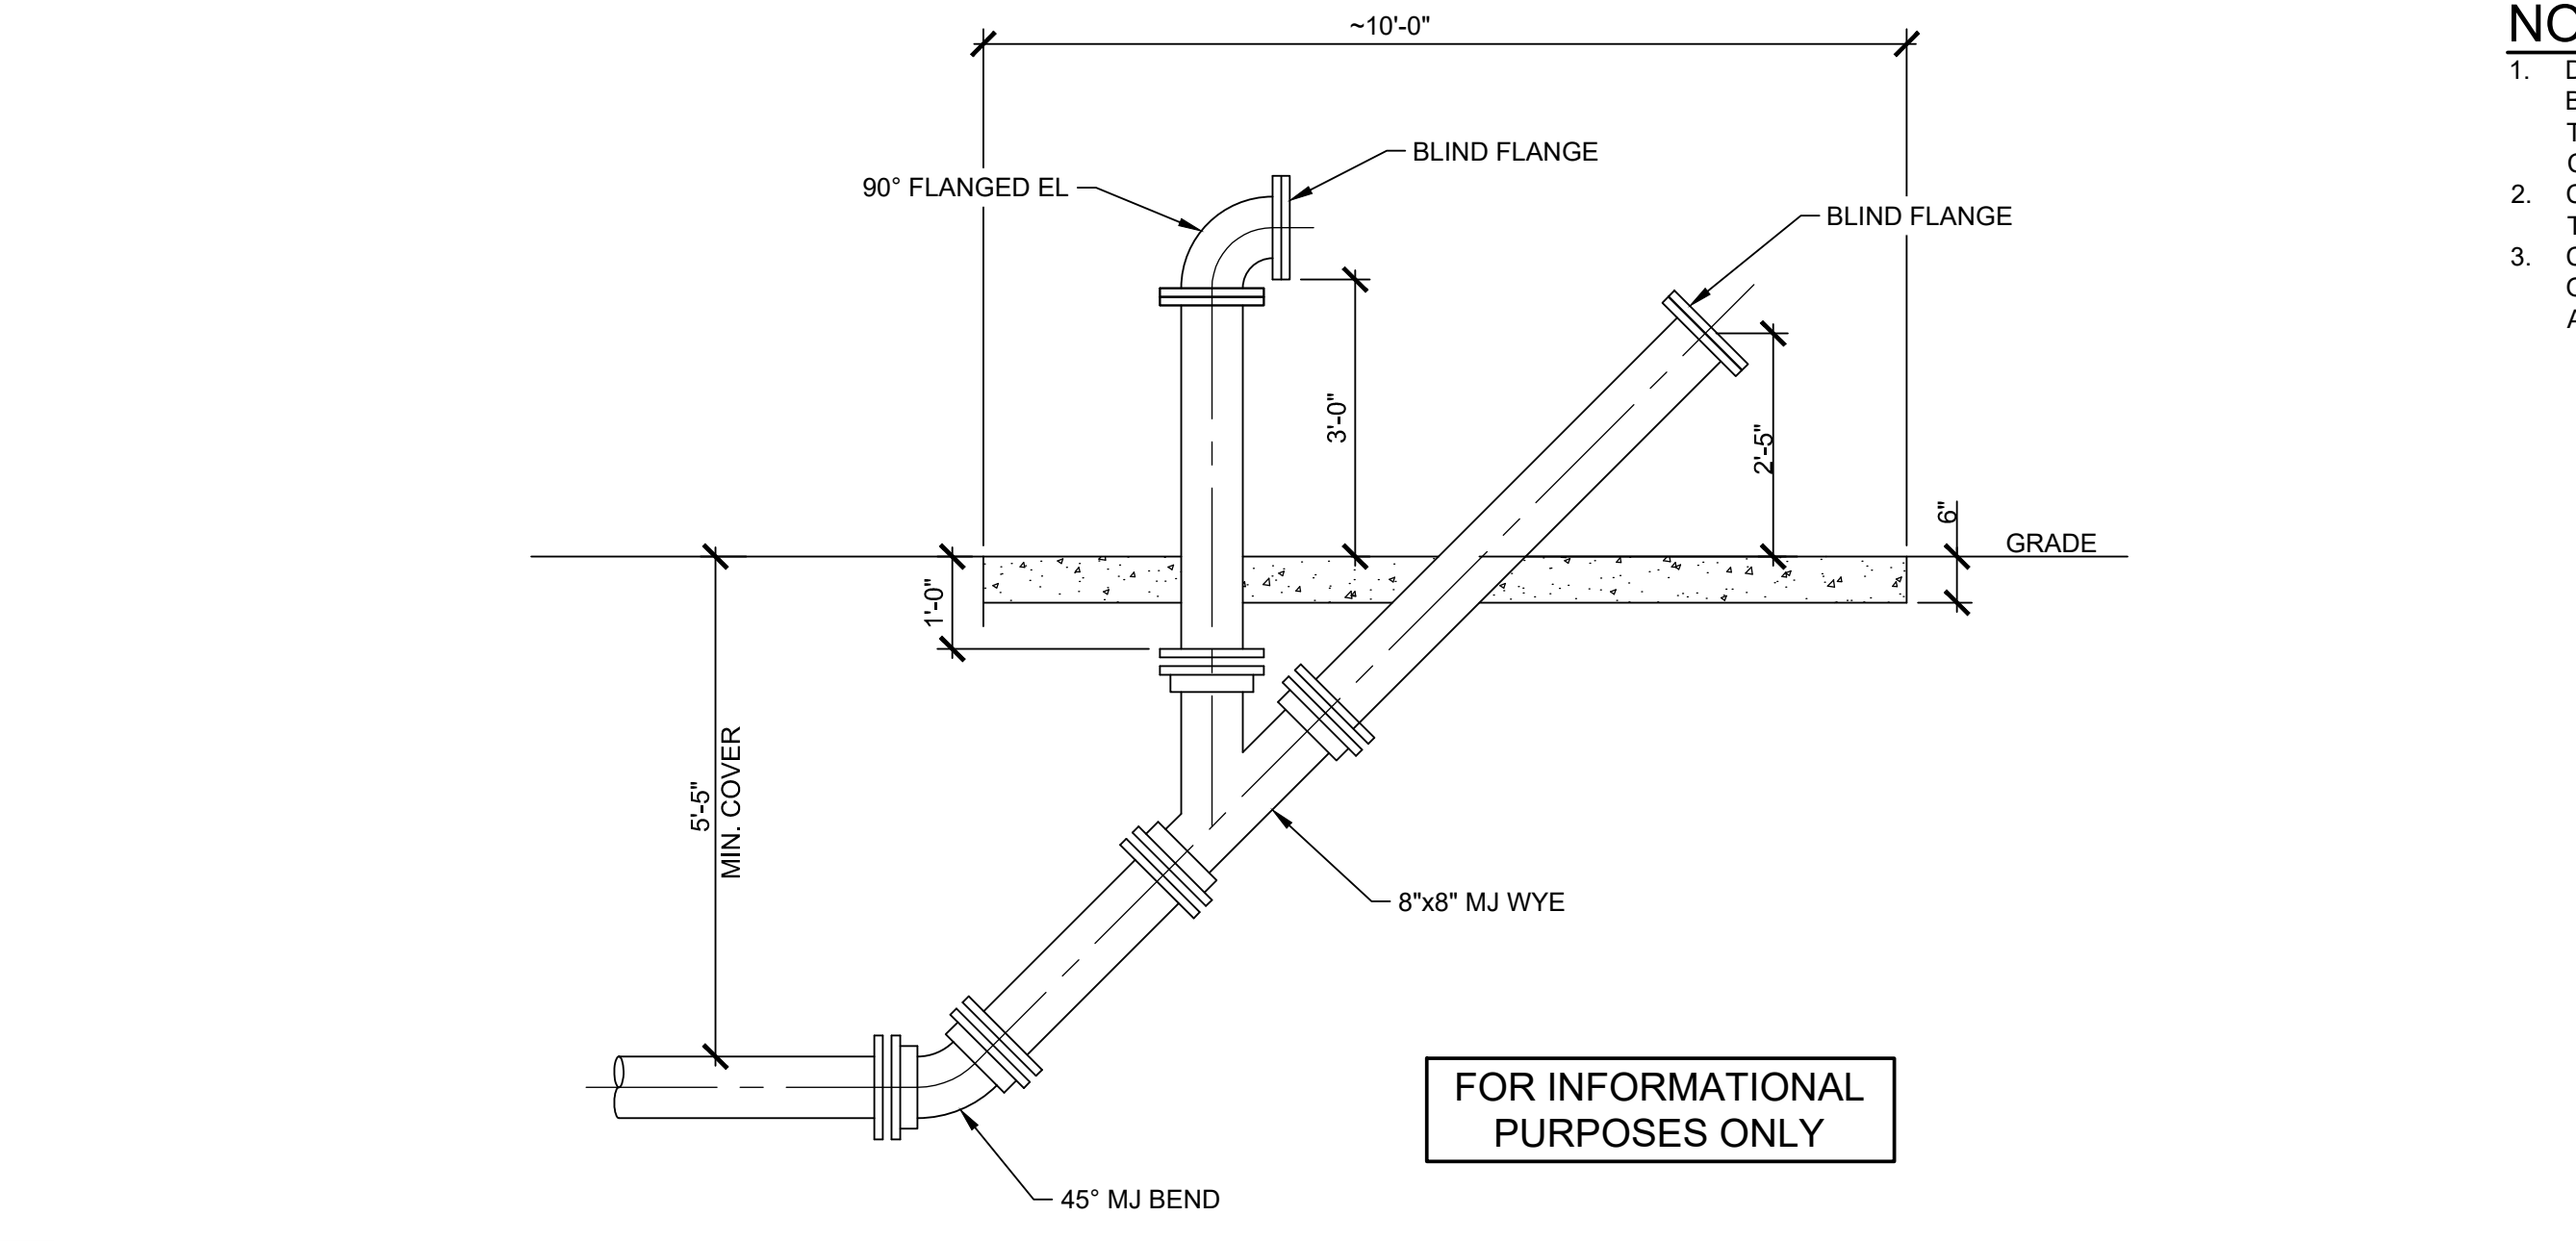

SWAB LAUNCH AND PIPE CONNECTION DETAIL
SCALE: NONE

FOR INFORMATIONAL PURPOSES ONLY

PIGGING NOTES:
1. REMOVE CAP AND INSERT POLY-PIG SWAB.
2. REPLACE CAP AND APPROPRIATE FITTINGS FOR FLUSHING AND/OR TESTING.
3. USING PRESSURE PUMP, INSERT POLY-PIG SWAB INTO FORCE MAIN TO BE SWABBED. WHEN SWAB IS IN MAIN, STOP PUMP, MOMENTARILY, THEN BEGIN FLUSHING MAIN.
4. CONTRACTOR TO ADJUST THE ORIENTATION OF THE DISCHARGE BY REALIGNING THE 90 DEGREE BEND TO SUIT THEIR OPERATIONS. CONTRACTOR TO FURNISH ALL FITTINGS TO WORK WITH THEIR PUMPING AND TESTING EQUIPMENT. UPON COMPLETION OF THE WORK, AND ALL FLUSHING OF THE FORCE MAIN IS COMPLETE THE CONTRACTOR SHALL PUMP WATER OUT OF THE STAND PIPES TO A MINIMUM 5 FEET BELOW GRADE AND REINSTALL THE BLIND FLANGES.

NOTES:
1. DETAILS ARE PROVIDED FOR PROPOSED AND EXISTING SESC BMP'S LEFT IN PLACE FROM CONTRACT NO. 1. SESC BMP'S LEFT IN PLACE FROM CONTRACT NO. 1 THAT ARE TO BE RE-USED IN CONTRACT NO. 2 SHALL BE MAINTAINED THROUGHOUT THE COURSE OF THE CONTRACT. ALL SESC BMP'S SHALL BE REMOVED BY CONTRACTOR UPON COMPLETION OF CONTRACT 2.
2. CONTRACTOR SHALL REMOVE ALL INLET PROTECTIONS LOCATED WITHIN CITY STREETS UPON THE COMPLETION OF THE TRUCKING PORTION OF THE PROJECT.
3. CONTRACTOR SHALL ANCHOR TURBIDITY CURTAIN TO PROVIDE PROTECTION ENTIRELY AROUND THE EXISTING OVERFLOW STRUCTURE. CONTRACTOR SHALL CHECK THE SECURITY OF THE INSTALLATION BEFORE AND AFTER ANY STORM EVENTS.

SOIL EROSION & SEDIMENTATION CONTROL MEASURES KEY

APPLICABLE SOIL EROSION AND SEDIMENTATION CONTROL MEASURES (COMPREHENSIVE DETAILS ARE LOCATED IN SECTION 7 OF THE SOIL EROSION & SEDIMENTATION CONTROL MANUAL)

A = SLOPES
B = STREAMS AND WATERWAYS
C = SURFACE DRAINAGEWAYS
D = ENCLOSED DRAINAGE (INLET & OUTFALL CONTROL)
E = LARGE FLAT SURFACE AREAS
F = BORROW AND STOCKPILE AREAS
G = MDEQ PERMIT MAY BE REQUIRED

KEY	DETAIL	CHARACTERISTICS	A	B	C	D	E	F	G
1	TURBIDITY CURTAIN	A Turbidity Curtain is used when slack water area is necessary to isolate construction activities from the watercourse. The still water area contains the sediments within the construction limits.							
14	GRAVEL ACCESS APPROACH	Provides a stable access to roadways minimizing fugitive dust and tracking of materials onto public streets and highways.							
26	GEOTEXTILE SILT FENCE	A permeable barrier erected below disturbed areas to capture sediments from sheet flow. Can be used to divert small volumes of water to stable outlets. Ineffective as a filter and should never be placed across streams or ditches where flow is concentrated.							
29	INLET PROTECTION FABRIC DROP	Provides settling and filtering of silt laden water prior to its entry into the drainage system. Can be used in median and side ditches where vegetation will be disturbed. Allows for early use of drainage systems prior to project completion.							

TETRA TECH
www.tetra-tech.com

BY: _____ DATE: _____

MARK: _____ DESCRIPTION: _____

CITY OF ANN ARBOR, MI
CONTRACT NO. 2 - LIME RESIDUAL REMOVAL DREDGING AND HAULING
STANDARD DETAILS
SESC & SESC

PROJ: 200-31537-17002
DESIGN: J. SIWEK
DRAWN: S. GOTHA
CHECKED: B. RUBEL






C-123
Sheet

Copyright: Tetra Tech

AS-BUILT WATER DRAWING
 CONST. COMP. DATE 11-2008
 MDEQ PERMIT No. W073126
 IN SERVICE DATE (MO/YR) 12/08
 CONTRACTOR E.T. MACKENZIE

NOTE:
 Data contained on this page was drawn from City records. No guarantee is made as to its accuracy or completeness.

DIGITAL STATUS
 SCANNED ON 1/10
 BY: [Signature]

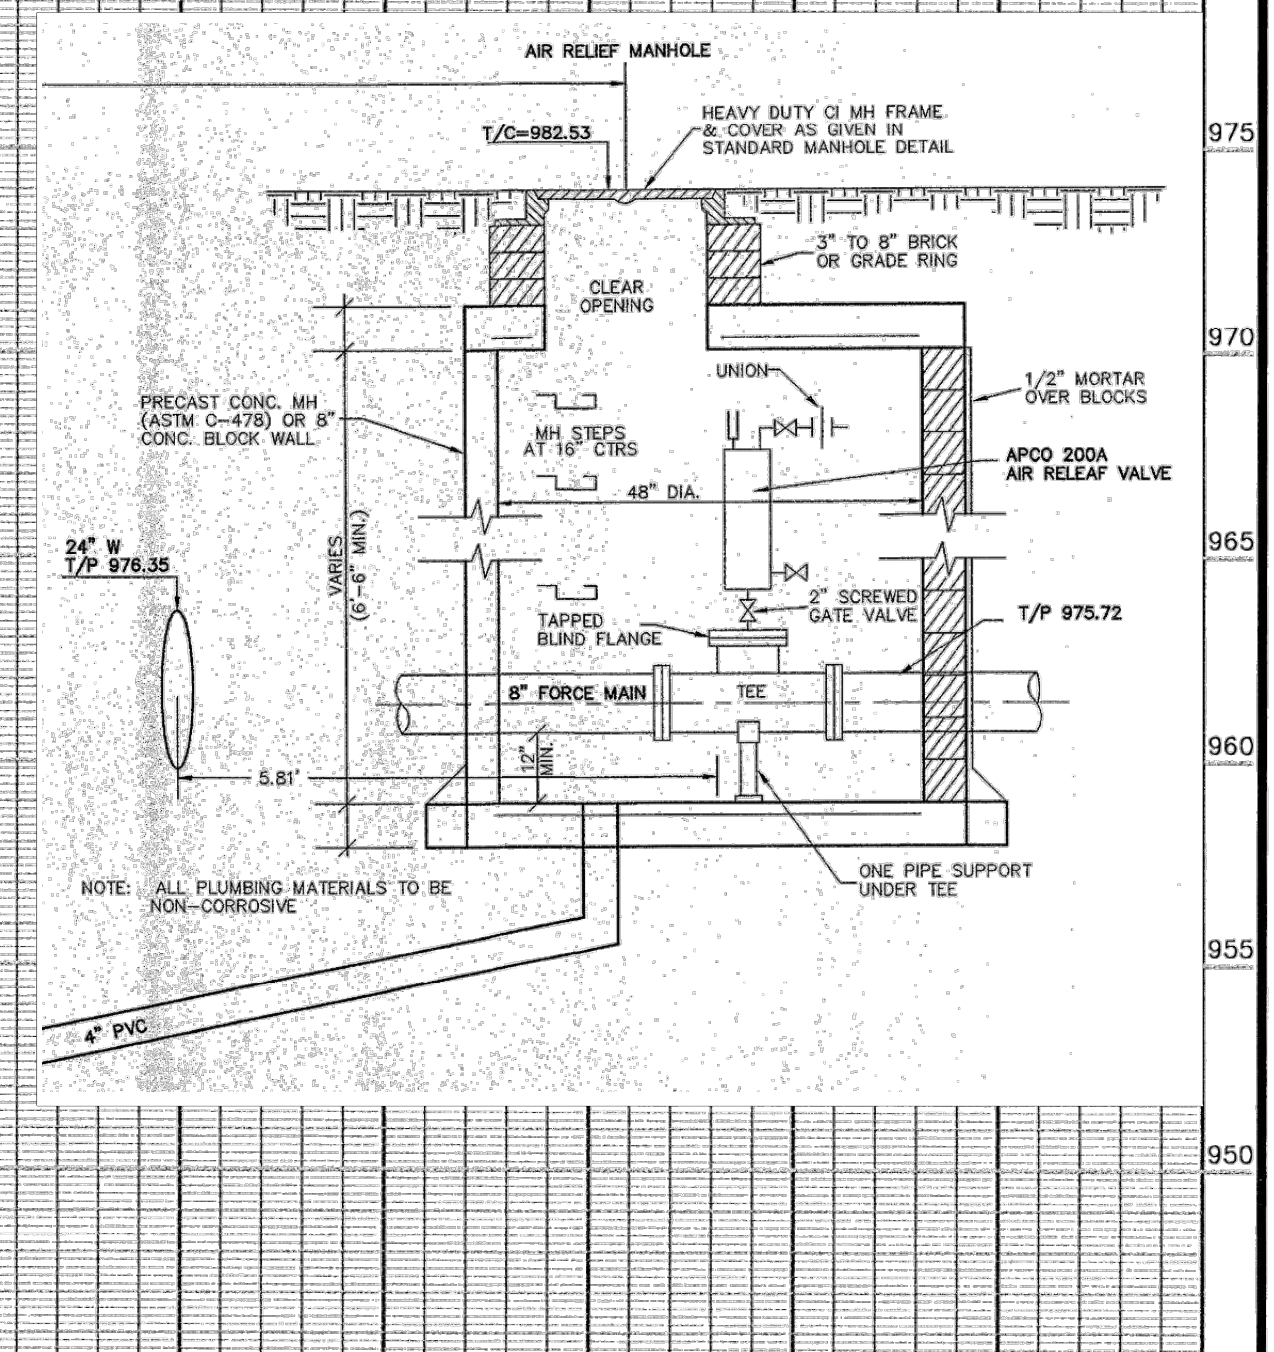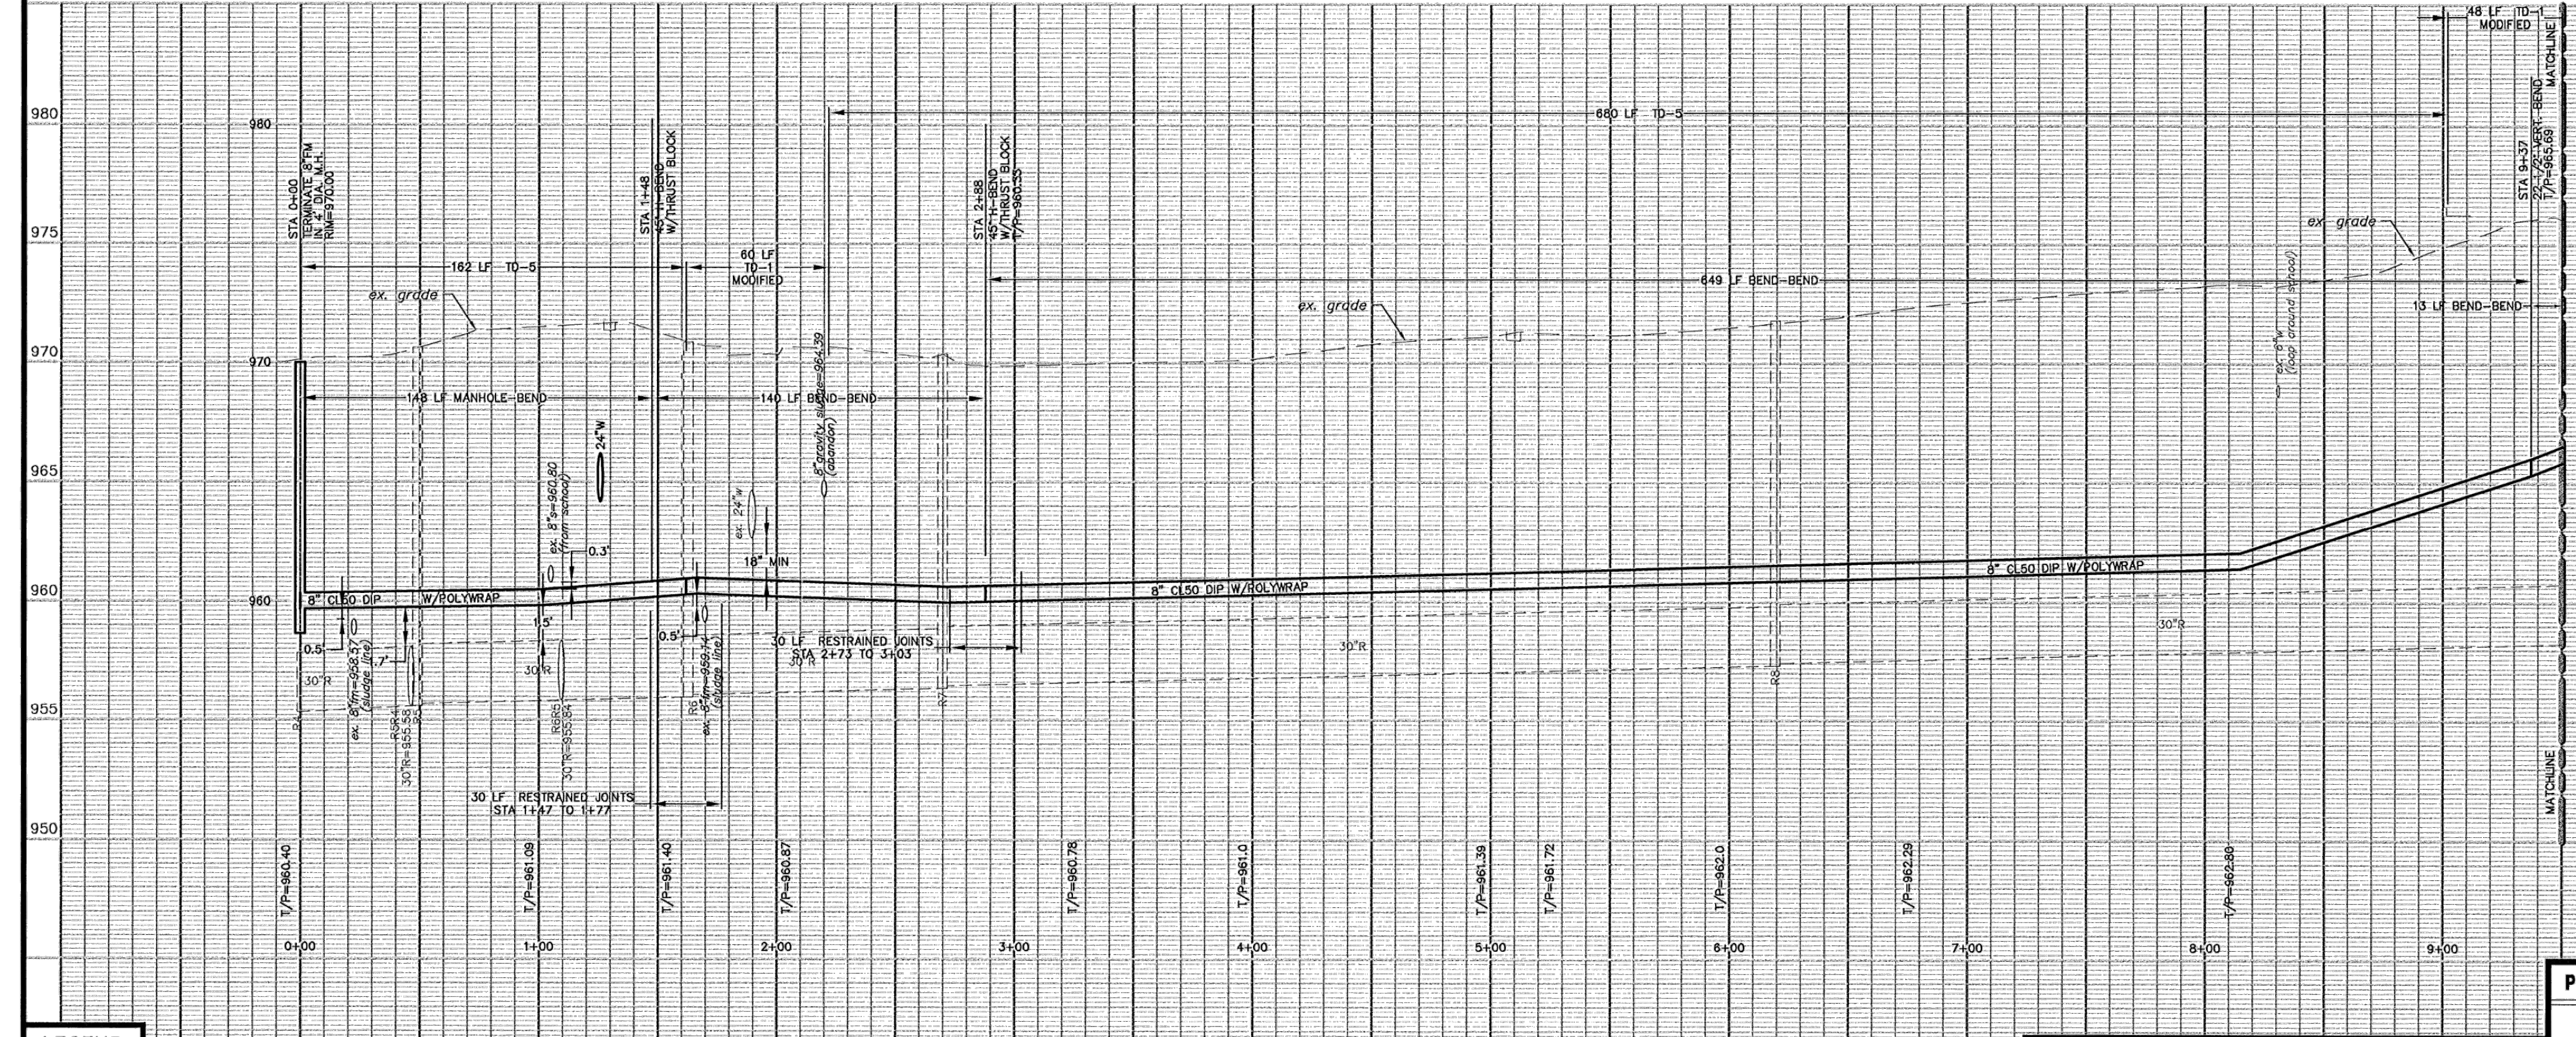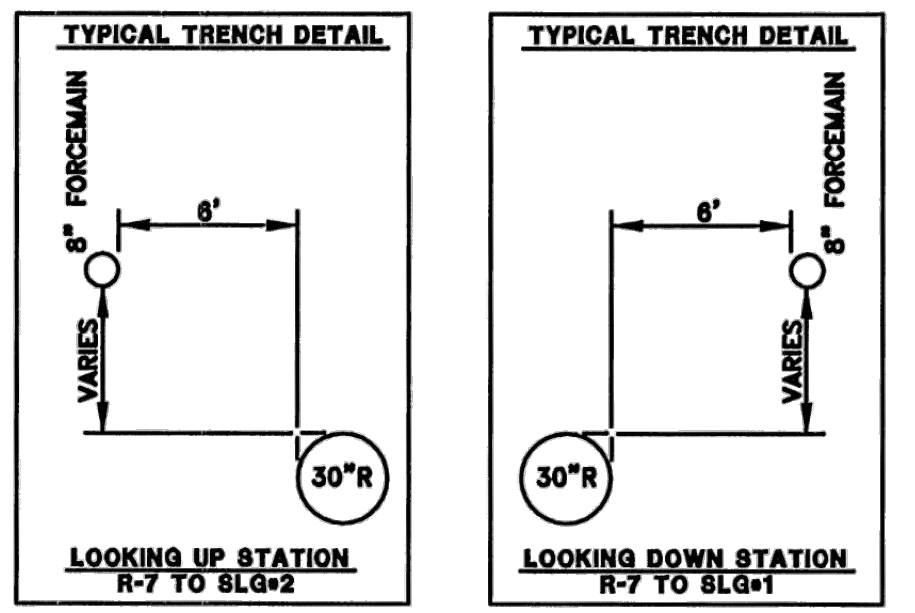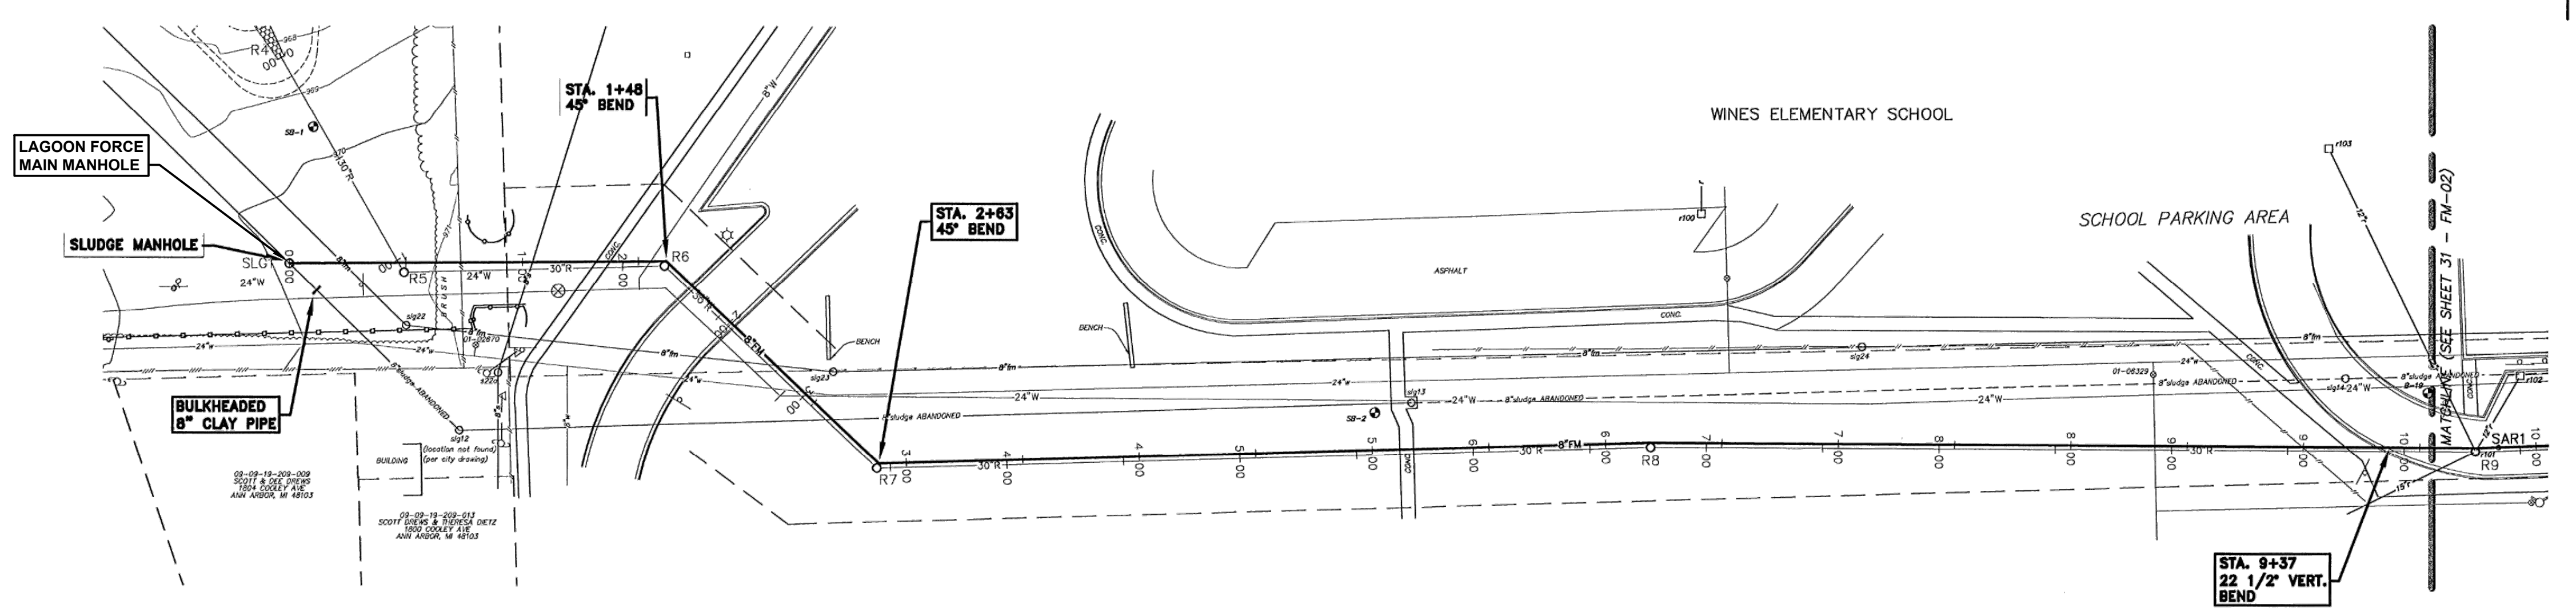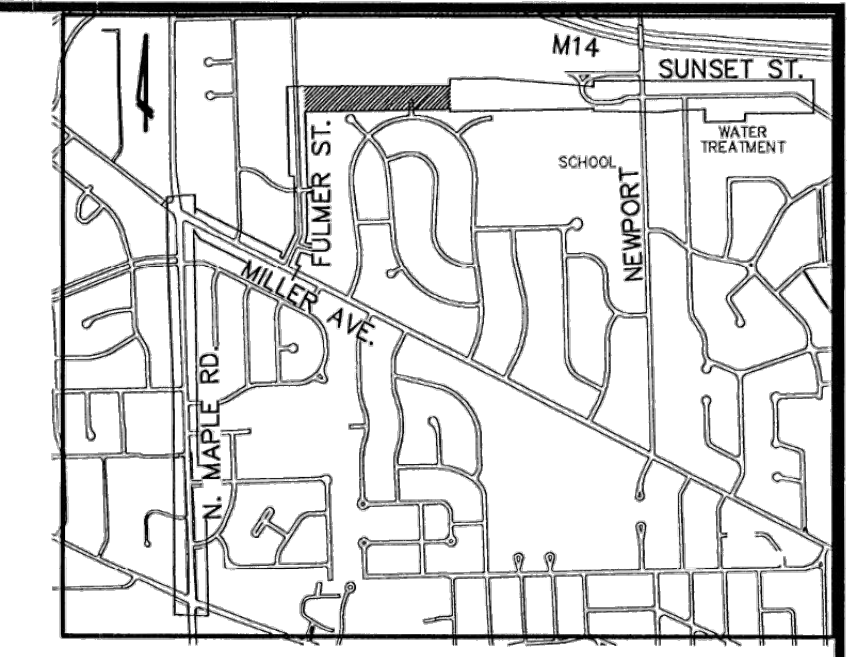

LEGEND EXISTING FENCE: CONTOUR (847), STORM SEWER & CAT. BAS., WATER MAIN & VALVE-IN-WELL, WATER MAIN & VALVE-IN-BOX. EXISTING SANITARY SEWER & MANHOLE: UTILITY POLE & GUY, FIRE HYDRANT ASSEMBLY, LIGHT POLE, END SECTION. EXISTING TELEPHONE: GAS LINE, CABLE T.V., ELECTRIC. EXISTING RD. & GRADE: LEFT EDGE/RD. GRADE, RIGHT EDGE/RD. GRADE, CURB & GUTTER. NEW SANITARY SEWER & MANHOLE: STORM SEWER & CAT. BAS., WATER MAIN W/F.H. ASSEM., CONTOUR, ROAD & GRADE. NEW CURB & GUTTER: LANDMARK TREE & LABEL (BOLDER LINE THEN OTHERS). SEE ABOVE BOOK SURVEY BOOK BENCH MARK.		PROJECT MANAGEMENT - PUBLIC SERVICES DEPARTMENT - CITY OF ANN ARBOR MILLER/MAPLE WATER MAIN FORCEMAIN PLAN & PROFILE OFF-ROAD STA 00+00 TO 9+00 CONSULTANT: WASHTENAW ENGINEERING COMPANY	SCALE: 1" = 40' DRAWING NO. 2004041-W13 FILE NO. 2004-041 SHEET NO. 31 OF 41
---	--	---	---

REV. NO.	DESCRIPTION	DATE	DR. BY	CH. BY
3	AS-BUILT	7-30-09	DPF	JTZ
1	CITY OF ANN ARBOR	06-24-08	JFR	SRG
1	CITY OF ANN ARBOR	12-16-07	JFR	SRG
1	ORIGINAL ISSUE	11-30-07	RKY	SRG

12/13/2018 12:24:51 PM - C:\PROJECTS\ANN ARBOR\ER131537\200-31537-17002\CAD\SHEETFILES\PJ2-C-502.DWG - NELLING, VICKIE

TETRA TECH
 www.tetra.tech.com

BY	
DATE	
DESCRIPTION	
MARK	
CITY OF ANN ARBOR, MI	
CONTRACT NO. 2 - LIME RESIDUAL REMOVAL DREDGING AND HAULING	
8 IN FM PLAN & PROFILE	
FOR INFO ONLY	
PROJ:	200-31537-17002
DESN:	J. SIWEK
DRWN:	S. GOTHA
CHKD:	B. RUBEL

C-124
 Sheet

Bar Measures 1 inch, otherwise drawing not to scale

